

Length B.P. 268'-0" Breadth Mid. 37'-8" Depth Mid. 19'-9"

Scale  $\frac{1}{8}$ " = 1 Foot.

John Crown & Sons Ltd.  
Strand Slipway,  
Sunderland.





SUNDERLAND

MESSRS J. CROWN & SONS

S/S "SPRIGHTLY" (No 142).

PROFILE (AS BUILT)

**SUNDERLAND RPT. NO.** 28560.

~~Silesia~~ Transferred to  
Kylequeen

~~Wreck Bay 158~~  
~~Section 1~~



© 2020

Lloyd's Register  
Foundation

003434-003443-0285 2/2





003434-003443-0285 2/2


003434-003443-0285 1/2

J. CROWN & SONS, LIMITED, SUNDERLAND.  
ENCLOSURE  
FOR

*Messrs  
Lloyds Surveyors.*

S.S.

003434-003443-0285 2/2

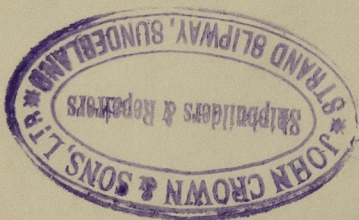

© 2010

Lloyd's Register  
Foundation



J. CROWN & SONS, LIMITED, SUNDERLAND.

ENCLOSURE  
FOR

*Messrs  
Lloyds Turneyors.*

003434-003443-0285 1/2