


17.10.22

# Profile To Class 100 A.I. At Lloyd's.

Length B.P. 268'-0" Breadth Mid. 37'-8" Depth Mid. 19'-9"

Scale 1/8" = 1 Foot.

N<sup>os</sup> 172-3 s.s.

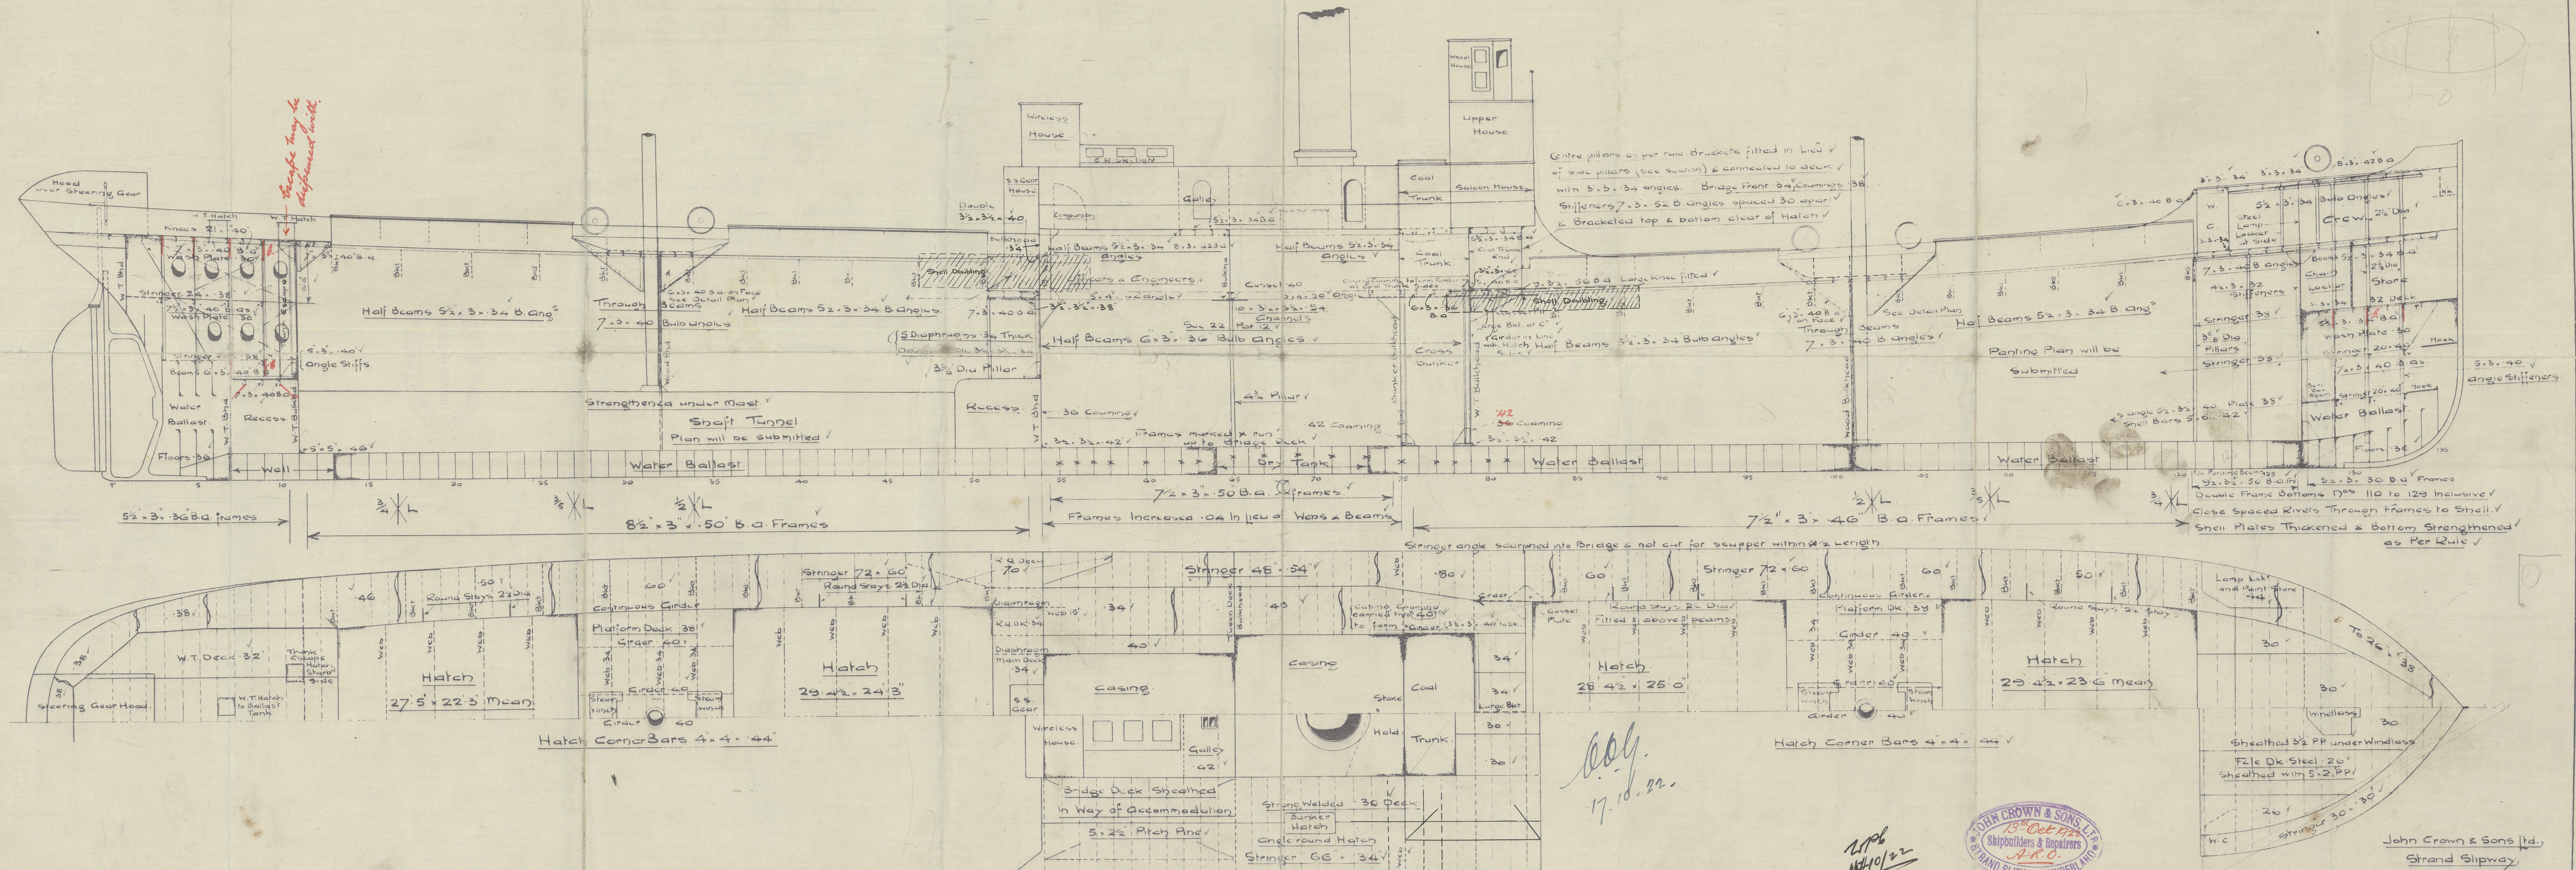


17.10.22

17/10/22




John Crown & Sons Ltd.  
Grand Slipway,  
Sunderland.

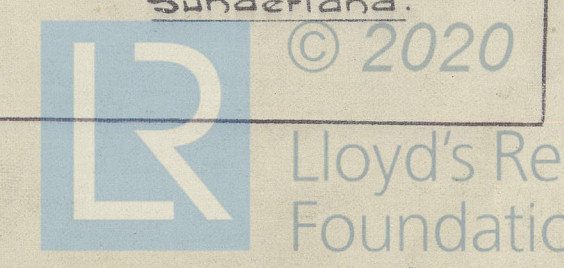

003434-003443-0288



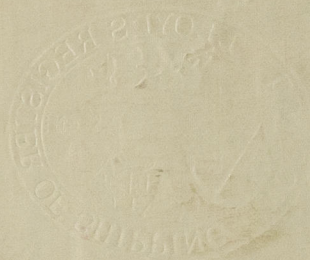

003434-003443-0288

*Manxpanay*



© 2020

Lloyd's Register  
Foundation





003434-003443-0288



© 2020

Lloyd's Register  
Foundation



Sunderland  
J Brown & Sons Ltd

No. 142-173

Profile & deck

N/N SILESIA

EX

"Sprightly" No. 172. \*

SUNDERLAND RPT. No. 28560.

"Speedfast" No. 173.

SUNDERLAND RPT. No. 28445


Week Bay 158  
Section 1

Transferred to

Kylequeen

Similar vessel to

Silesia

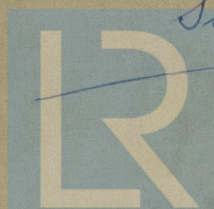

© 2020

Lloyd's Register  
Foundation

003434-003443-0288