

66 77
5/5 KYLOE


PROPOSED CONVERSION of CROSS BUNKER for CARRIAGE

The requirements of D2028 of the Rules
to be complied with where applicable

NOTE: OIL FUEL TANKS CARRIED UP
TO UPPER DECK & 1 GIRDER
ONLY FITTED

OIL FUEL

Scale $\frac{1}{4}'' = 1$ Foot

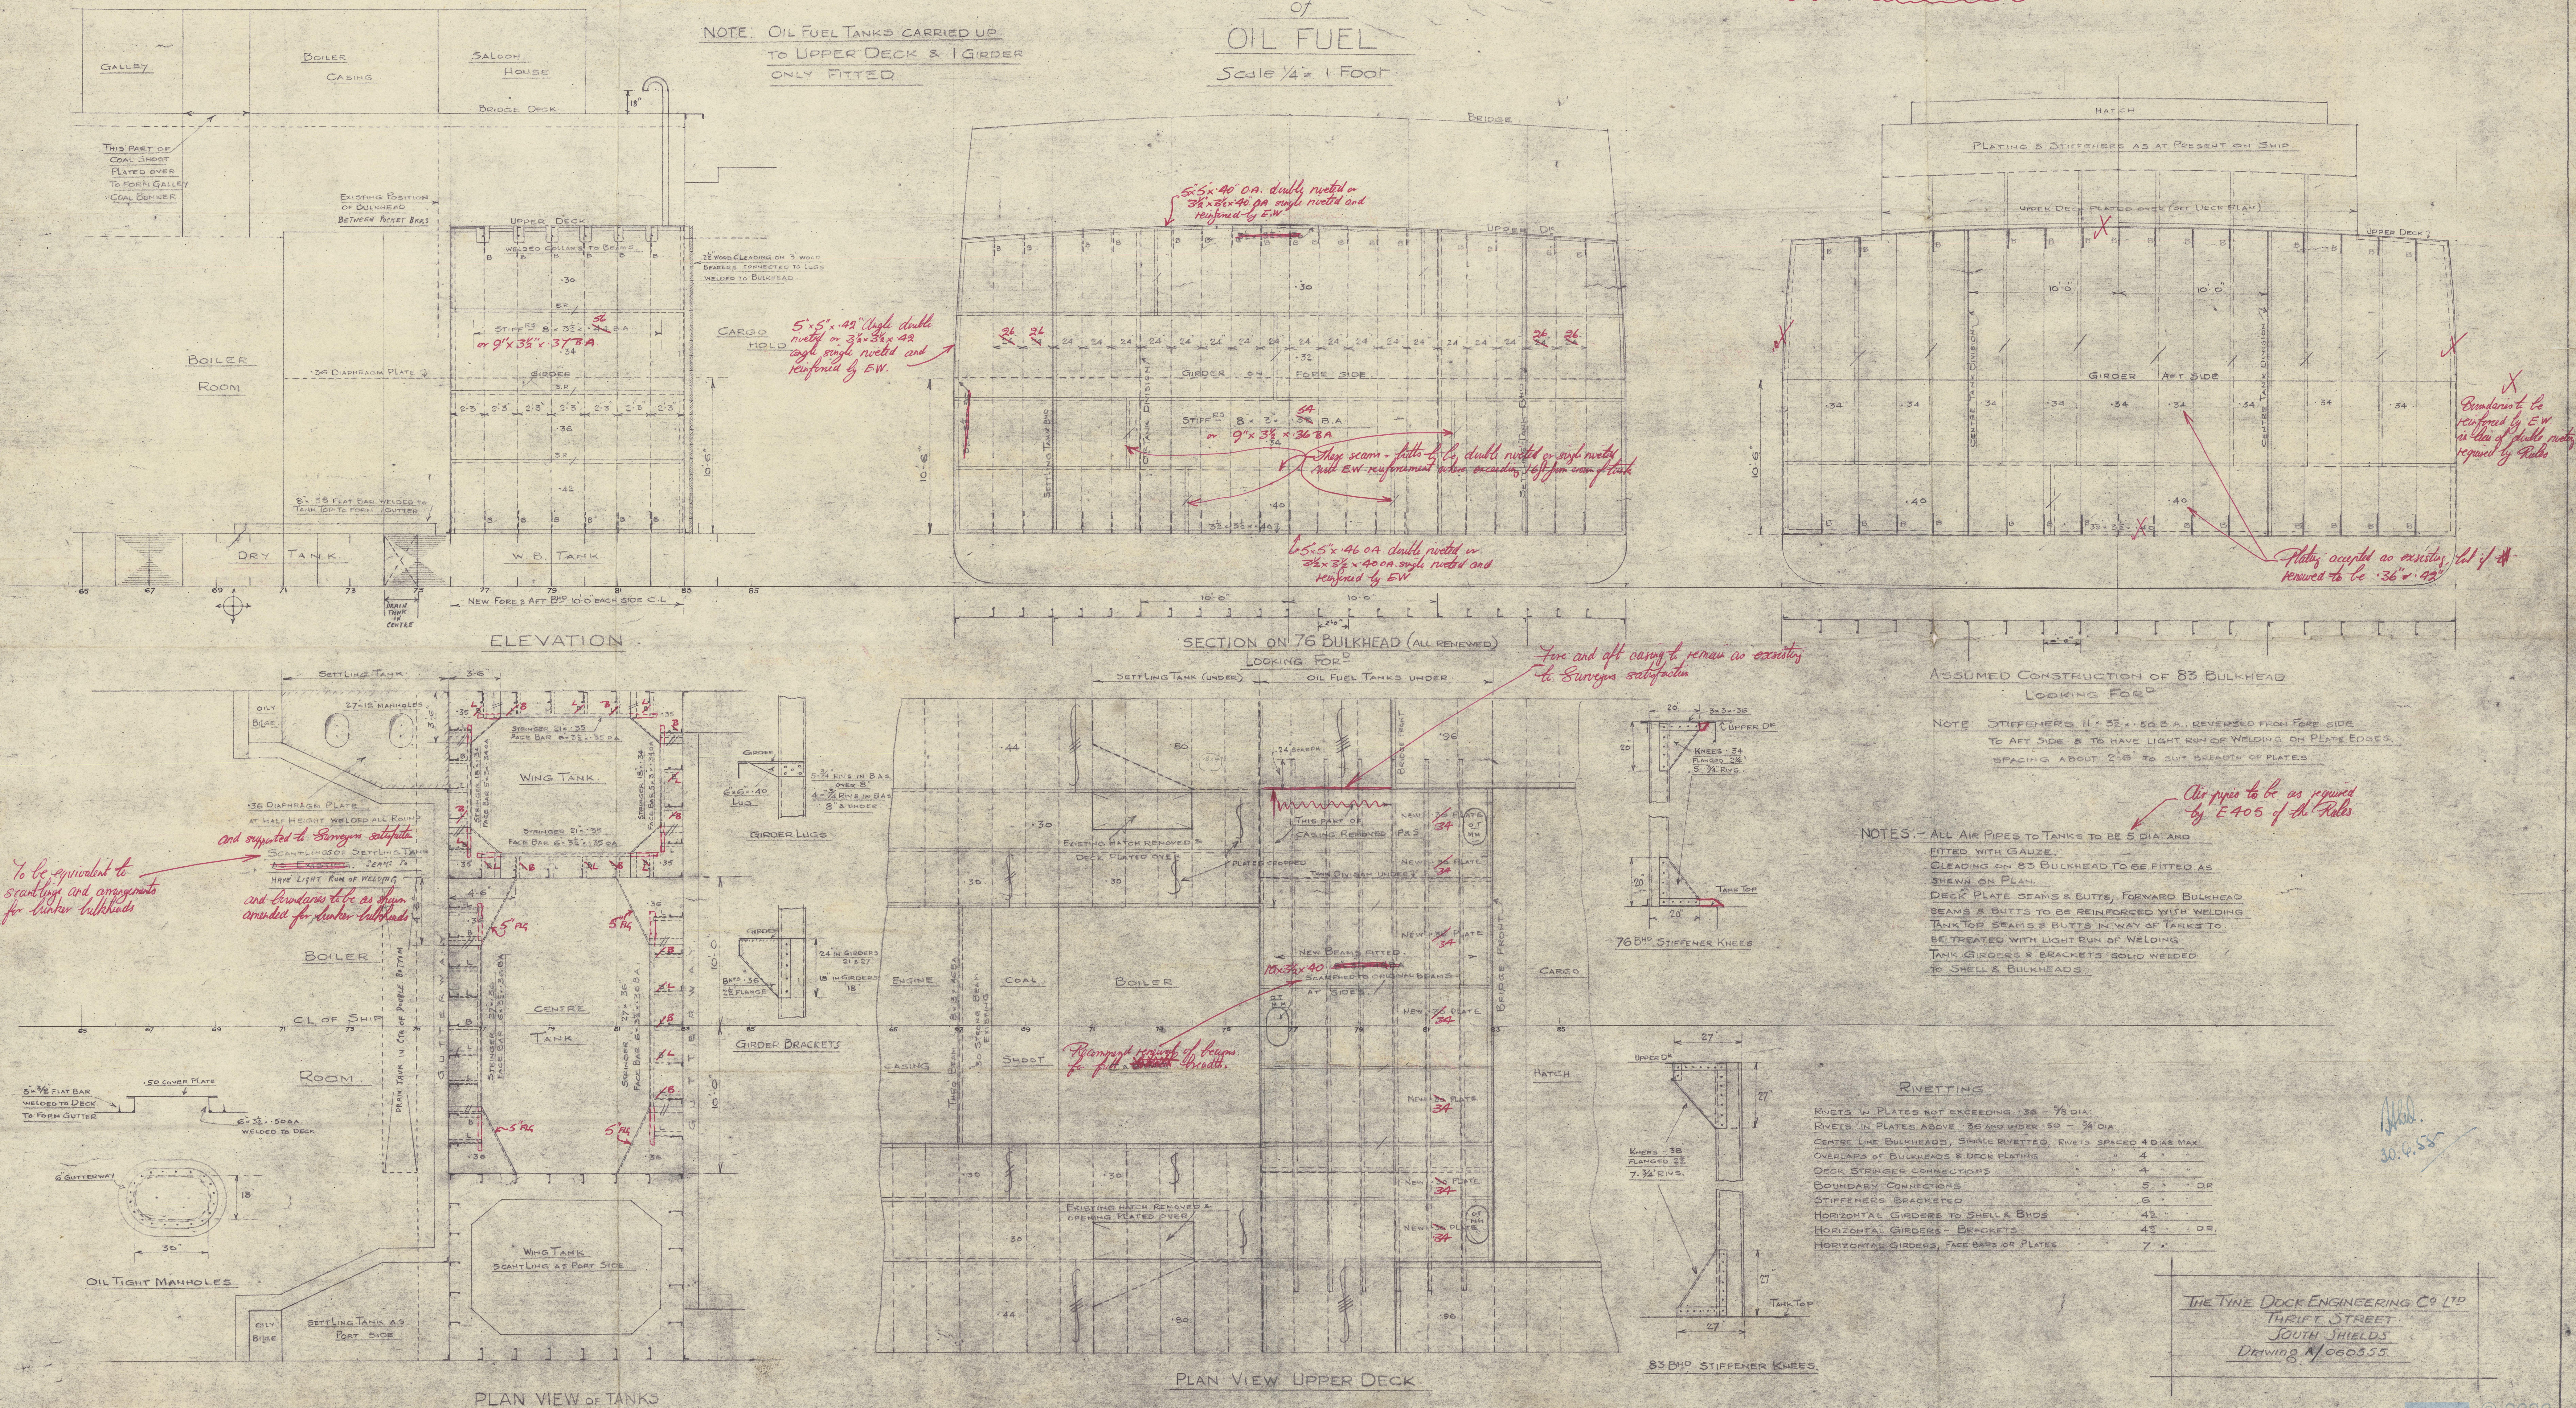

THE TYNE DOCK ENGINEERING CO LTD
THRIFT STREET
SOUTH SHIELDS
Drawing A/060555

" KYLOE "

PROPOSED CONVERSION OF CROSS
BUNKER FOR THE CARRIAGE OF
OIL FUEL.

11/6/55.

NEWCASTLE-ON-TYNE, No. 113553.



© 2020

Lloyd's Register
Foundation

003434-003443-0329