


"S S N^o 74."

PRINCIPAL DIMENSIONS 332'-0" x 48'-0" x 14'-7 1/2"

SCALE 1/100 OF FULL SIZE.

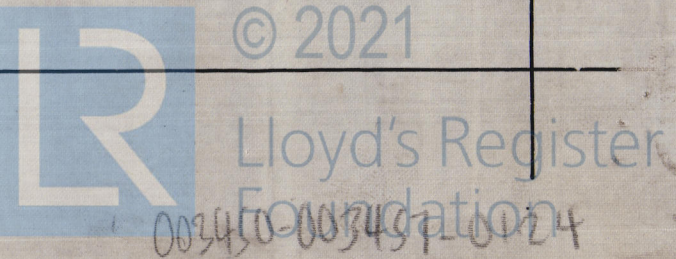

ANTWERP ENG^R CO.
N^O 74.
PROFILE AS BUILT.

5/8. "Winsum"

Ant 11502.

RETAIN



© 2021

Lloyd's Register
Foundation