


Lloyd's Register of Shipping.

Ship's Name SALAMANDARI.Official No. 174200

Memorandum of alterations reported since ship was surveyed for assignment of Load Lines in July, 1948.

"Permanent guard rails have now been fitted in place of original guard chains abreast the after masthouse on the foreboard deck Port + Starboard.

Portable section of guard rails has stanchions (2) approximately 50" apart."

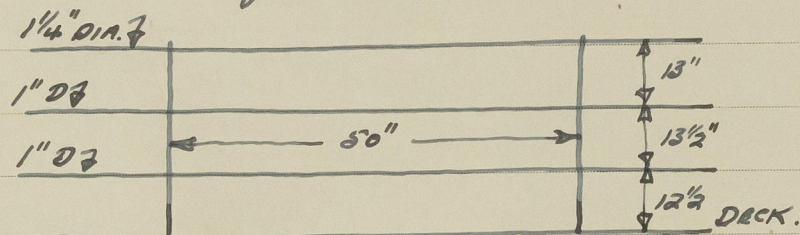

Extract from Calcutta Rpt. 8. dated 11.11.48.

Signed A. McDougall
(Acting Surveyor to L.R. of Shipping).

[Signature]
27 JAN 1949



© 2021

Lloyd's Register
Foundation