


Lloyd's Register of Shipping.

4 JAN 1949


Ship's Name S S. JALAMANJARI Ex SEA KING. Official No. 174200

Memorandum of alterations reported since ship was surveyed for assignment of Load Lines in \_\_\_\_\_

*Permanent guard rails have been fitted in place of original guard chains, abreast of the after messhouse on the foreboard deck Port and Starboard.*

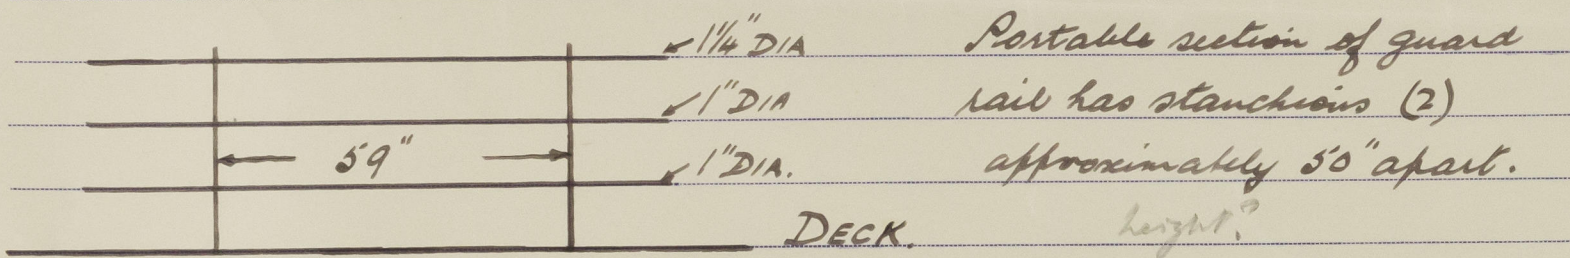

*Noted*  
4 JAN 1949

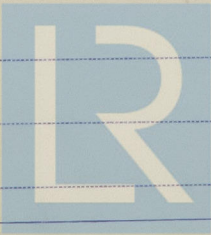

© 2021  
Lloyd's Register  
Foundation