
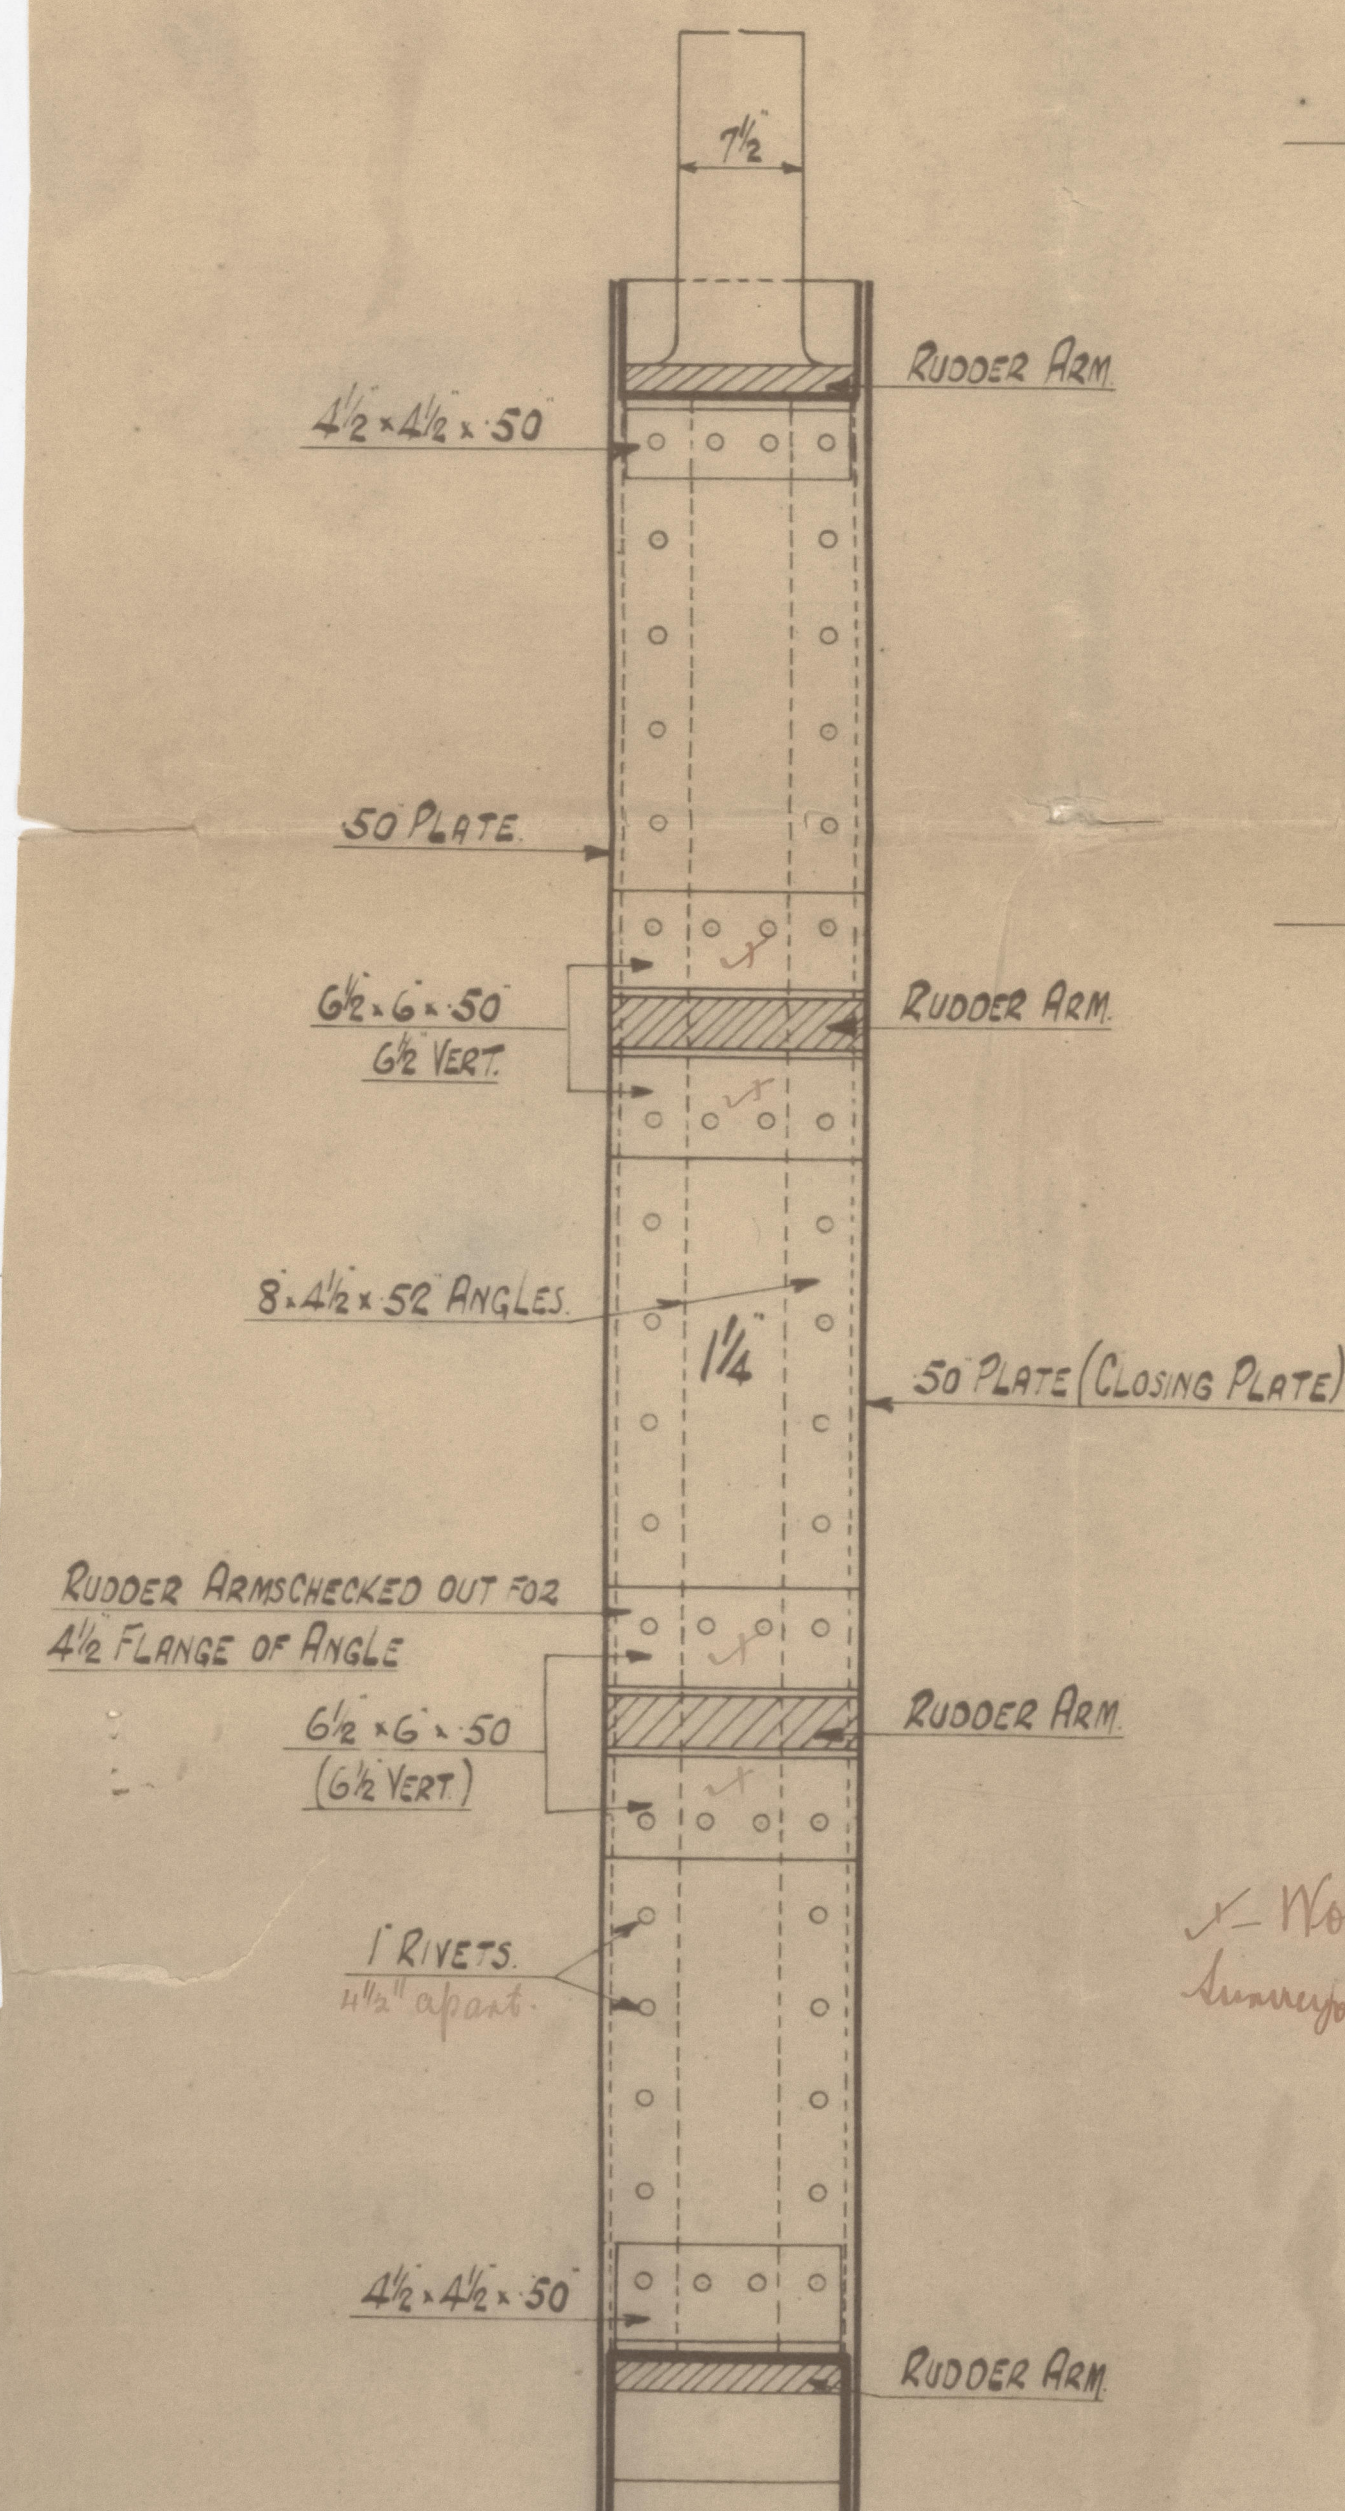
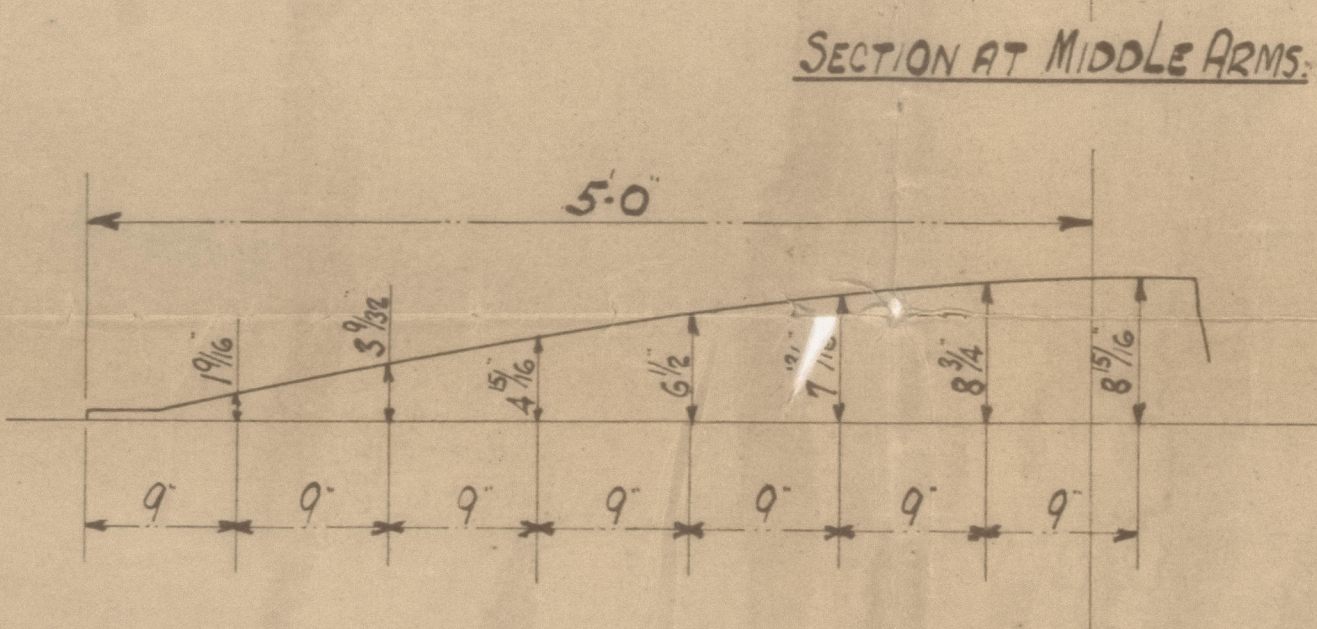
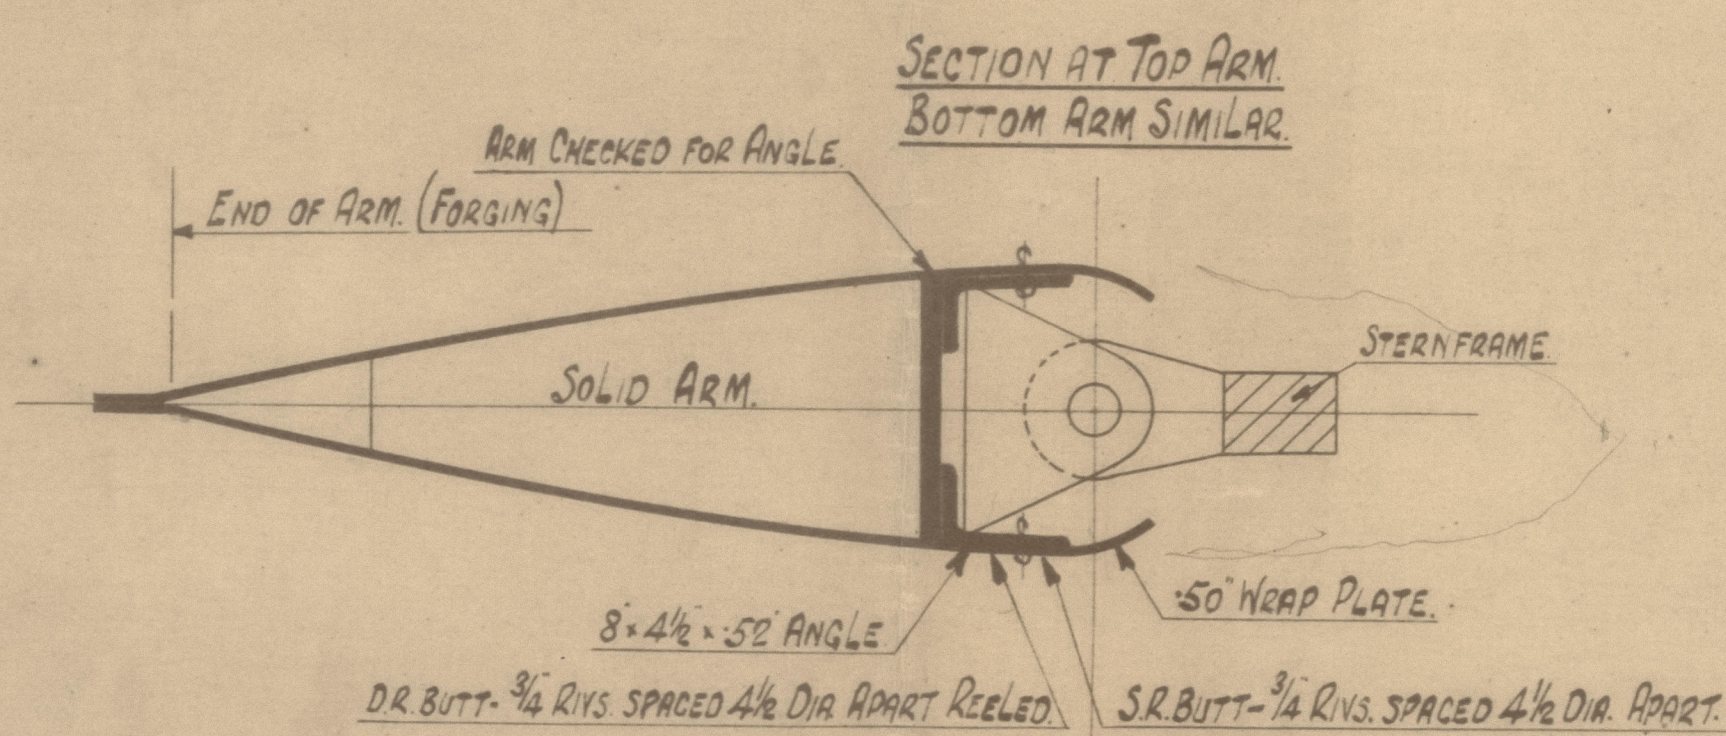


NOTE:- ALTHOUGH RUDDER ARMS ARE FORGED SEPARATELY
THE FORGE MUST ENSURE THAT THE HOLES FOR PINTLES
ARE BORED IN PERFECT ALIGNMENT.

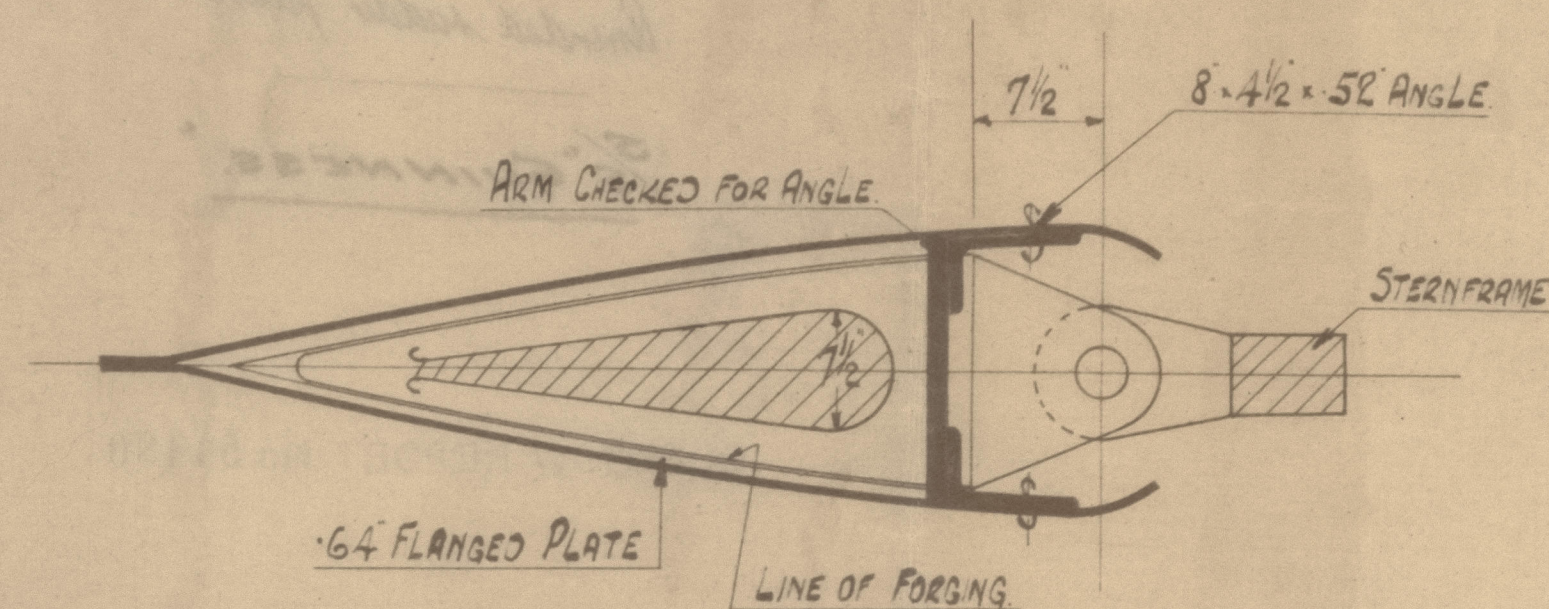

OUTLINE OF RUDDER


THESE LUGS CONNECTED TO PINS ON ARMS BY $1\frac{1}{2}$ RIVS. WHICH
ARE PUT IN FROM INSIDE RUDDER BEFORE SIDE CLOSING PLATE
IS PUT ON.

END OF ARMS FLATTENED TO FORM PALM TO TAKE RIVETS

S. S. No. 417.
RUDDER PLAN.

SCALE:- 1" = 1 FOOT.

SPEED OF SHIP 11 KNOTS.

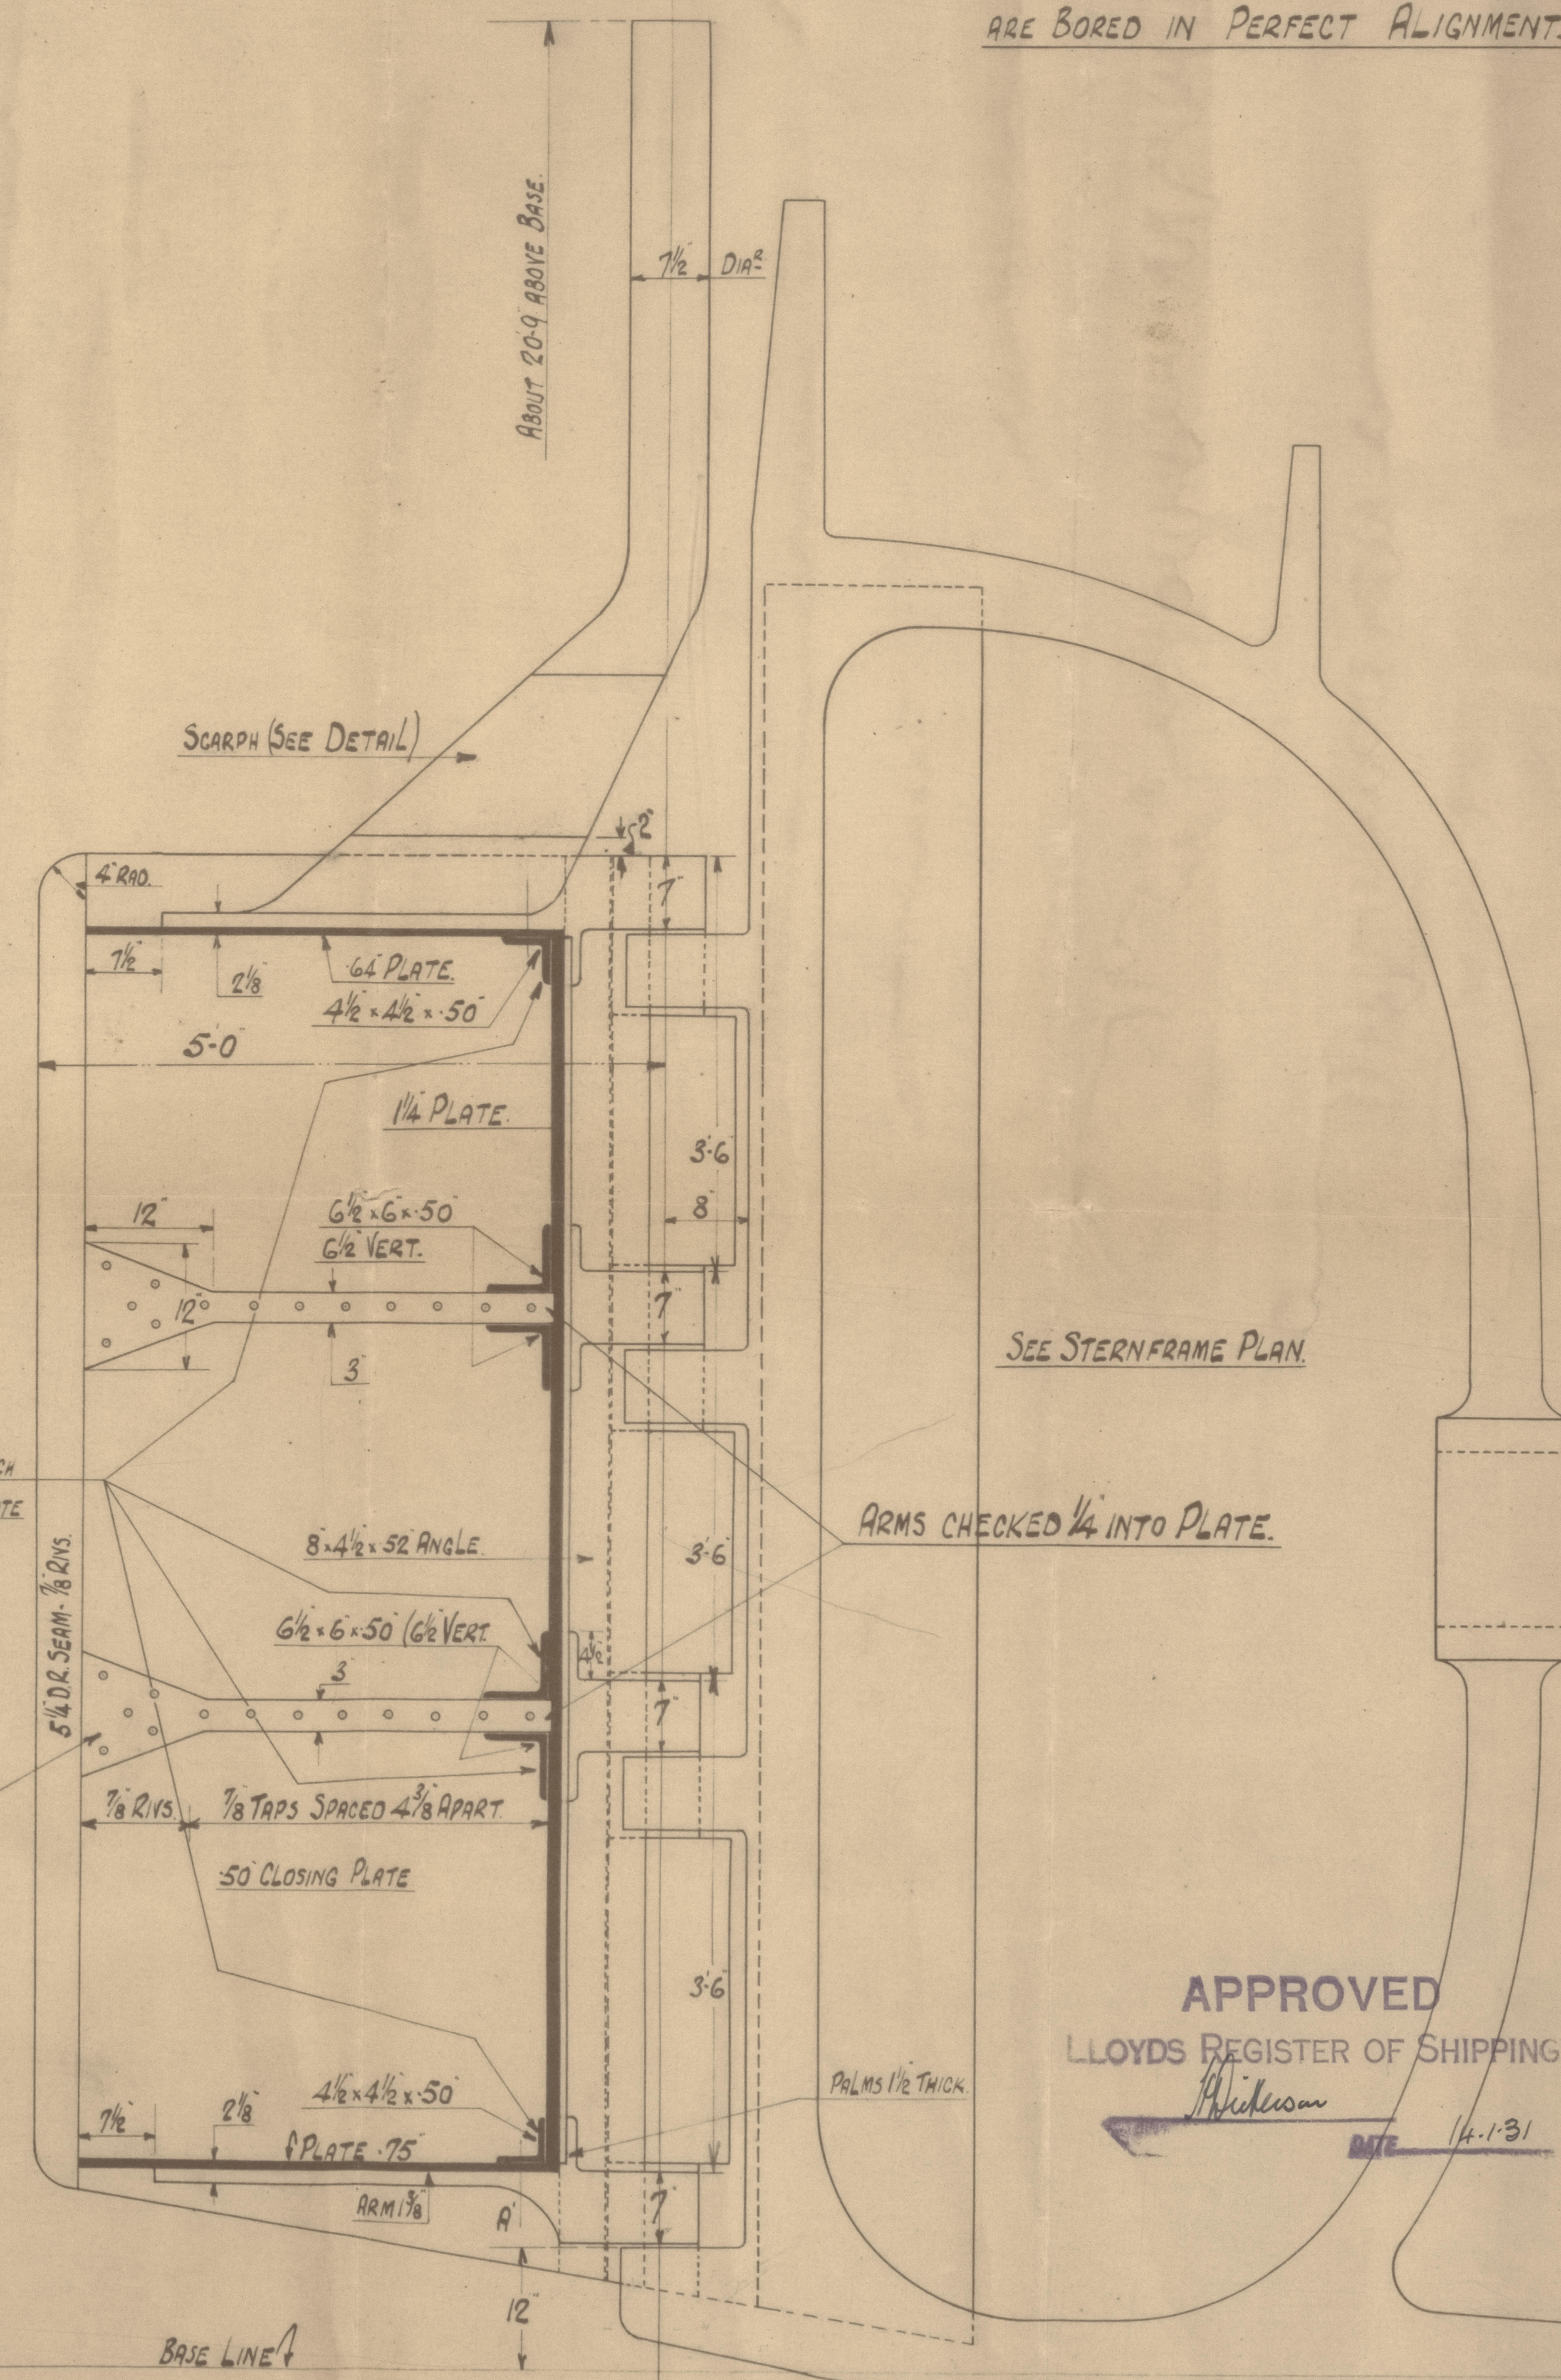


APPROVED
LLOYDS REGISTER OF SHIPPING

APPROVED

LLOYDS REGISTER OF SHIPPING

DATE 14.1.3

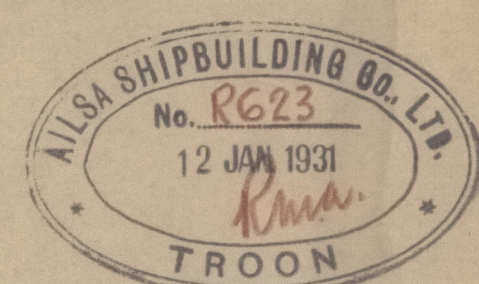



© 2021

Lloyd's Register
Foundation

Aikoa L.B. Co. Ltd

No. H14

Amended sudder plan.

5/5 "GUINNESS."

9

GLASGOW REPORT No. 51480



© 2021

Lloyd's Register
Foundation

003450-003457-0240