


DIMENSIONS :- 210'-0" B.P. x 34'-3" B.M.L.D. x 19'-0" D.M.L.D.

LOYD'S NUMERALS.

'D'	19-0
1ST LONGITUDINAL NUMBER L x D.	\$990 395.6'
2d " " " L x (B+D).	1182.5 1109.44
4D	11-05 109.96
2	16.25.

Supports under windlass winches
masts to Surgeon satisfaction

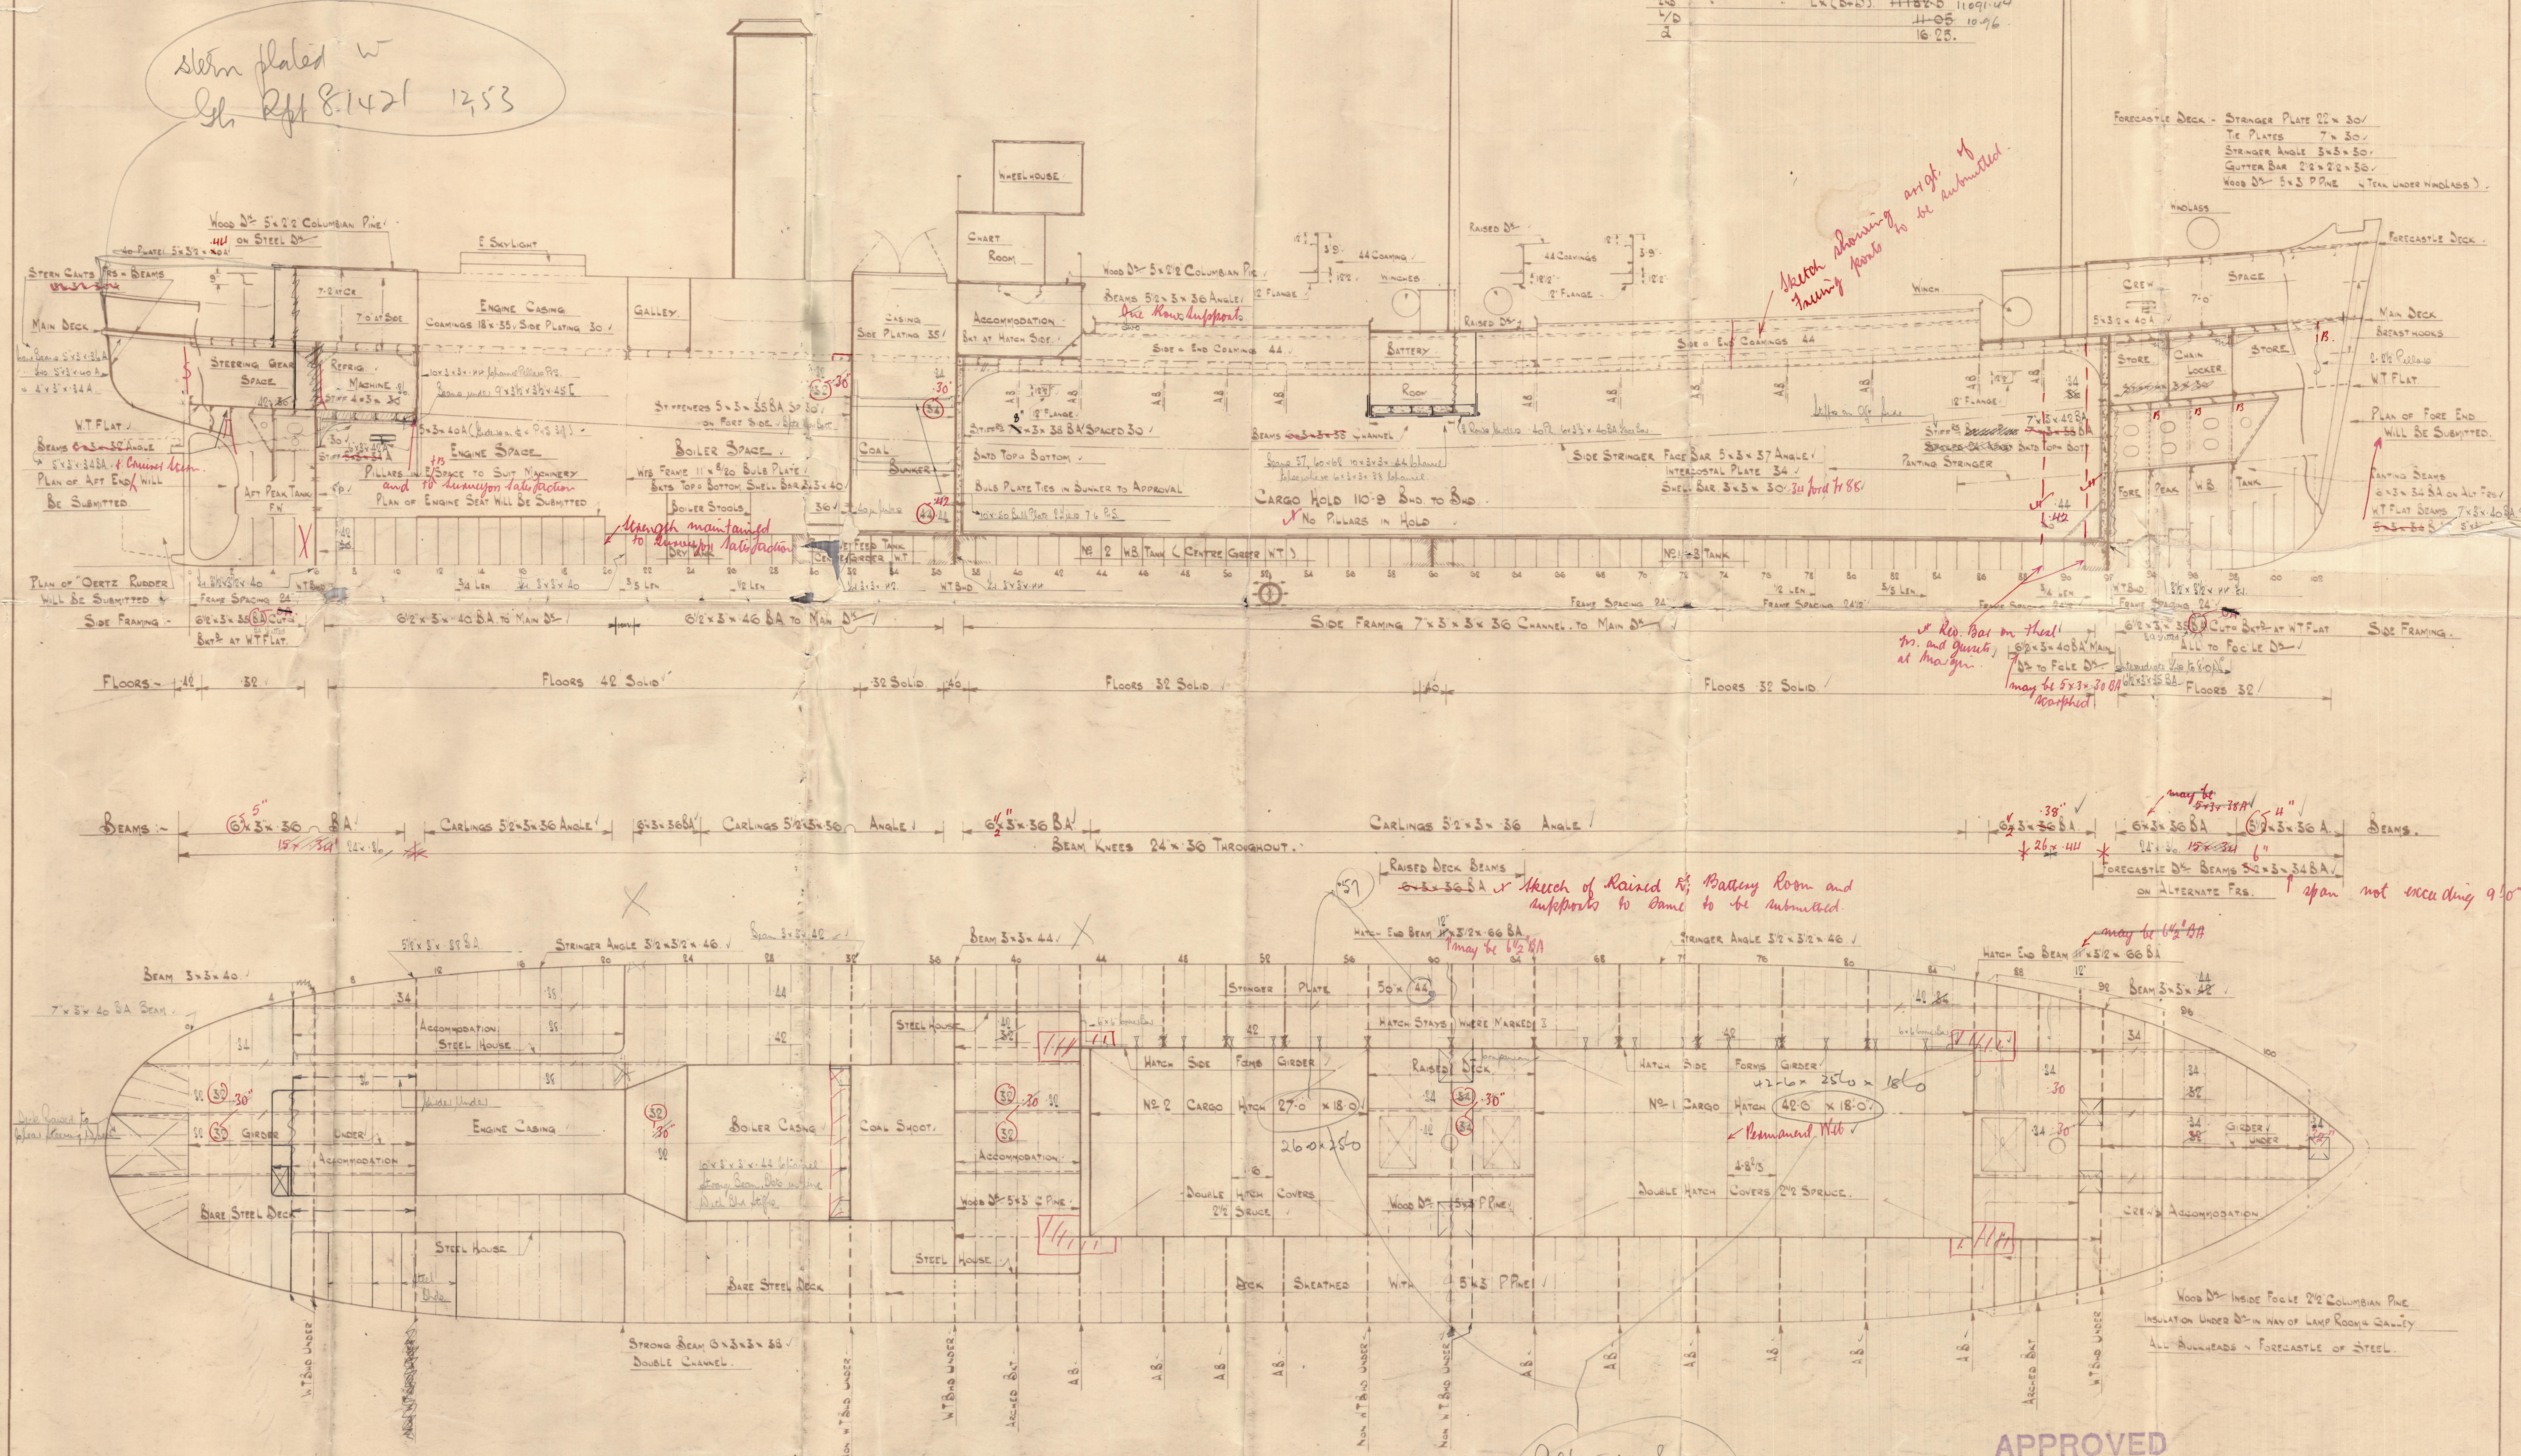

Alfred Lee
Lhs Rpt 81421
12/53

APPROVED
LLOYDS REGISTER OF SHIPPING
R. Andersen
No. 10.30



Lloyd's Register
Foundation

003450-003457-0241

The Ailsa S.B. Co.Ltd.

"GUINNESS."

No. 417.

Profile and Decks.

=====


2

Feb

GLASGOW REPORT No. 51386

GLASGOW REPORT No. 51480

REMAIN

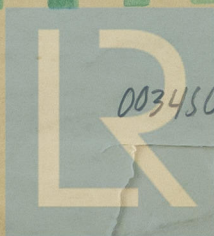

© 2021

003450-003457-0241

Lloyd's Register
Foundation