


**SS 'GUINNESS'**  
**ARRGT. of SCUPPERS & DISCHARGES.**  
**SCALE: 1/4" = 1 FT.**

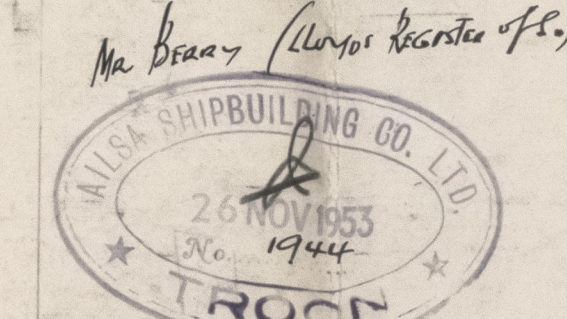




S/S. GUINNESS.

(6)

SCUPPERS. & DISCHARGES.

Rpt. NO. GLS. 81421

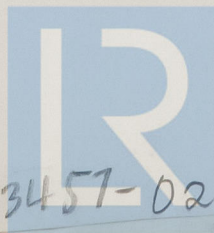

© 2021

Lloyd's Register  
Foundation

003450-003457-0268