

Attached to Kobe Rpt. No. 6065


# RECORD OF INSPECTION

No. 13

To:

DATE

MANUFACTURE No.		DATE OF INSPECTION	
ORDERER		SURVEYOR	
NAME OF WORK		CLASSIFICATION OF WORK	
DRAWING No.	ARTICLE No.	NAME OF ARTICLE	MATERIAL

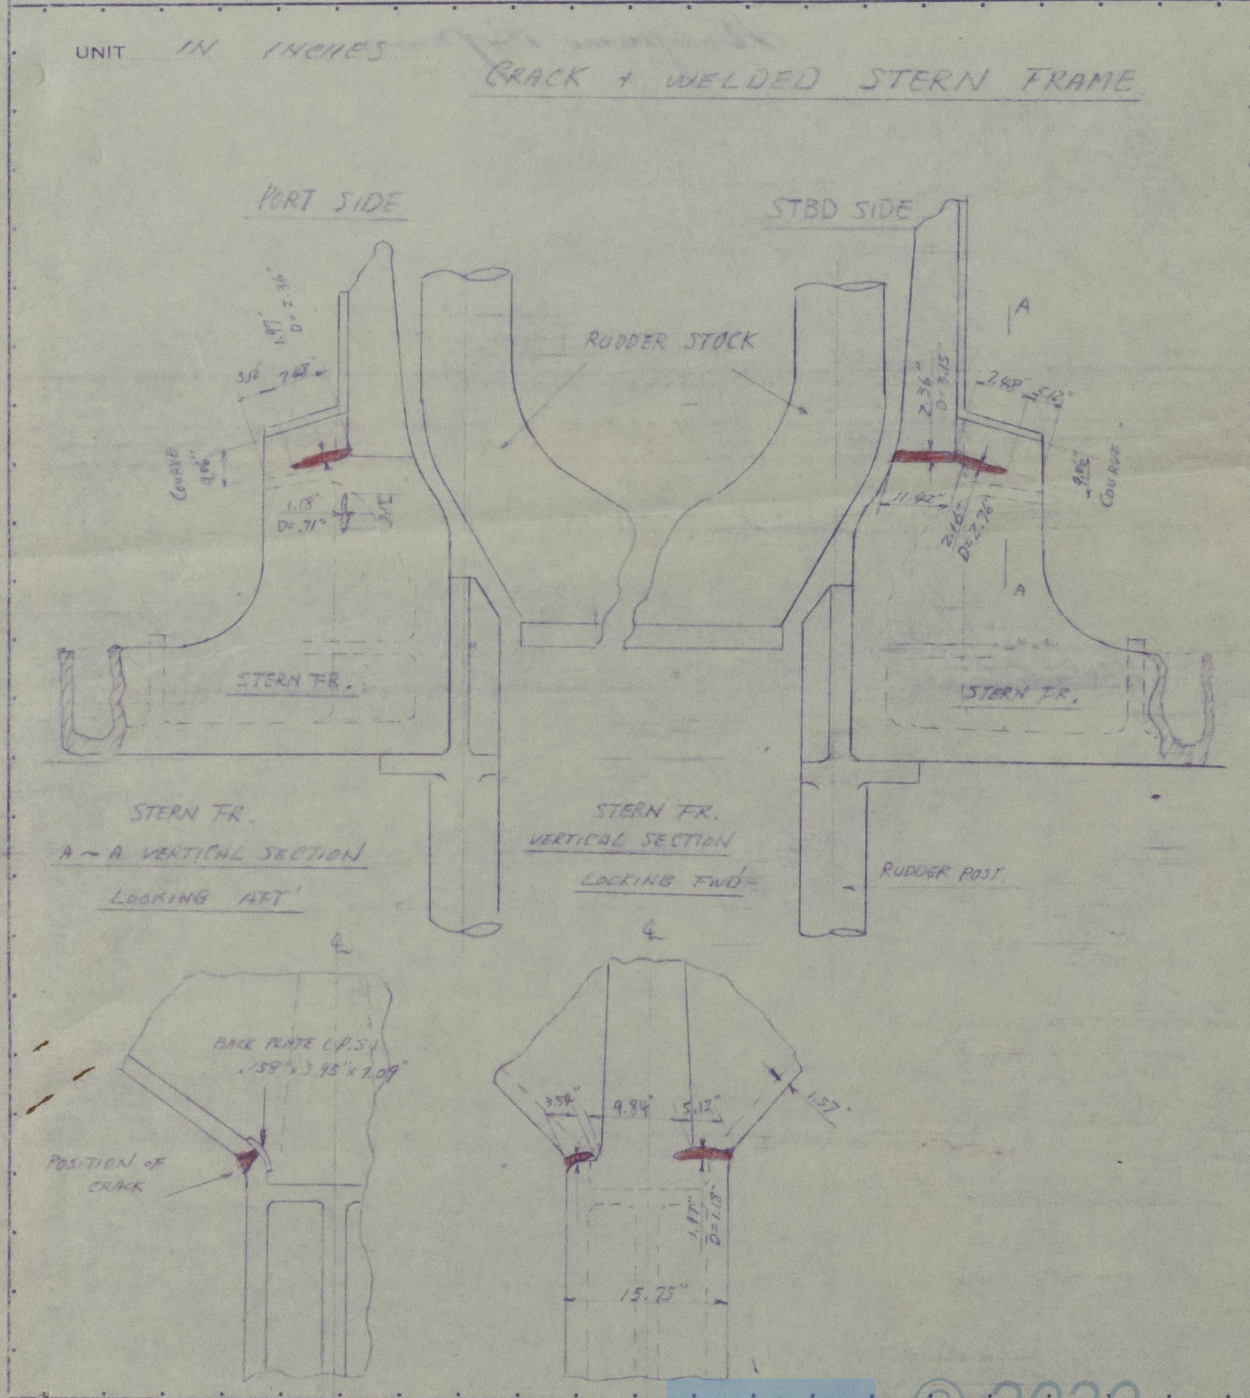

C.1001 A1 (100x200) 32.32 本 ASANO RECORD OF INSPECTION

HITACHI SHIPBUILDING & ENGINEERING CO., LTD.

CHIKKO SHIPYARD

Kobe Rpt. 8 No. 6065

CHIEF OF INSPECTION SECTION

Lloyd's Register Foundation

003458-003465-0283



MS STANVAE NAIROBI

Job.....Rpt. No. 6065

Dated.....9.58.....




© 2020

Lloyd's Register  
Foundation

003458-003465-0283