

EQUIPMENT

1. STOCKLESS ANCHOR $9\frac{3}{4}$ CWTs

1 Do. Do. $9\frac{1}{4}$ "

1 RODGERS ANCHOR $3\frac{3}{4}$ CWTs EX STOCK

135 FATIGOMS $1\frac{3}{16}$ STUD LINK CABLE

60 Do. 6" HAWSER

60 Do. $5\frac{1}{2}$ " WARP

PRINCIPAL DIM^{NS}:- 161'-9" B.P. x 27'-0" MLD. x 15'-3" D.MLD.

— SCALE $\frac{1}{2}" = 1 \text{ FOOT}$ —

LLOYDS NUMERALS

D _____ 15.25


B + D _____ 42.25

$L \times [B + D]$ _____ 6833.94

$L \times D$ _____ 2466.69

d _____ 13.75

$\frac{L}{D} = 10.606$ $\frac{L}{B} = 5.99$

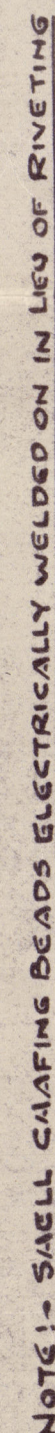

JRB. 1
8/1/31

HULL

Book Wotton & Gemmell Ltd

Yard No. 640

Midship Section

S.S. Kingslin Afate

HULL REPORT No. 48511

© 2020

RAIN

Lloyd's Register
Foundation