

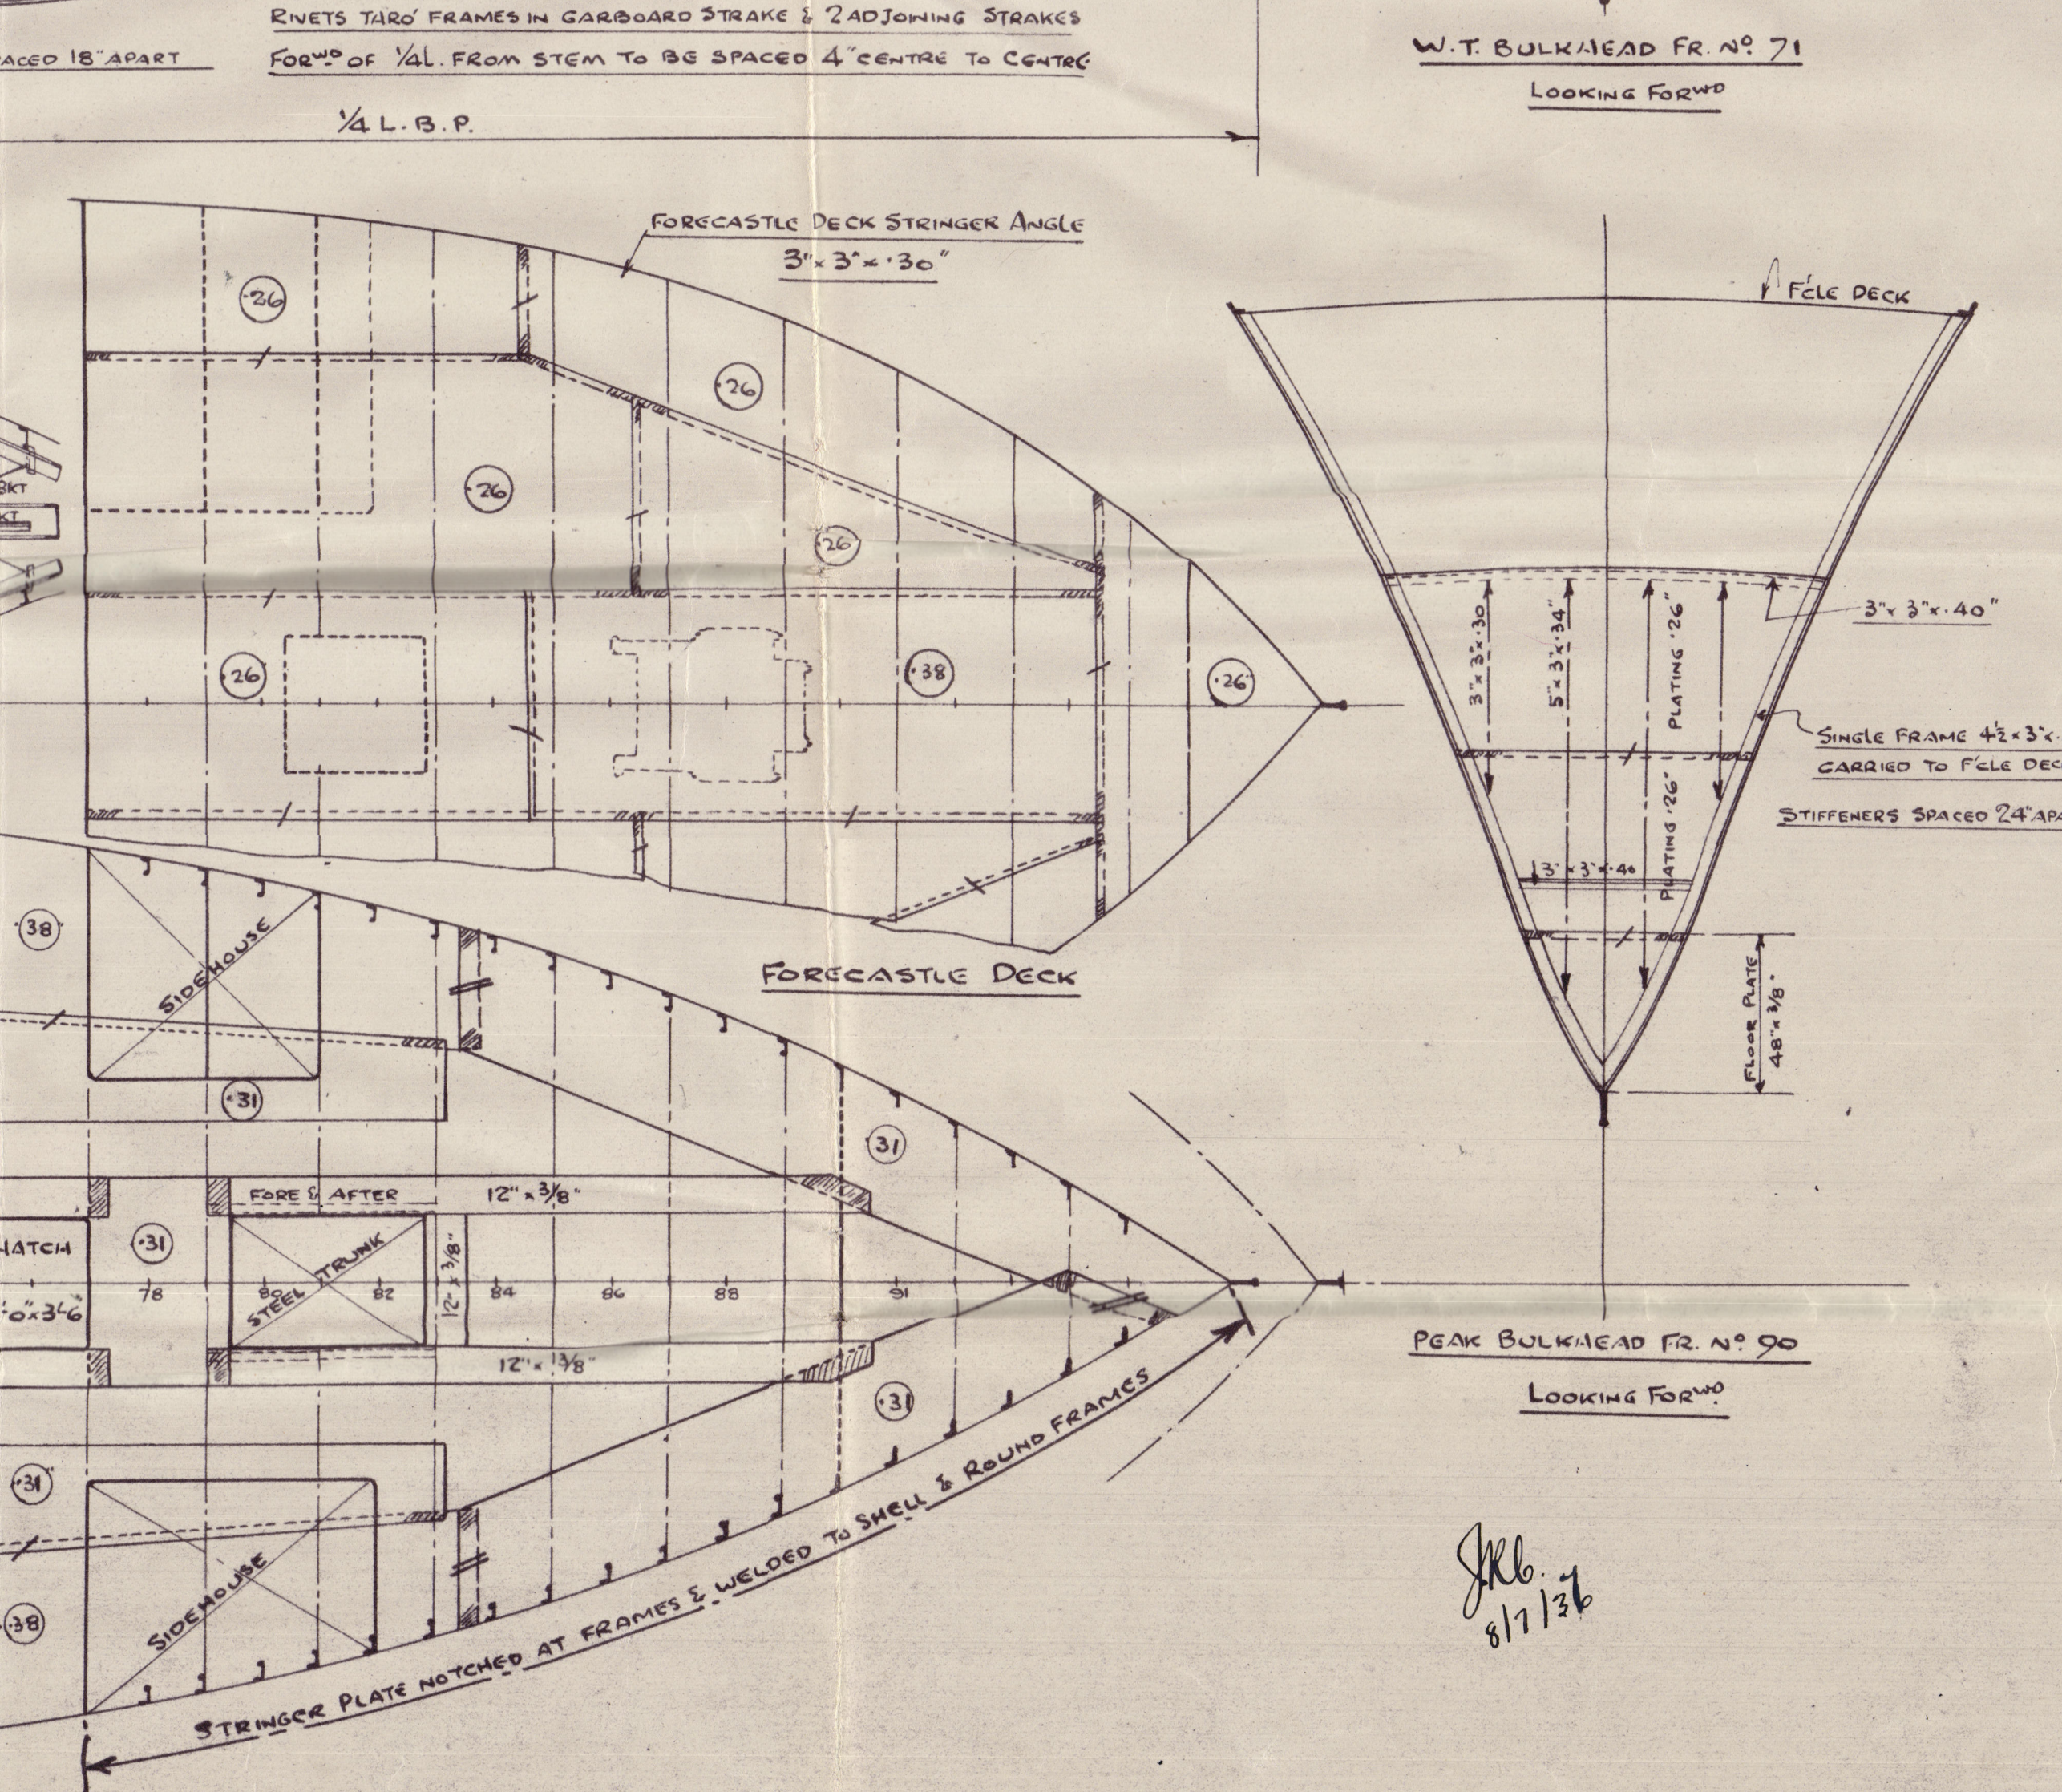
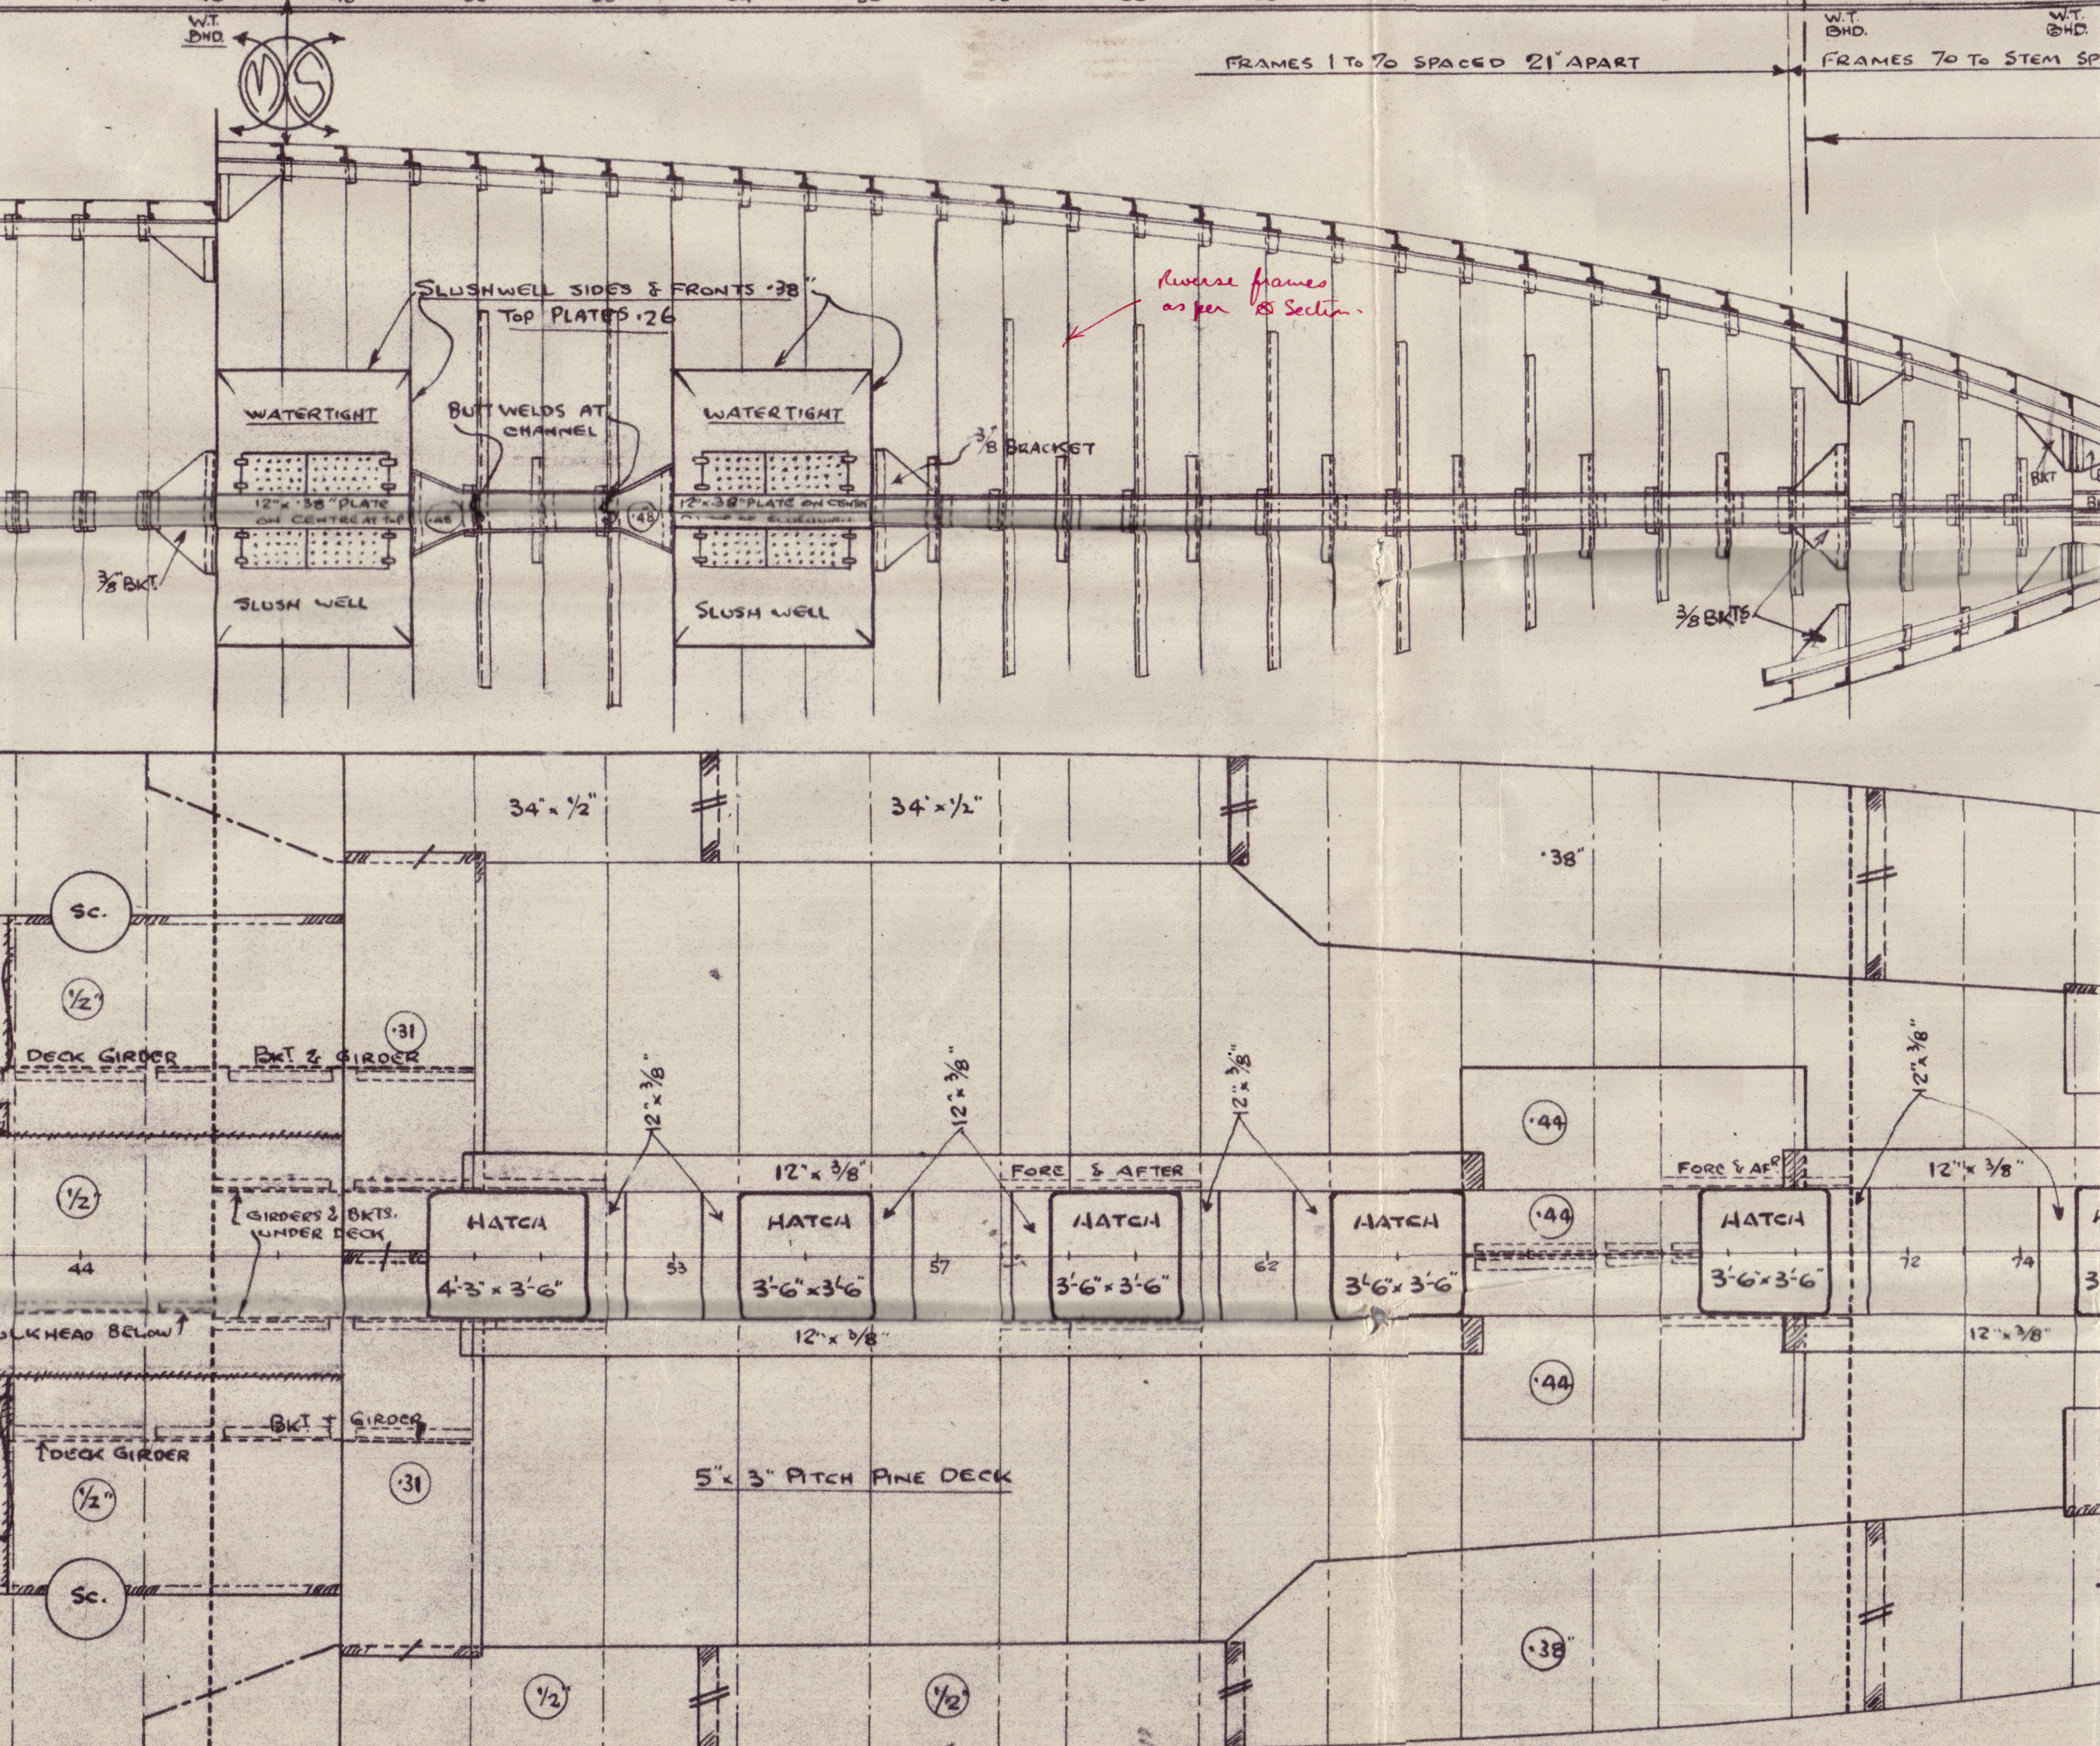
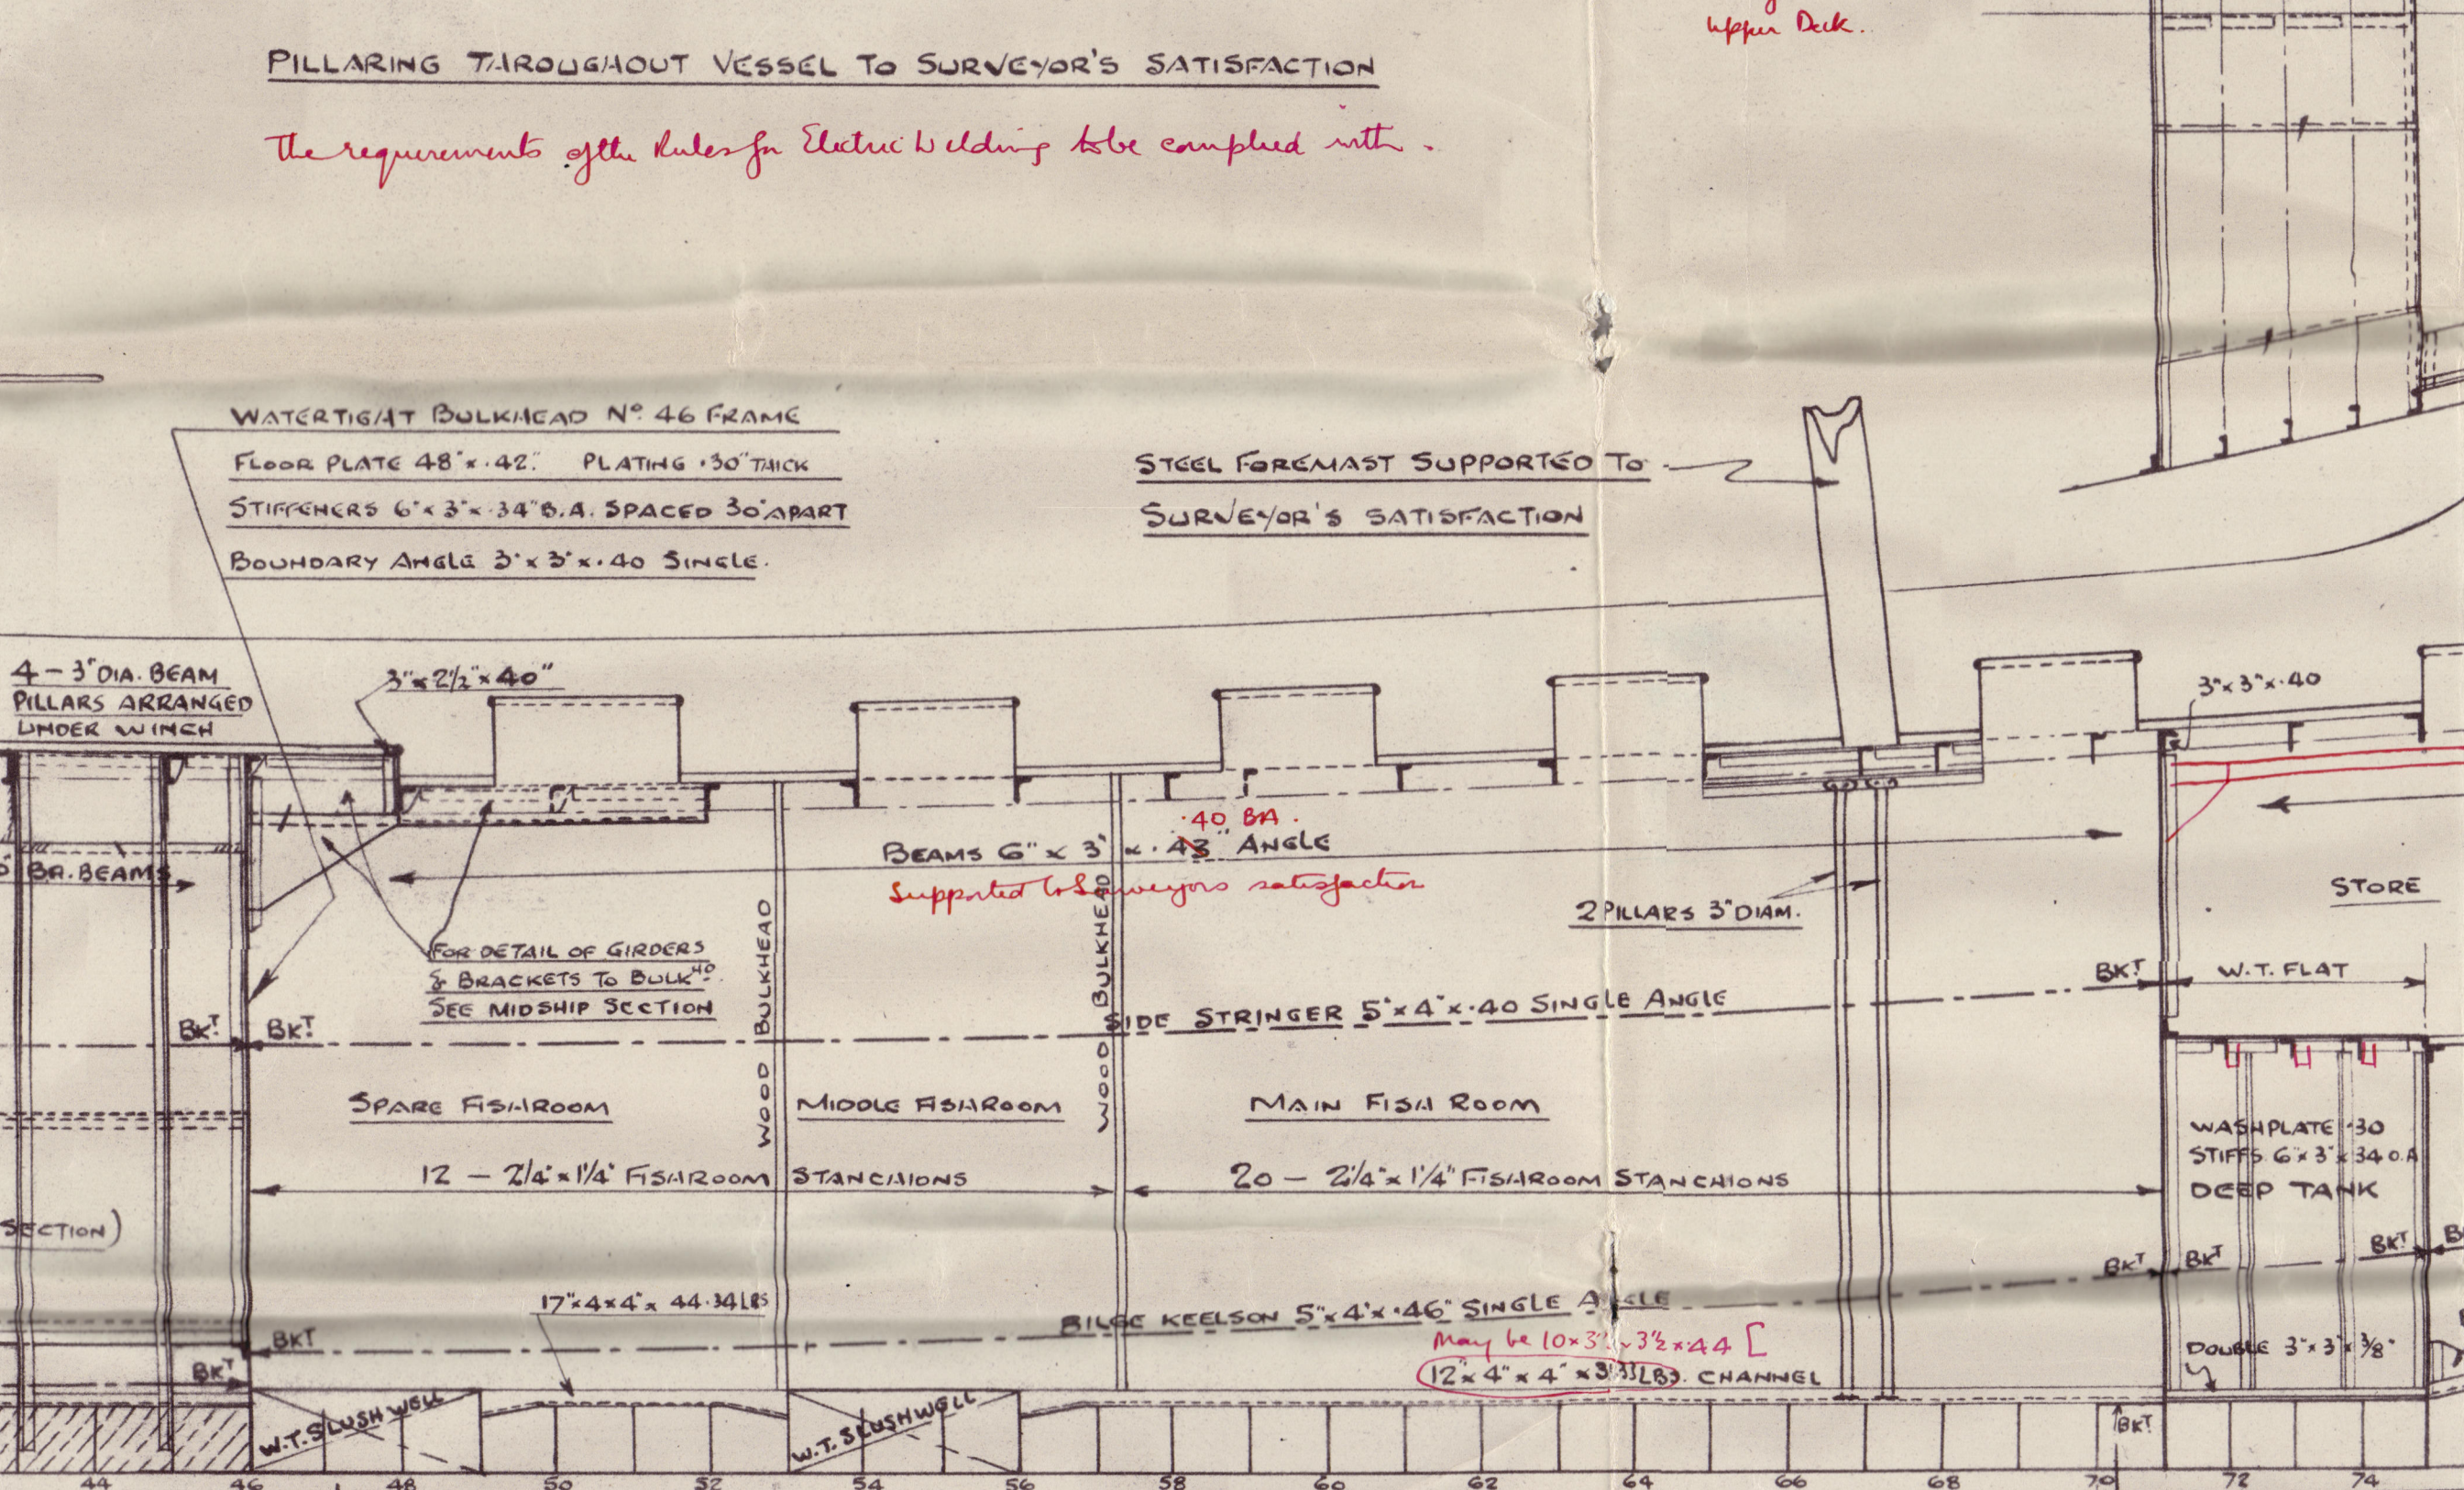
 
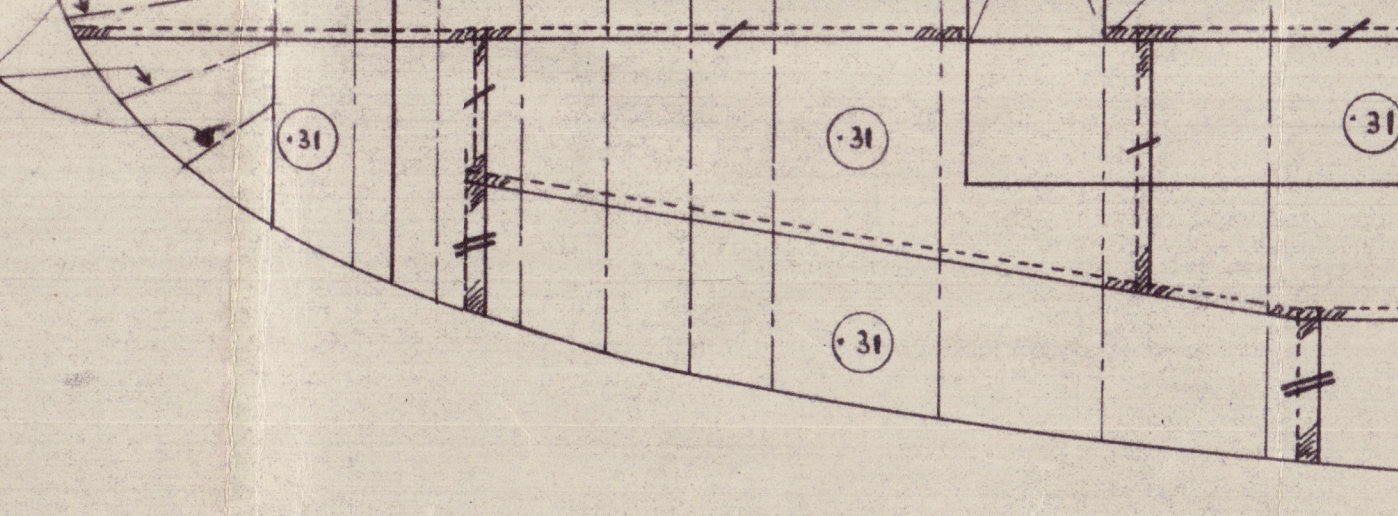
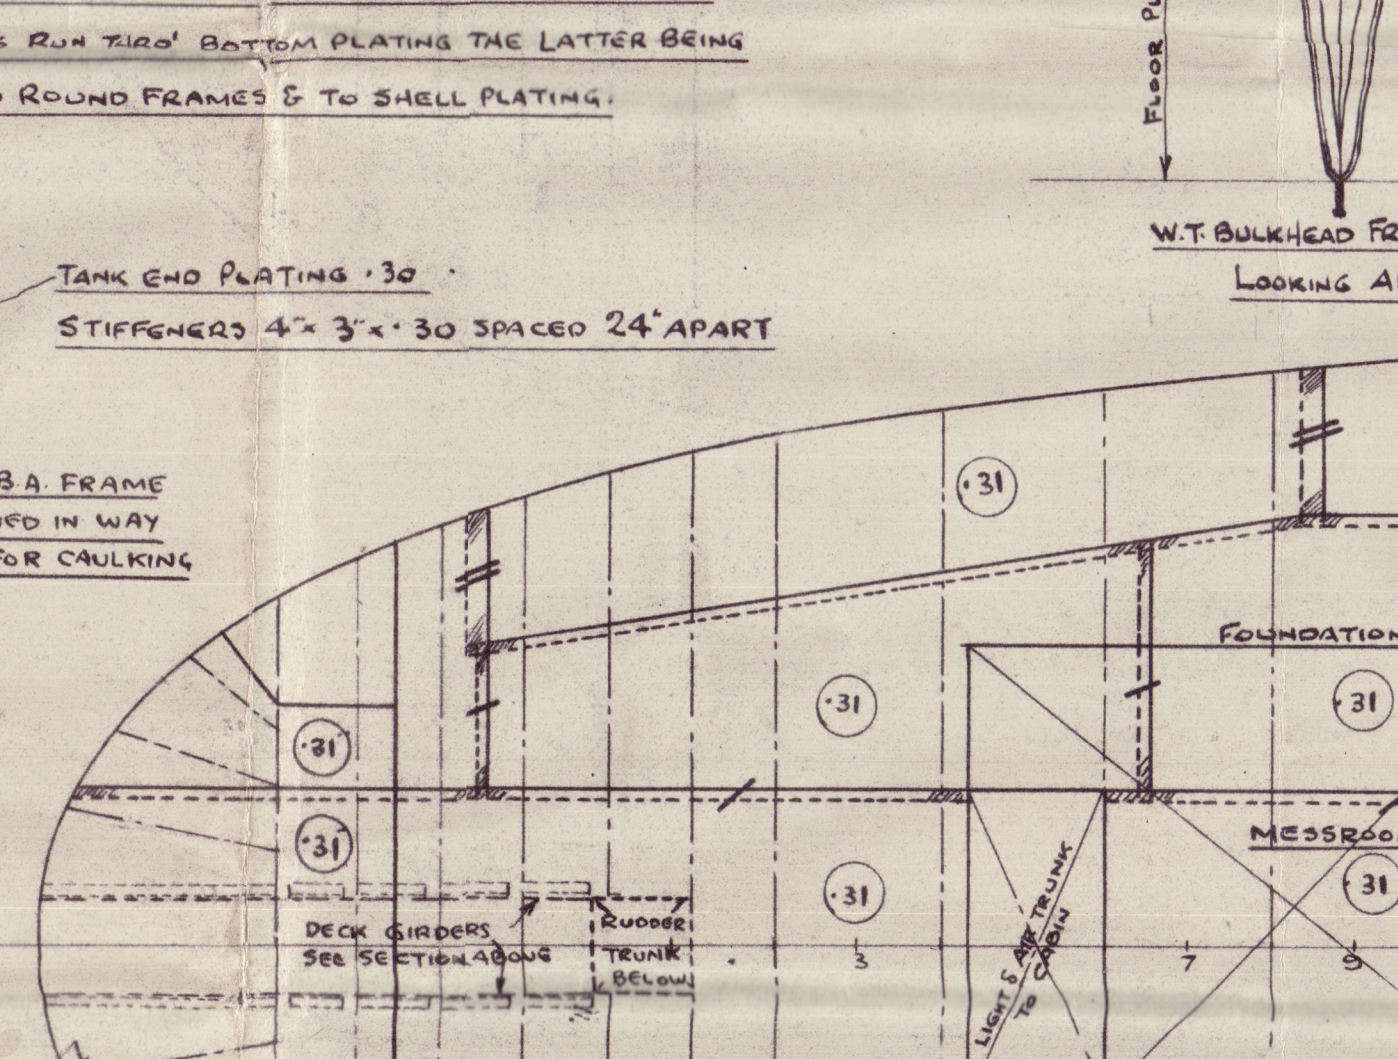
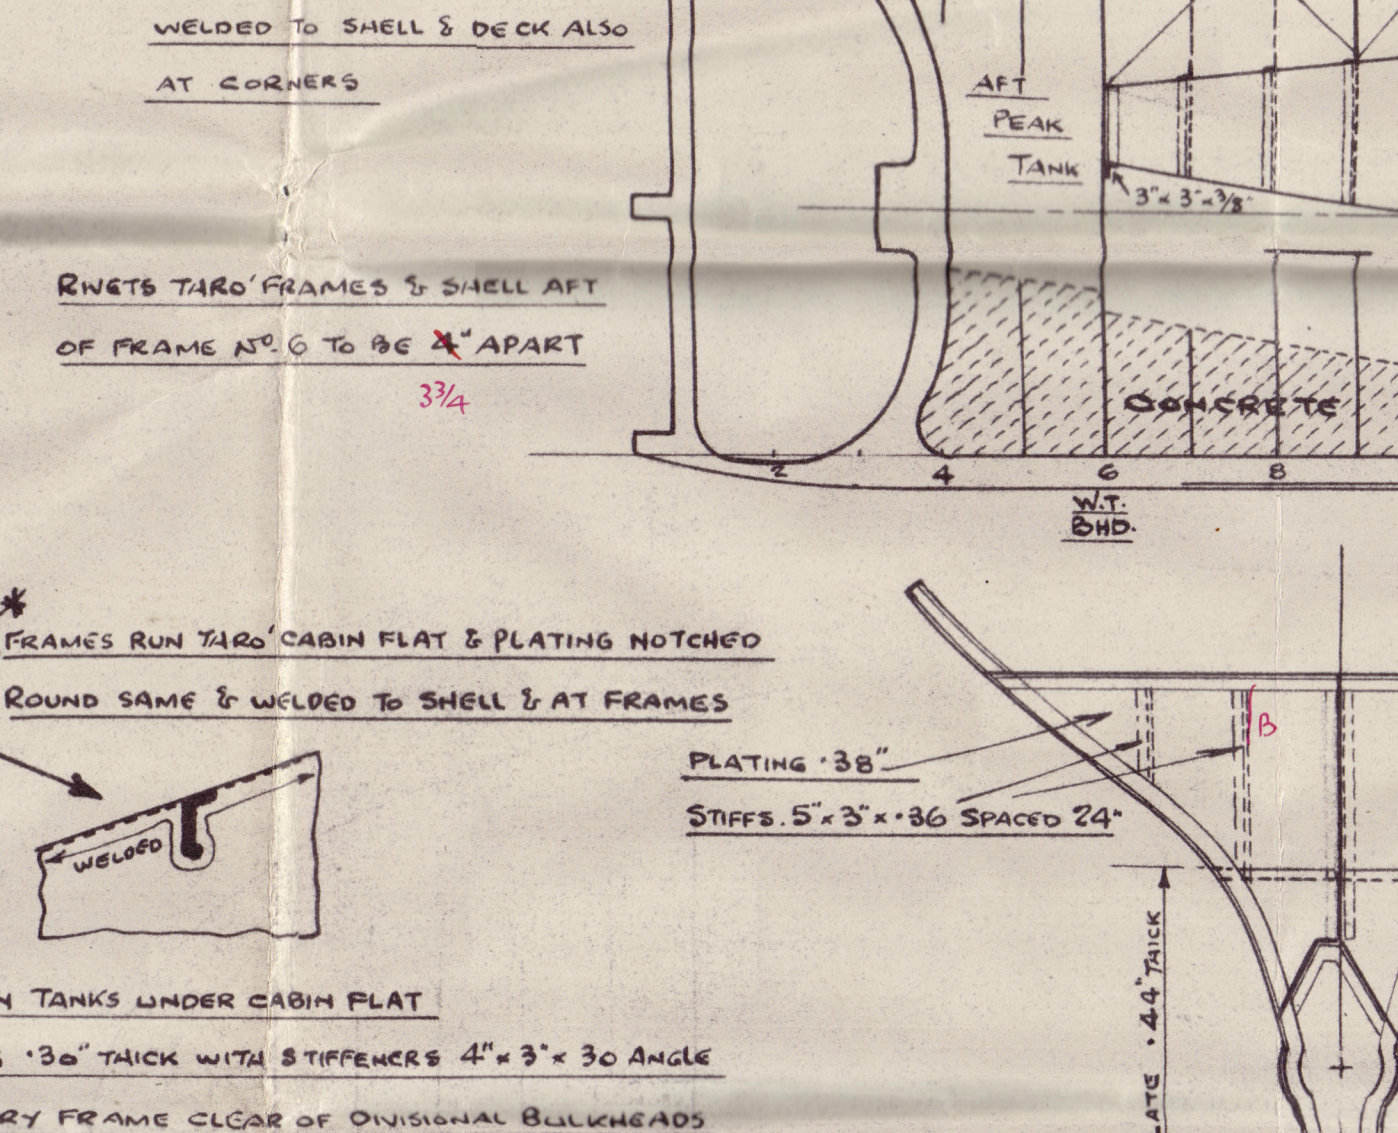


**PROFILE <sup>& AND</sup> DECK PLANS - NO 640 SHIP - SCALE 1/4" = 1 FOOT**  
LENGTH 161'-9" B.P. x 27'-0" B.MLD. x 15'-3" D.MLD.  
CLASS 100.A.1. STEAM TRAWLER

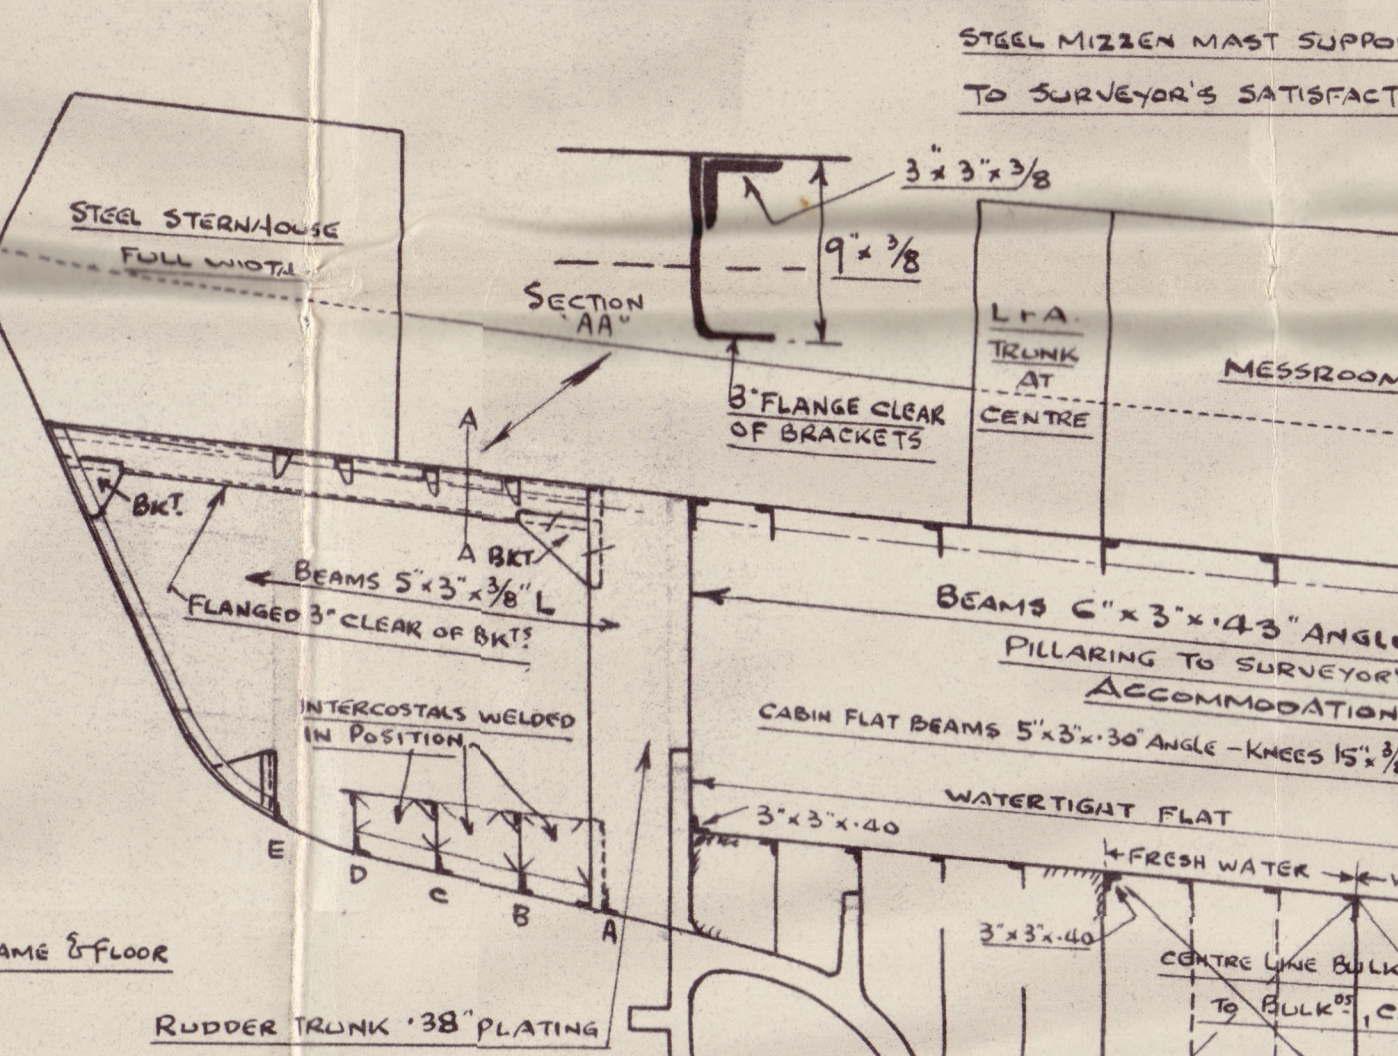

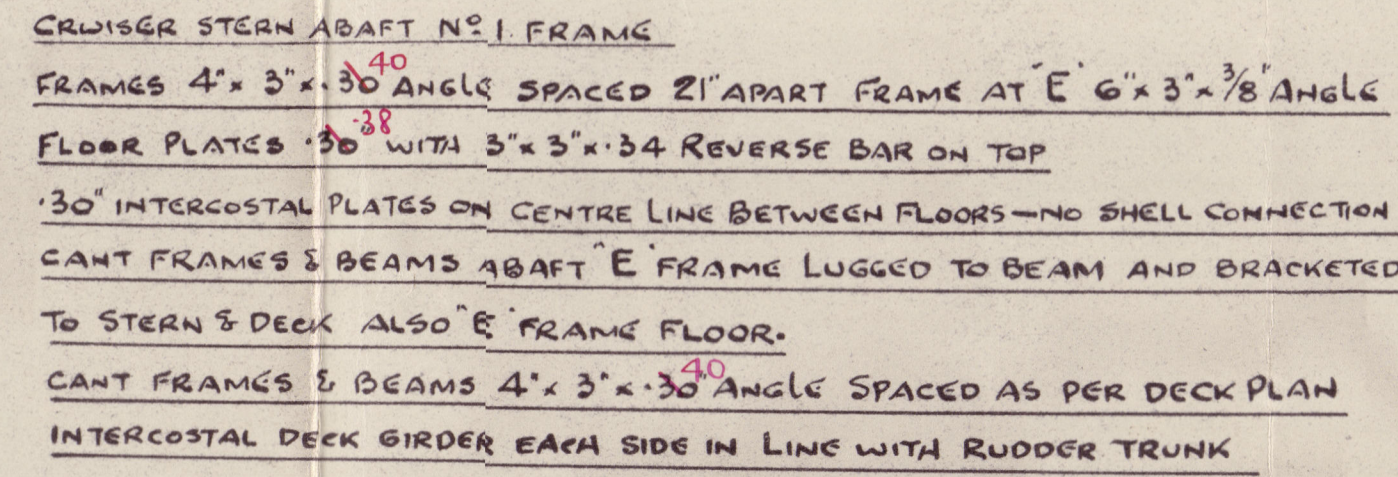

**HULL**  
book Wotton & Gemmell Ltd

Yard No. 640.

Profile & Deck Plan.

S.S. Kingston Gate

HULL REPORT No. 485-11

REIN

© 2020

Lloyd's Register  
Foundation

003467-003473-0090