

# PROFILE AND DECK PLANS

SCALE  $\frac{1}{8}" = \text{ONE FOOT}$

NOTE - SPACING OF RIVETS IN SEAMS & END LAPS TO RULE  
NO INCREASE IN DIA<sup>2</sup> OF RIVETS, WHEN PLATES MADE  
THICKER IN LIEU OF DOUBLINGS.

NOTE NO HATCH FORE & AFTERS  
FITTED WOOD COVERS FITTED  
FORE & AFT. THICK ON UPPER DECK  
" " " " 2<sup>ND</sup> DECK

338'-9" B.P. x 49'-10" B.M. M.P. x 32'-9" M.P. UPPER DECK  
23'-3" SECOND DECK


SEPARATE PLAN OF TUBE PILARS & DECK GIRDERS ETC  
WILL BE SUBMITTED

THICKNESS OF DECK PLATING INCREASED AT CORNERS OF  
MATCHWAYS & LARGE DECK OPENINGS ON  
UPPER & SECOND DECKS.

DECK ANGLES AT CORNERS OF LARGE OPENINGS ON UPPER DECK  
TO BE ELECTRIC WELDED ABOUT 15" FROM ANY AT CORNERS.

WINDLASS, WINCHES, STEERING GEAR  
MASTS ETC. SUPPORTED TO  
SURVEYORS' SATISFACTION

ALL CHANNELS AND BULB ANGLES ARE NEW BRITISH STANDARD SECTIONS  
EXCEPT 17'-3" B.A. BEAMS WHICH ARE C.B.S.

 

1072 & 3.  
1082 & 3.

1072 & 3.  
1082 & 3.



003467-003473-003480



(2A)  
William Gray & Co., Ltd.

Yard Nos: 1082, 1083

Profile + Decks as built

1082

Name:- "Ionian"

WEST HARTLEPOOL Report No:- **17837**

Transferred to  
Corinthian

1083


Name:- "Corinthian"

WEST HARTLEPOOL Report No:-

RETAIN

© 2020

003467-003473-0300

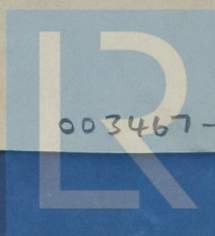

Lloyd's Register  
Foundation