


MAIN PIECE OF RUDDER TO BE TURNED DOWN $4\frac{1}{2}$ " FROM HEAD $7\frac{1}{2}$ " DIA.
HOLES FOR PINTLES TO BE CENTRED $3\frac{3}{4}$ " FROM FORE SIDE OF RUDDER FRAME.
HEAD & HOLES FOR HEEL & PINTLES TO BE TURNED IN A LATHE SO AS TO GET THEM
QUITE TRULY CENTRED. CHECK THE HEIGHTS OF GUDGEONS ON RUDDER
FRAME FROM THE HEIGHTS OF GUDGEONS ON SCREW FRAME & MAKE THEM
CORRESPOND.

NO SLOT IN BACK OF POST FOR RUDDER PLATE.

THIS PART LEFT FULL TO
ENSURE ITS STOPPING RUDDER
AT 42°. RATHER LEAVE $\frac{1}{8}$ TO
CHIP OFF THAN BE THE LEAST
SCANT.

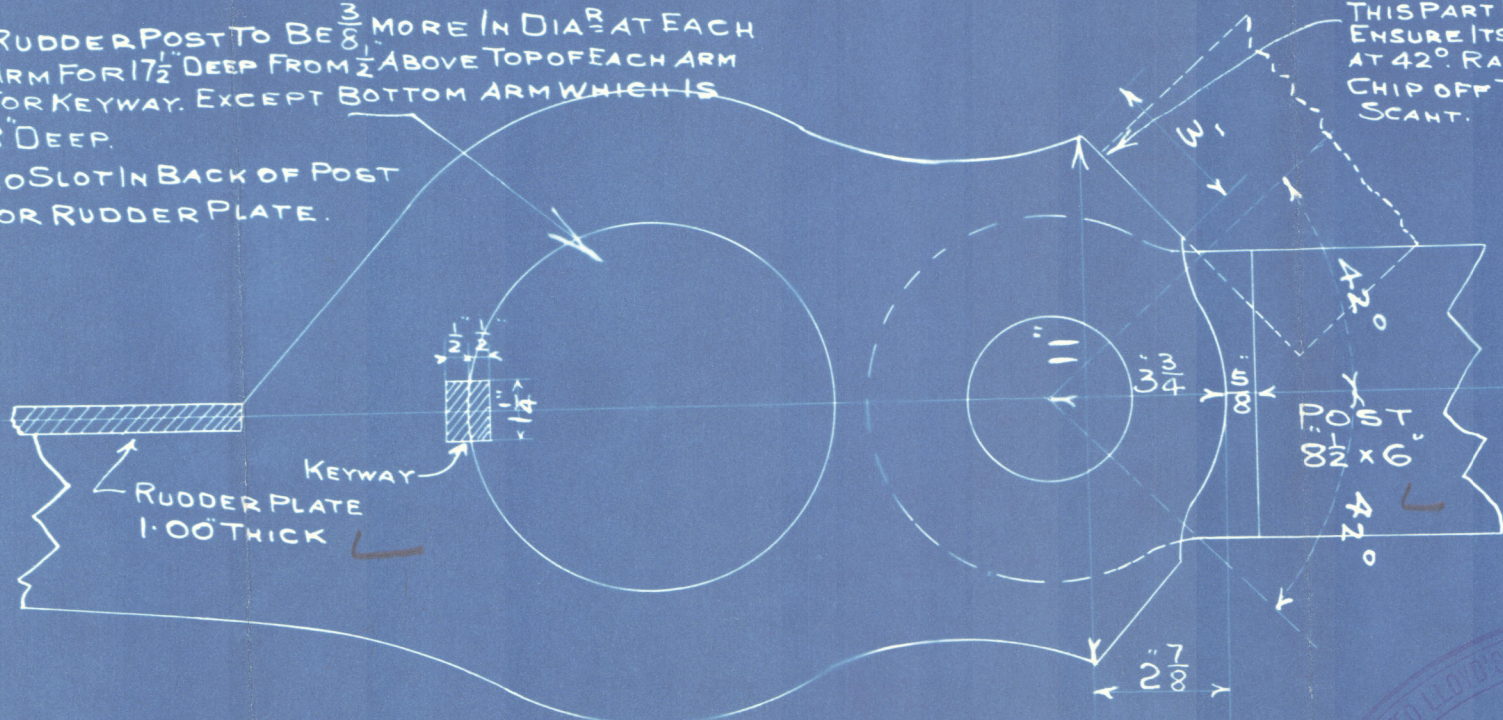

- SKETCH OF STOPPERS. -
- SCALE 3" = 1 FOOT. -


RUDDER PLAN.

GRAY'S S.S. No 809

S.S. "Confield"

Appl Rpt. No. 14522.

Runnado.

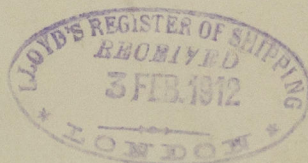

© 2020

Lloyd's Register
Foundation

003474-003478-0005