


MIDSHIP SECTION.

SCALE $\frac{1}{2}$ " = ONE FOOT.

5.2.12
30.7.12

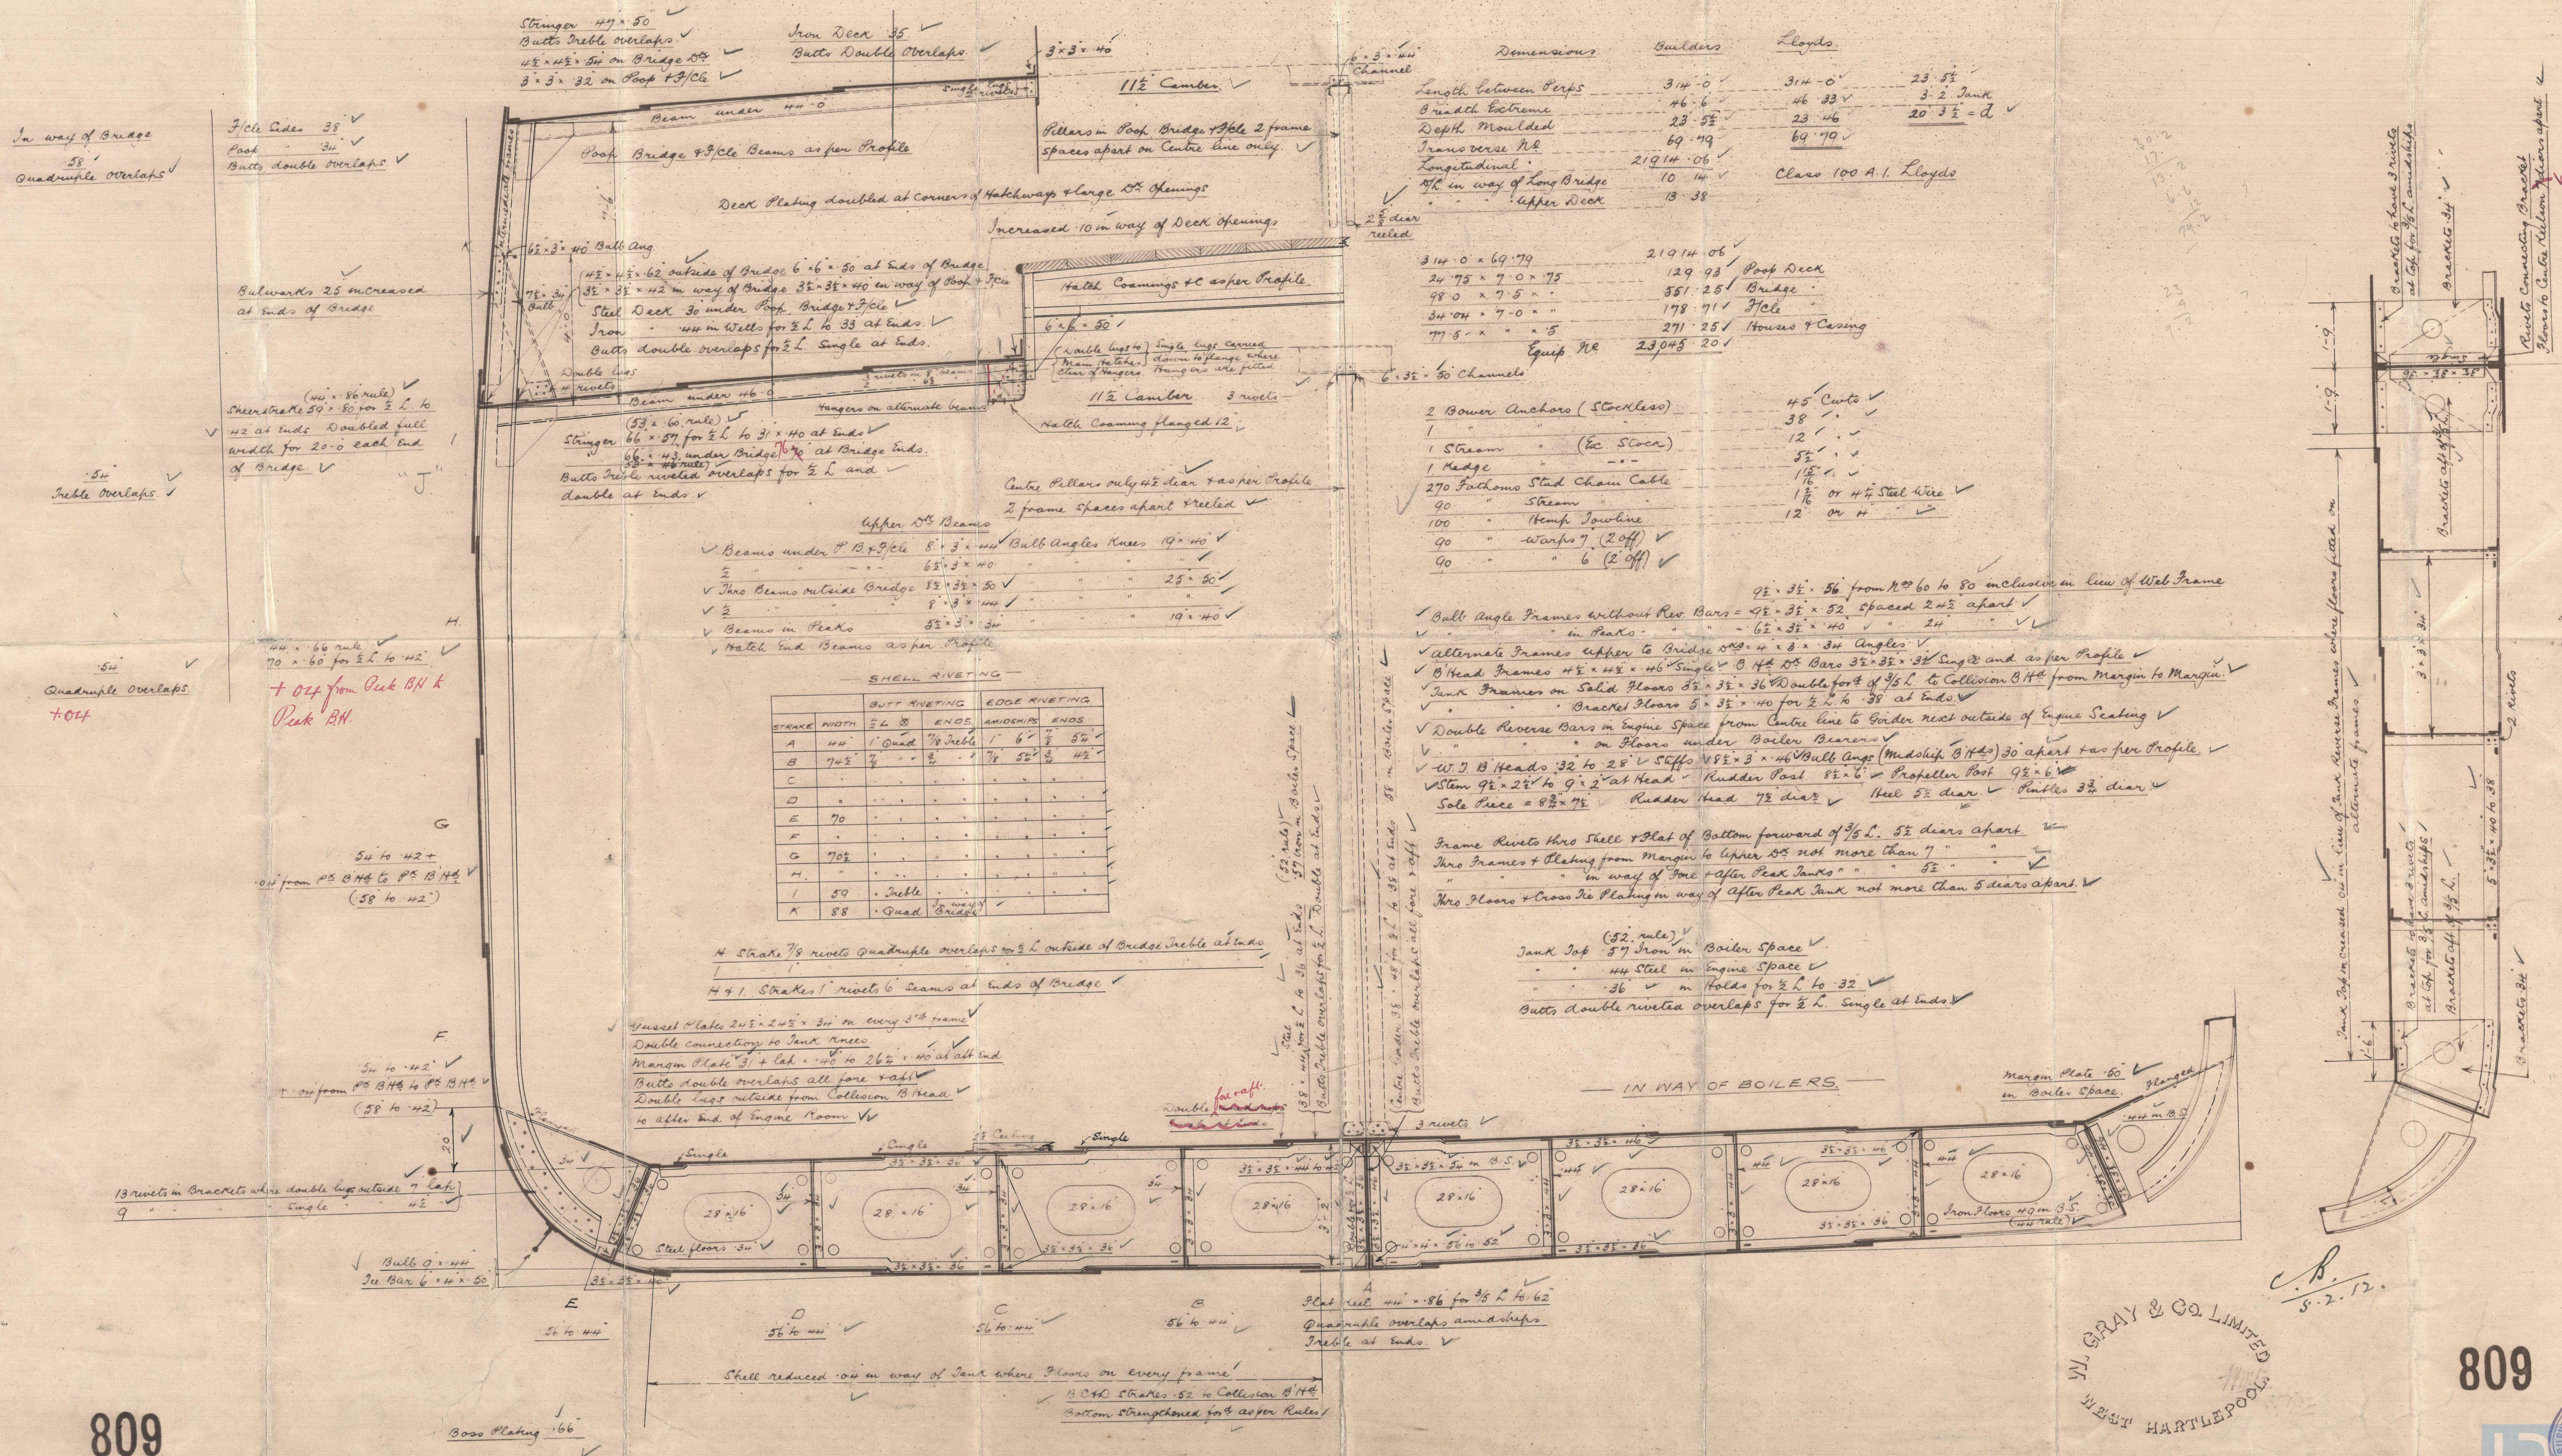

Section in way of Intermediate Frames ✓

W. GRAY & CO. LIMITED
WEST HARTLEPOOL

C. B.
—
S. 2. 12.

809



Lloyd's Register
Foundation

003474-003478-0006



MIDSHIP SECTION

GRAY'S S.S. N^o 809.

S.S. "Bonfield"

Hpl Rpt. No. 1/4 5 2 2.

"Runmad o."

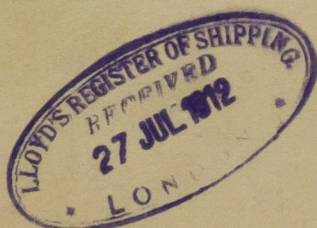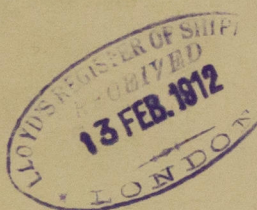

© 2020

Lloyd's Register
Foundation

003474-003478-0006