

# Lloyd's Register of Shipping.

Ship's Name Steamer "RUNMARÖ"

Official No. 7601.

Memorandum of alterations reported since ship was surveyed for assignment of Load Lines in

This vessel has now been altered to an Easy Trimmer.

The forecastle has been reduced in length and all cargo hatchways have been increased in size.


The supporting of decks has been re-arranged to suit the arrangements of large hatchways and the decks have been strengthened in way of hatchways, in order to compensate for the part of same cut away. The tunnel and tunnel recess forward strengthened in way of pillars.

The hatchway coamings, shifting beams, wood covers and tarpaulins have been completely renewed.

Length of forecastle: 4

Mean covered length

$$\frac{2 \cdot 5,1 \times 6,2}{40} + 26,75 = 28,34$$

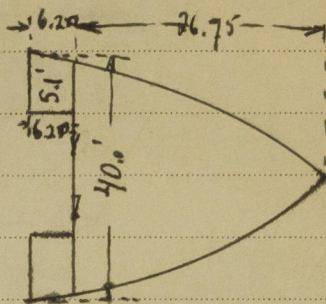

Forecastle bulkhead:- Plating 7,5 mm. stiffening 100x8 mm flat bar spaced 670 mm. apart and welded to plate. Opening port side 1220x920 sill 440 mm., starboard side full height 920 mm. closed with 65 mm. wood shifting boards in welded channels. Openings at wings closed with hinged steel doors.

Opening in Bridge front bulkhead altered to 1300 x 880 mm. with sill 570 mm. and closed by portable steel plate secured by hook bolts permanently fixed to bulkhead and spaced 165 mm. apart.

Hatchways on <del>Foreboard and Superstructure Decks</del> UPPER DECK						BRIDGE DECK
Description of Hatchway	No. 1	No. 2	No. 3	No. 4	No. 5	No. 3
Dimensions of Hatchway	8840 x 6950	8130 x 9200	5600 x 2530	9260 x 9120	2930 x 9120	5480 x 6570
COAMINGS	Height above Deck	1000 ✓	1000 ✓	320 ✓	1000 ✓	1000 ✓
	Thickness	12 ✓	12 ✓	12 ✓	12 ✓	12 ✓
	Stiffeners	200 x 25 x 102	200 x 25 x 102	✓	200 x 25 x 102	200 x 25 x 102
	Brackets, Stays	2 ✓	2 ✓	✓	2 ✓	✓
HATCH BEAMS	Number	5	5	3	5	4
	Spacing	1424	1354	1400	1544	1486
	Scantling and Sketch	350 x 12 ✓ 615 x 11.5 ✓	250 x 12 ✓ 330 x 8.5 ✓	250 x 12 ✓ 330 x 8.5 ✓	350 x 12 ✓ 615 x 11.5 ✓	280 x 12 ✓ 360 x 8.5 ✓
	Bearing Surface	75 ✓	25 ✓	25 ✓	75 ✓	25 ✓
FORE AND AFTERS	Number	4	8	5	5	5
	Spacing	844	30	83	30	30
	Unsupported Lengths	✓	✓	✓	✓	✓
	Scantling* and Sketch	✓	✓	✓	✓	✓
HATCH COVERS	Material	Wood	Wood	Wood	Wood	Wood
	Thickness	25	25	25	25	25
	How fitted	Fore and aft	Fore and aft	Fore and aft	Fore and aft	Fore and aft
	Bearing Surface	25 x 125 ✓	25 x 125 ✓	25 x 125 ✓	25 x 125 ✓	25 x 125 ✓
Spacing of Cleats	610	610	610	610	610	610
Number of Tarpaulins	2	2	2	2	2	2

- \*) Are wood fore and afters steel shod at all bearing surfaces?  
Are tarpaulins in good condition and in accordance with rule requirements?  
Are battens and wedges efficient and in good condition?  
Are lashings provided in accordance with rule requirements?

003474-003478-0032