

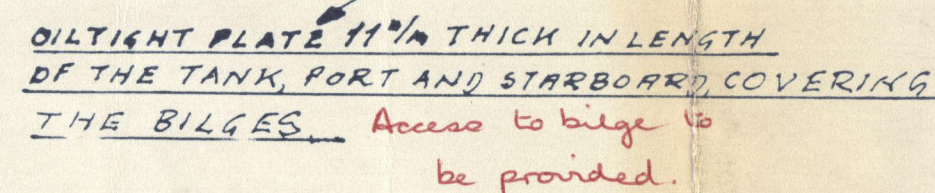



Existing deck beams
assumed 7.3 x 36 B.A's
as per original deck plans.

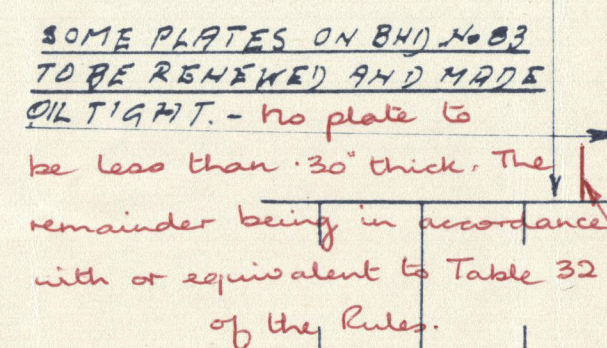

Scale: 1:50, 1:10

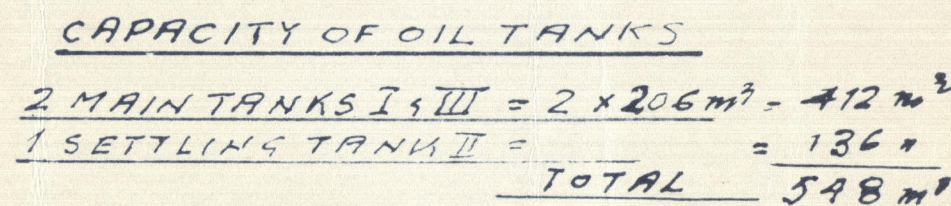

MAIN TANKS 95% FULL
SPECIFIC GRAVITY 0,93

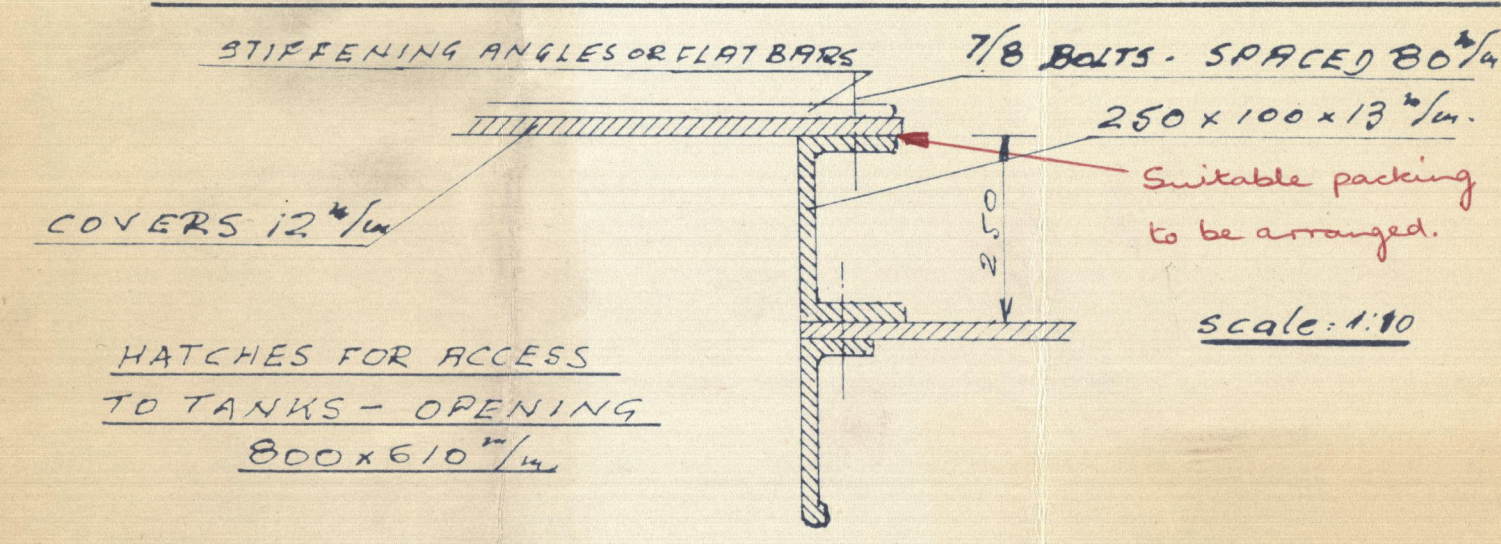

All boundaries to be double riveted or equivalent.

Existing structure in way of
oil fuel tank to be made oil tight
to Surveyors satisfaction.

PIR. 7995

P.A. PETROUTSIS
NAVAL ARCHITECT
PIRAEUS 8/8/58

Lloyd's Register
Foundation

003474- 003478-0078

Lib



© 2020

Lloyd's Register
Foundation

003474-003478-0078