

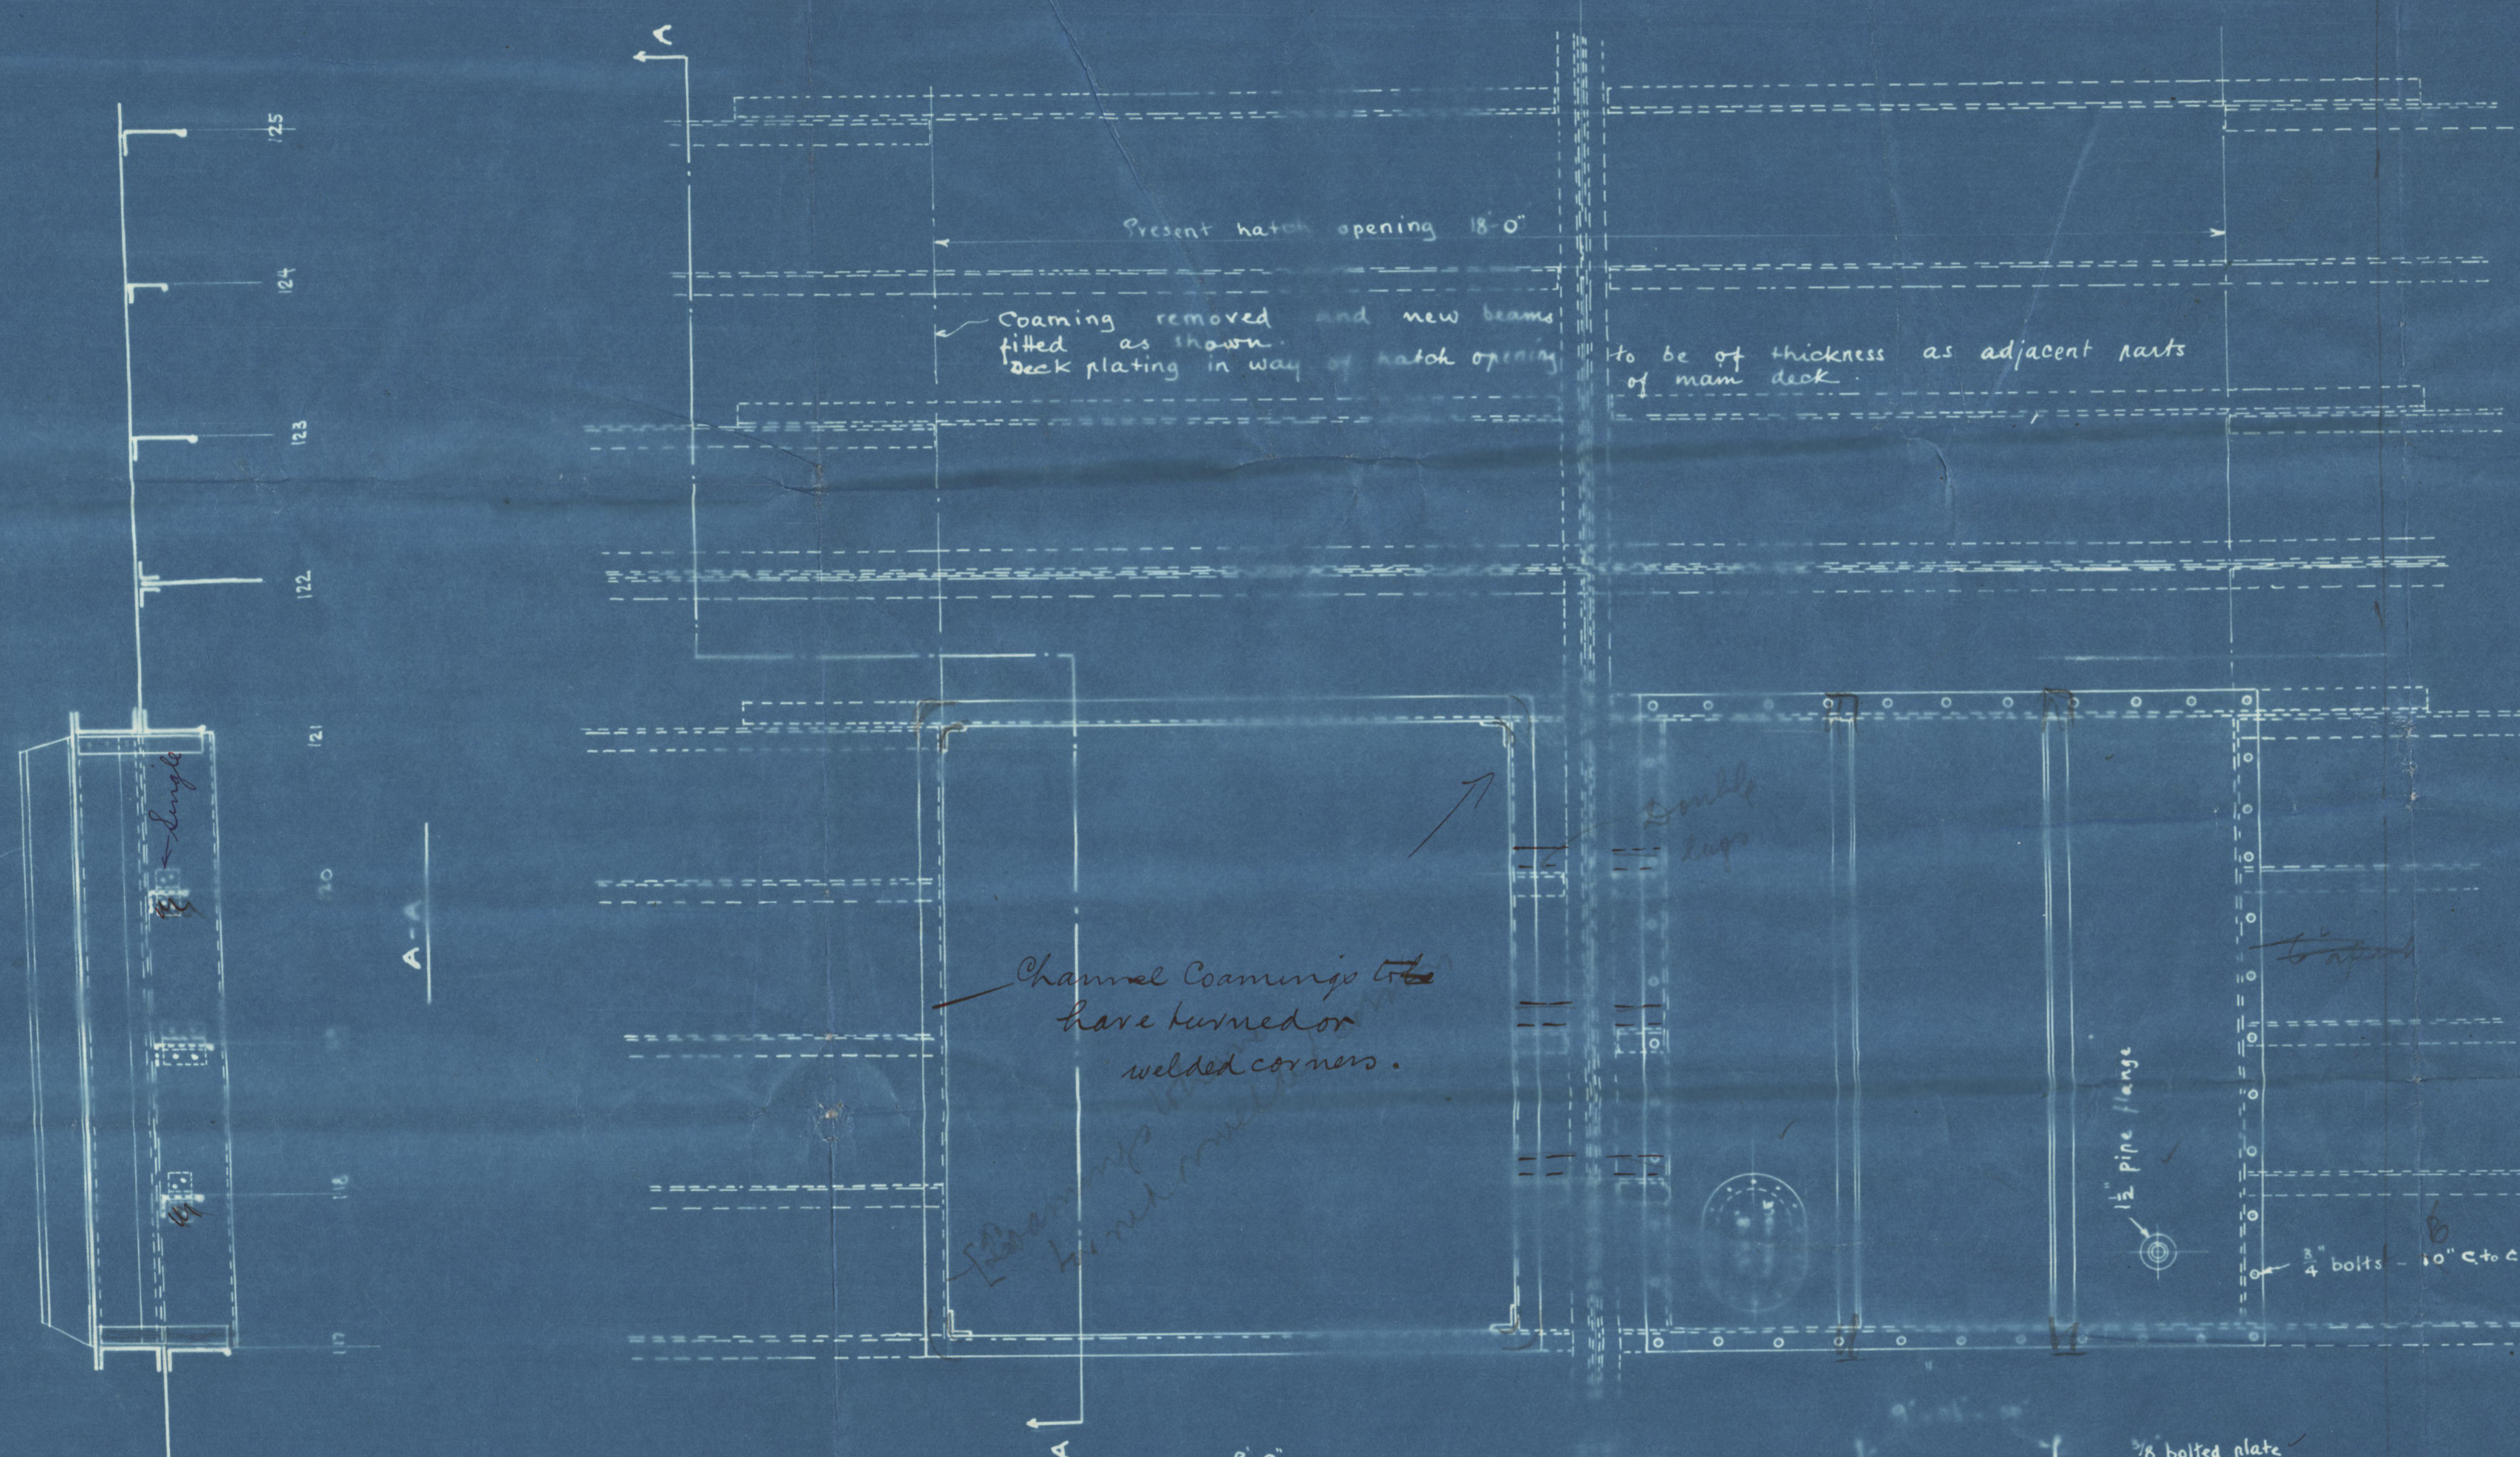


Scale:  $\frac{1}{2}$ " = 1 foot.

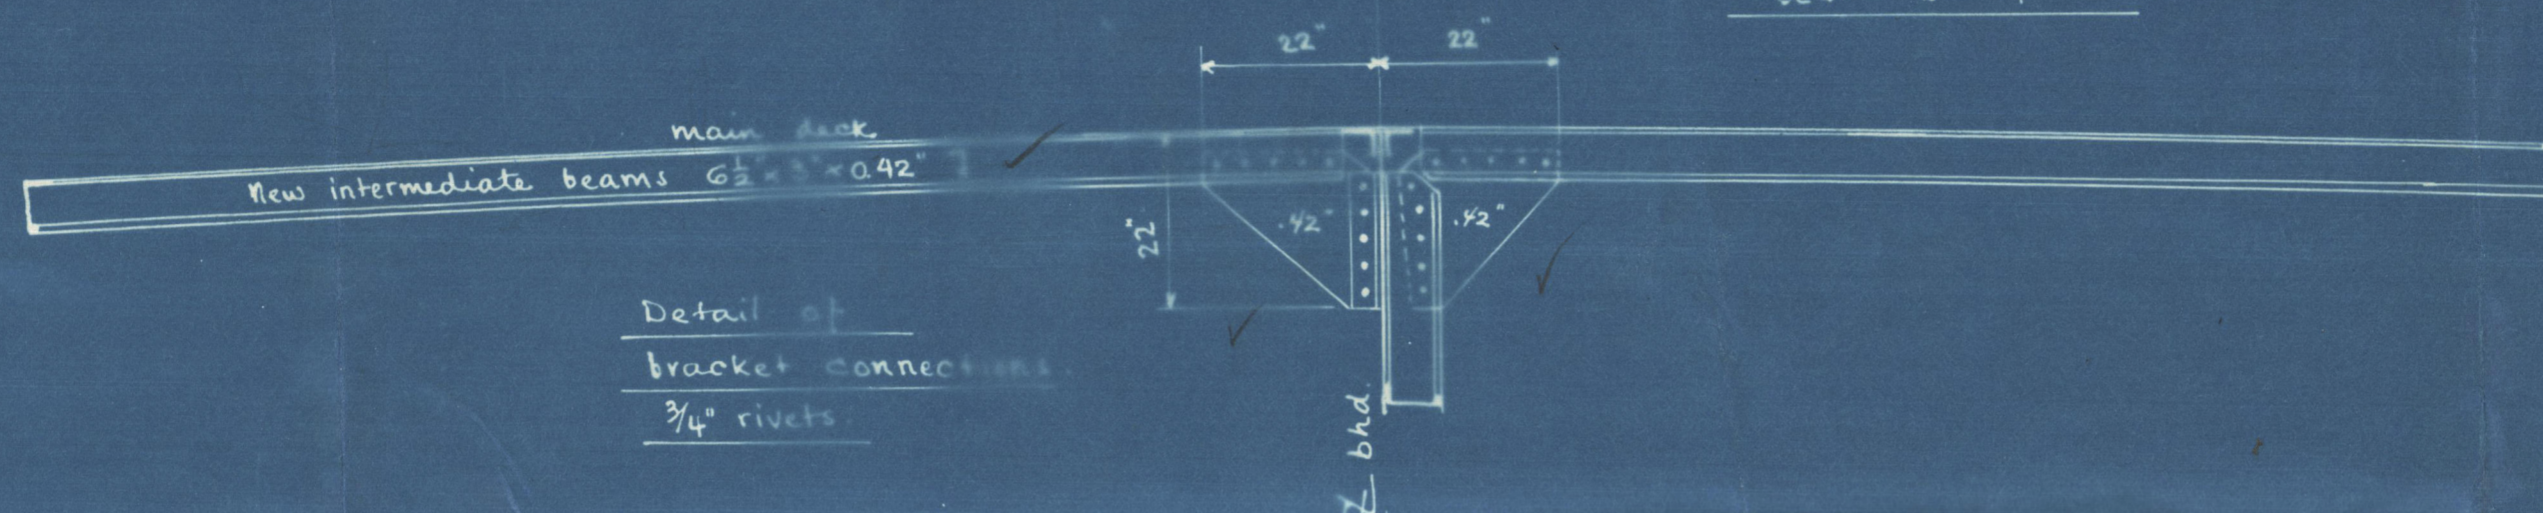

Scale:  $\frac{1}{2}$ " = 1 foot.

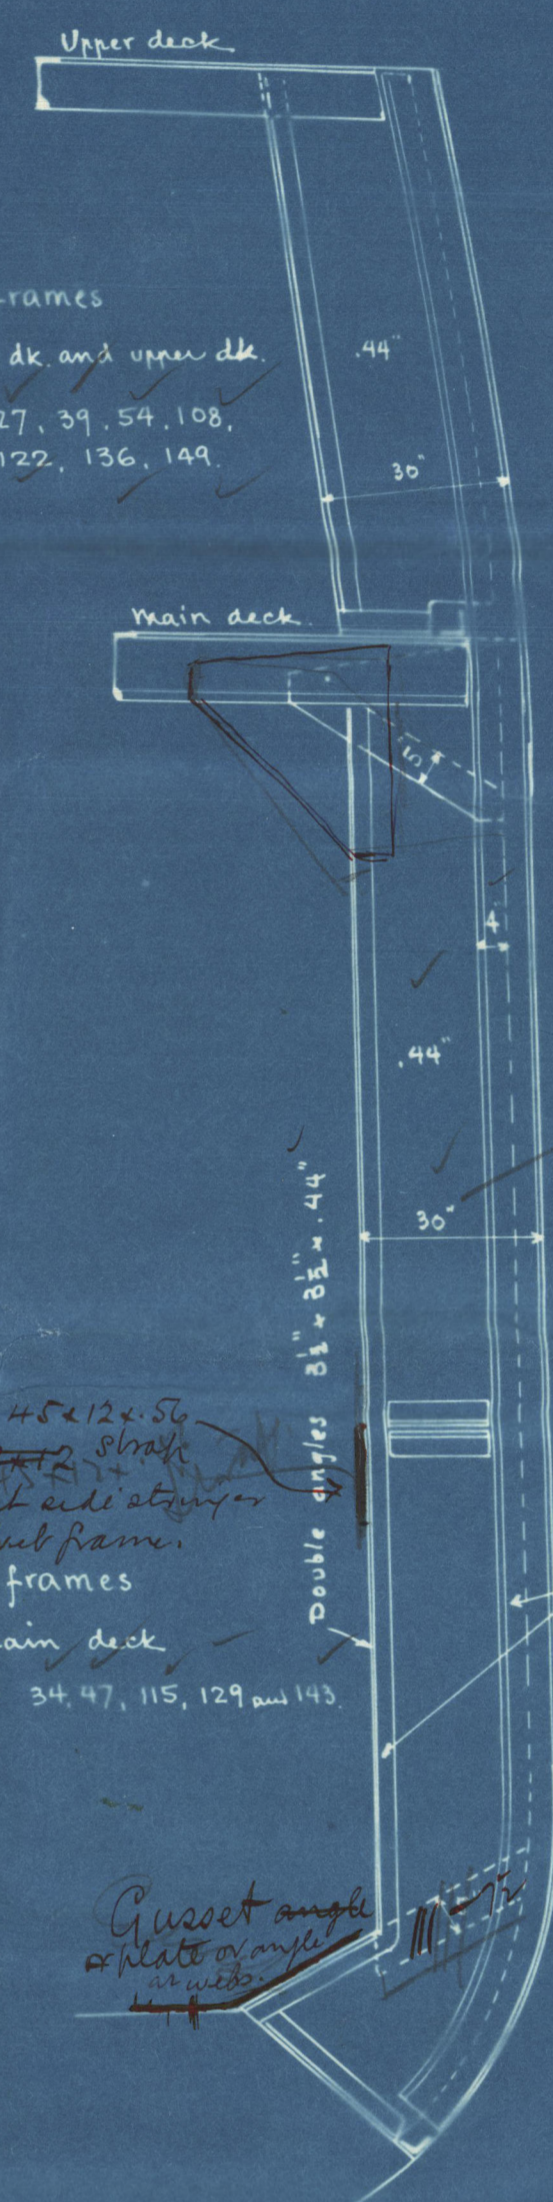

Web frames

Scale  $\frac{3}{8}$ " = 1 foot.

Web frames between main dk and upper dk. at frames 27, 39, 54, 108, 122, 136, 149.

Web frames below main deck at frames 34, 47, 115, 129 and 143.

Gusset angle plates on web frames

Schaeffer  
O'Neil

S/S MAUDIE

- 8' x 8' W.T. BOLTED HATCHES FOR WHALE OIL TANKS.
- NEW BEAMS IN WAY OF PRESENT HATCH OPENINGS.
- MAIN DECK BEAM CONNECTIONS.
- WEB FRAMES.

Jarvis Verft 16/5-22.




2020 Lloyd's Register

003474-003478-0120 undation

Maudie

Web frames

+ deep tank  
oil covers

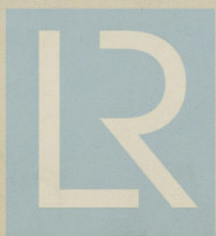

© 2020

Lloyd's Register  
Foundation

003474-003478-0120