


WHERE NO DECK BEAM THE BRACKET IS CONNECTED TO DECK AS SHOWN ON TRANSVERSE BULKHEAD.

FOR WEB FRAMES SEE DETAILS ON TRANSVERSE BULKHEAD

RIVETING:

IN SEAMS AND BUTTS, SINGLE RIV.	3/4" R.	3 1/2" DIST.
IN BOUNDING BARS TO BULKHEAD	3/4" -	3 3/4" -
" " " TO TANKTOP AND DECK	7/8" -	4 3/8" -
IN STIFFENERS	3/4" -	5 1/4" -

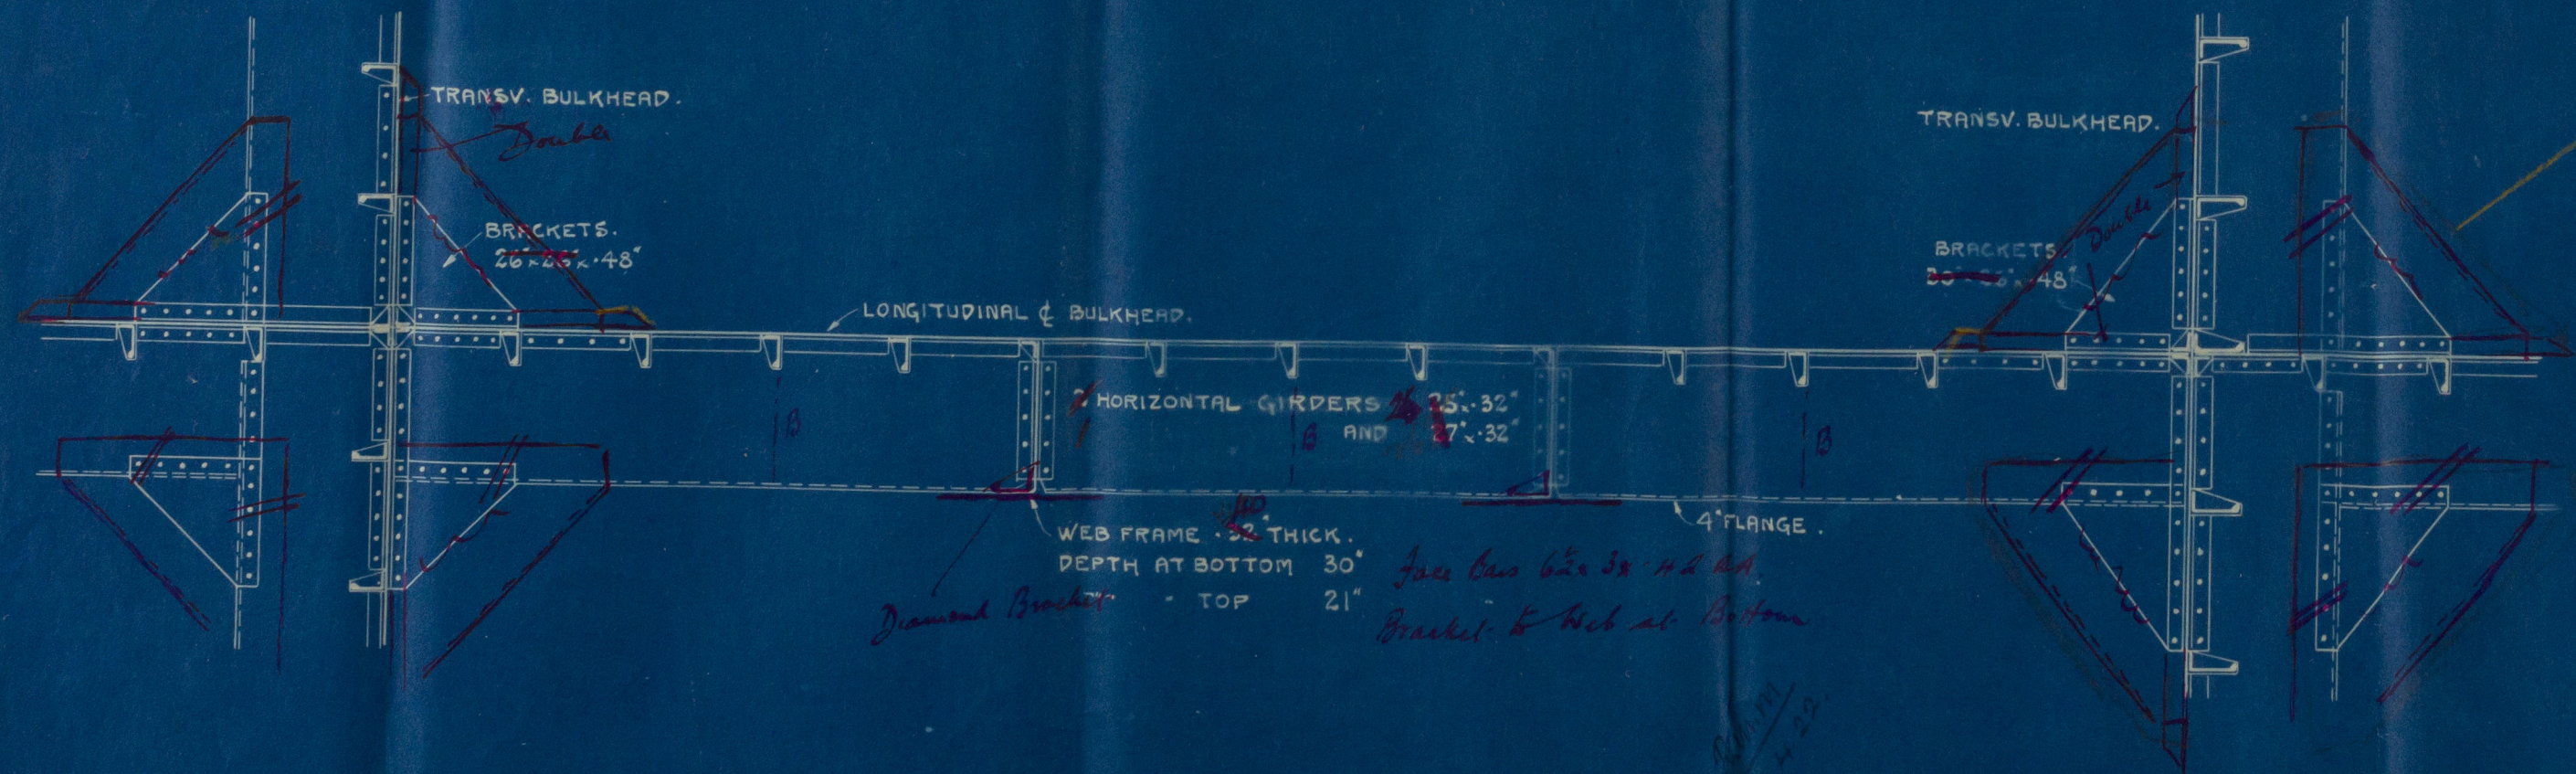

S/S MAUDIE.
LONGITUDINAL BULKHEAD.
(WHALE OIL TANKS)
DETAILS.
SCALE 3/8" = 1 FOOT.

S/S JARLSØ VERFT 16-3-22



TR.J.