







12 OCT 1945

No. 1753.

PROFILE & DECKS.

SCALE:- $\frac{1}{16}$ " = 1 FOOT.

DIMS: 550'-0" B.P. x 70'-0" B.MLD. x 40'-6" D.MLD.

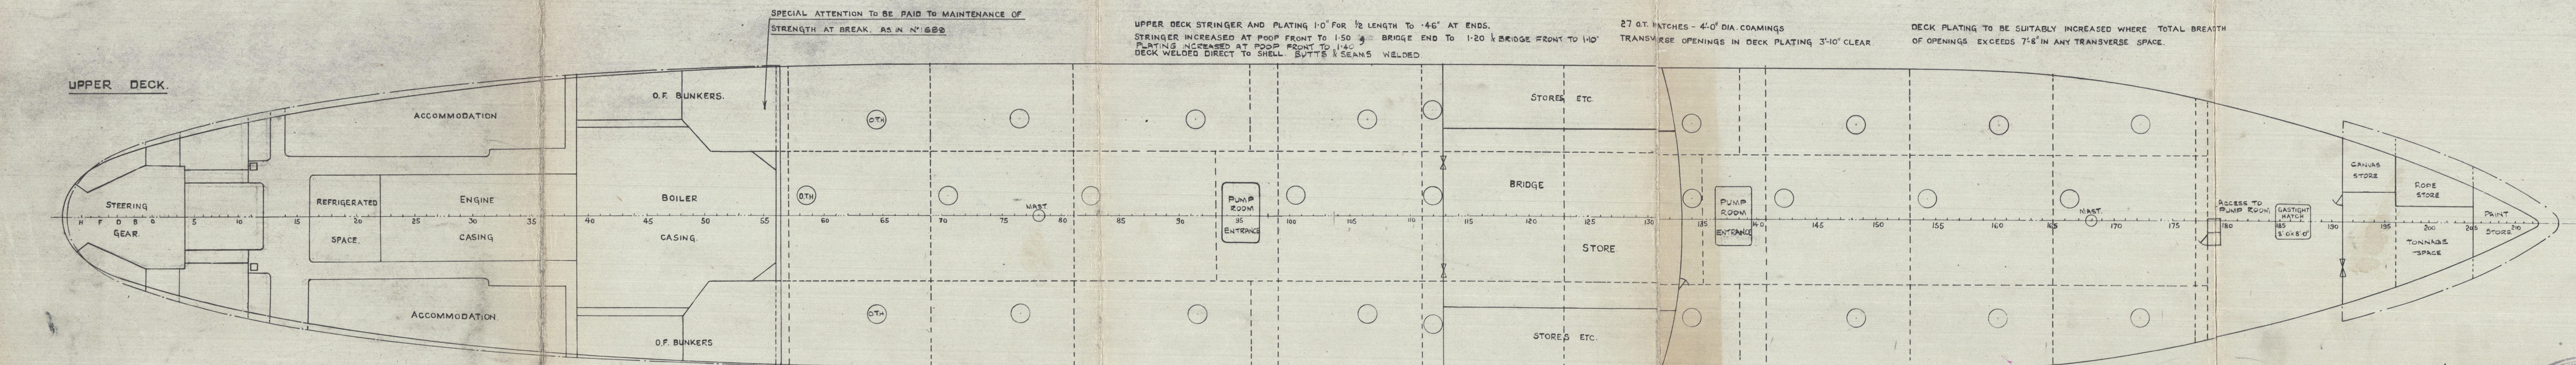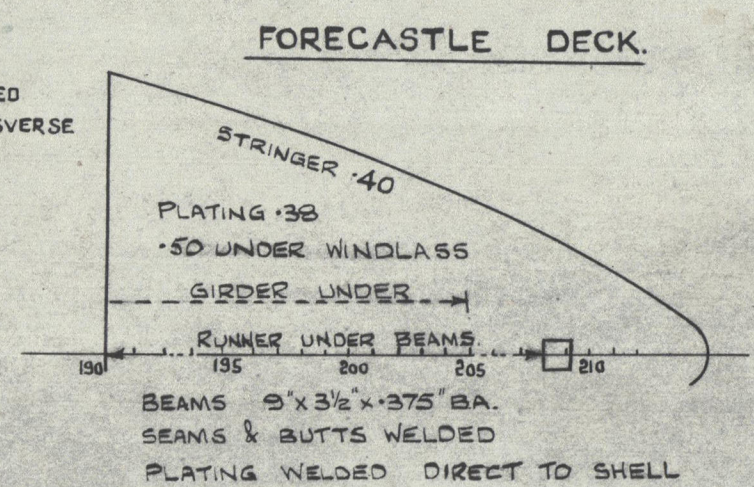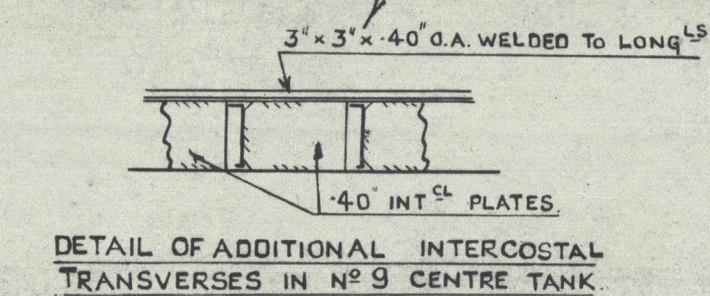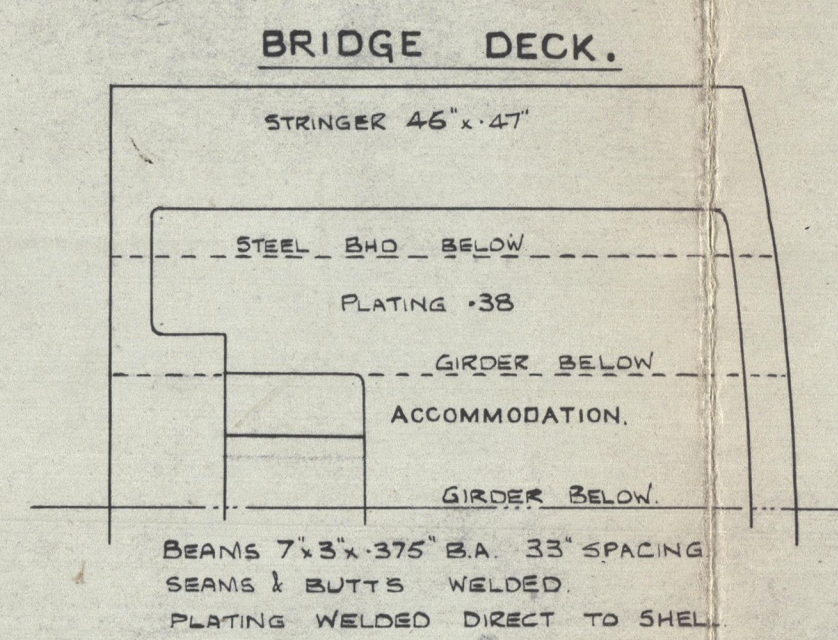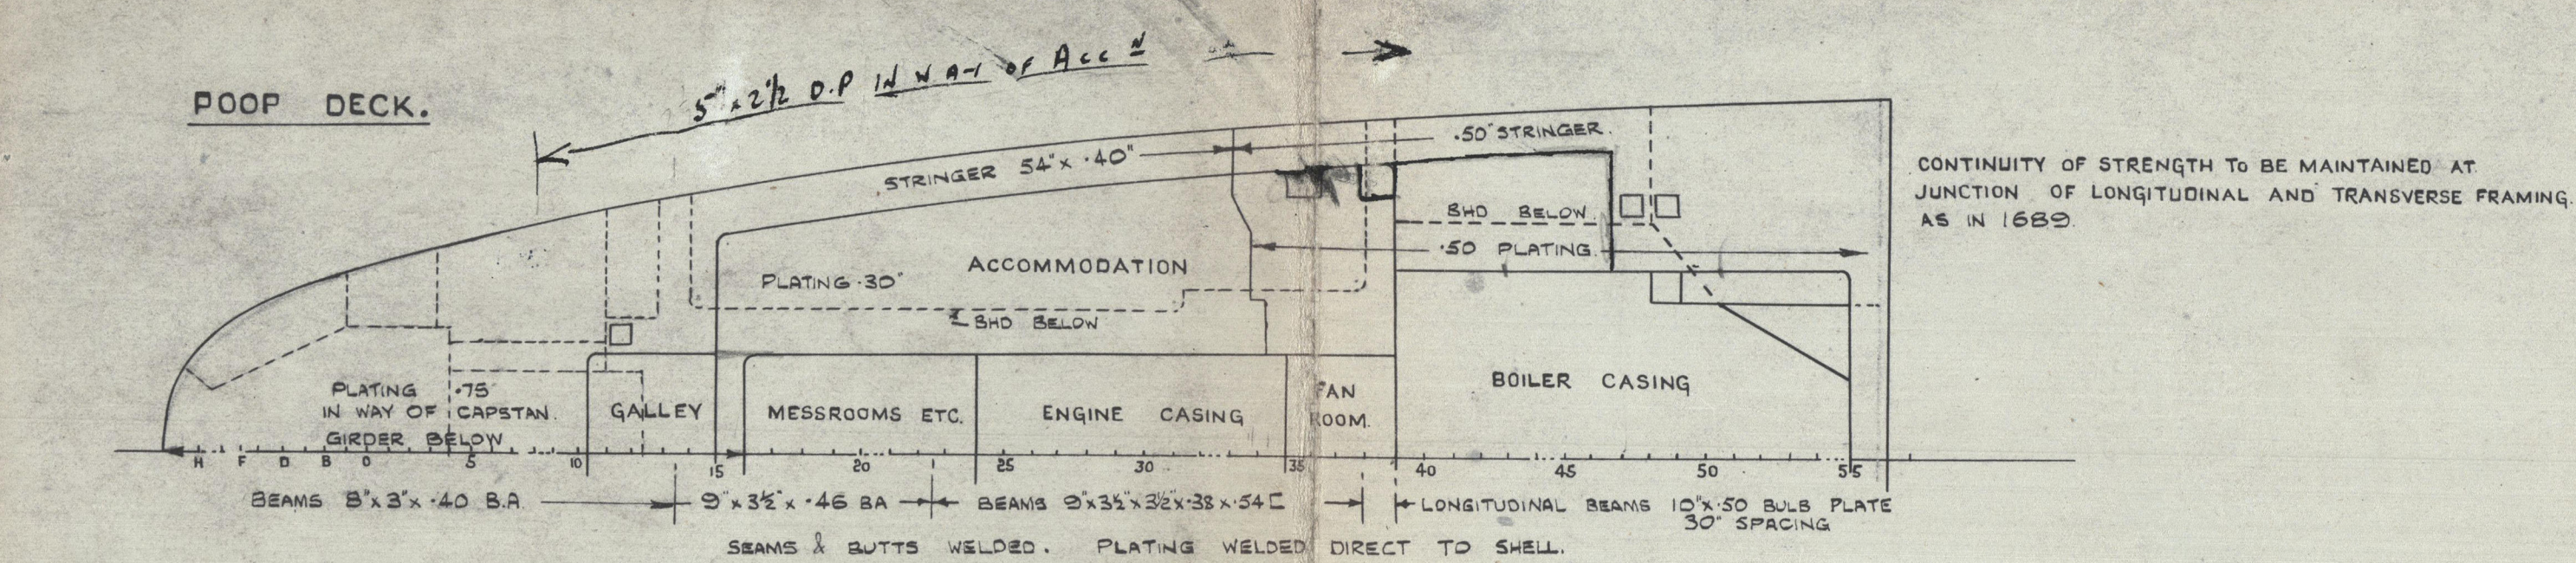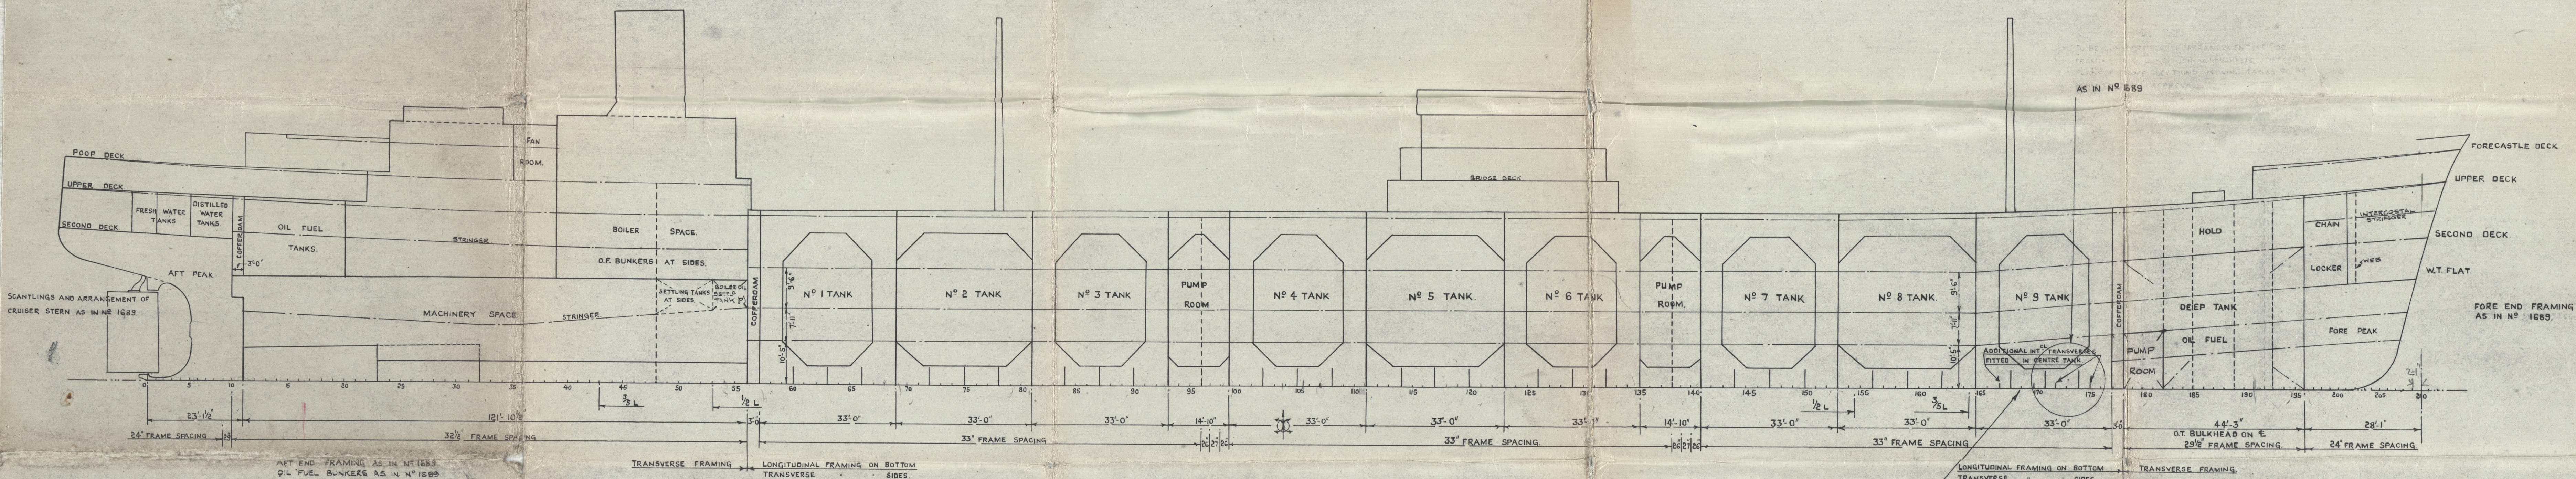

11-10-45
003479-003486-0174
Issue No. 6

201
12 30

2

SWAN HUNTER & WIGHAM
RICHARDSON LTD.

SHIP NO. Nº 1753

PROFILE & DECK PLANS.

"Hyalina" ★
NEWCASTLE ON TYNE

Report No. 105097

2



© 2020

Lloyd's Register
Foundation

003479-003486-0174