

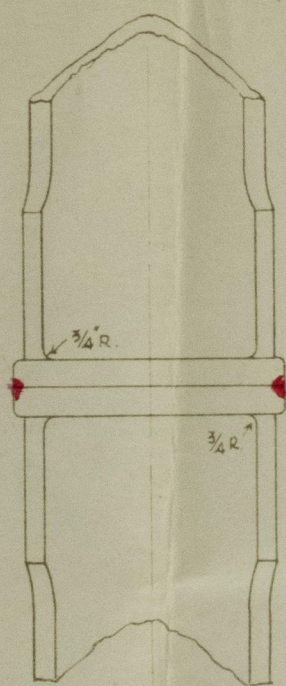


ENCLOSURE
204

SCALE:~ 1" = ONE FOOT.

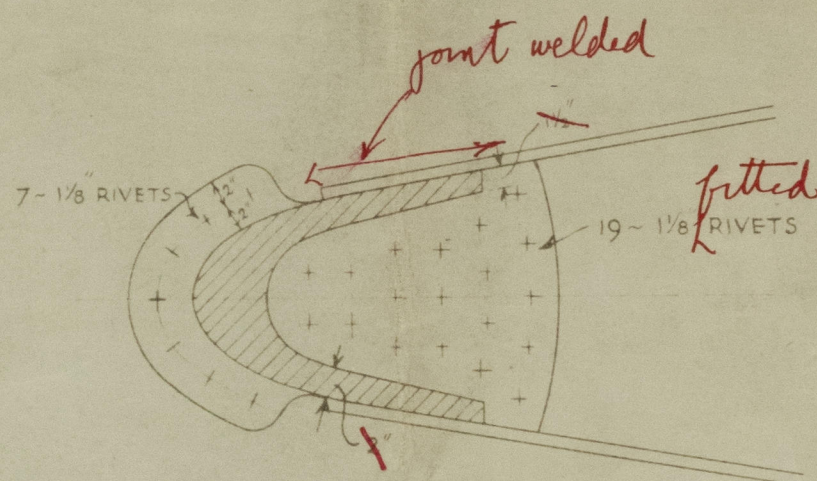

END ELEVATION

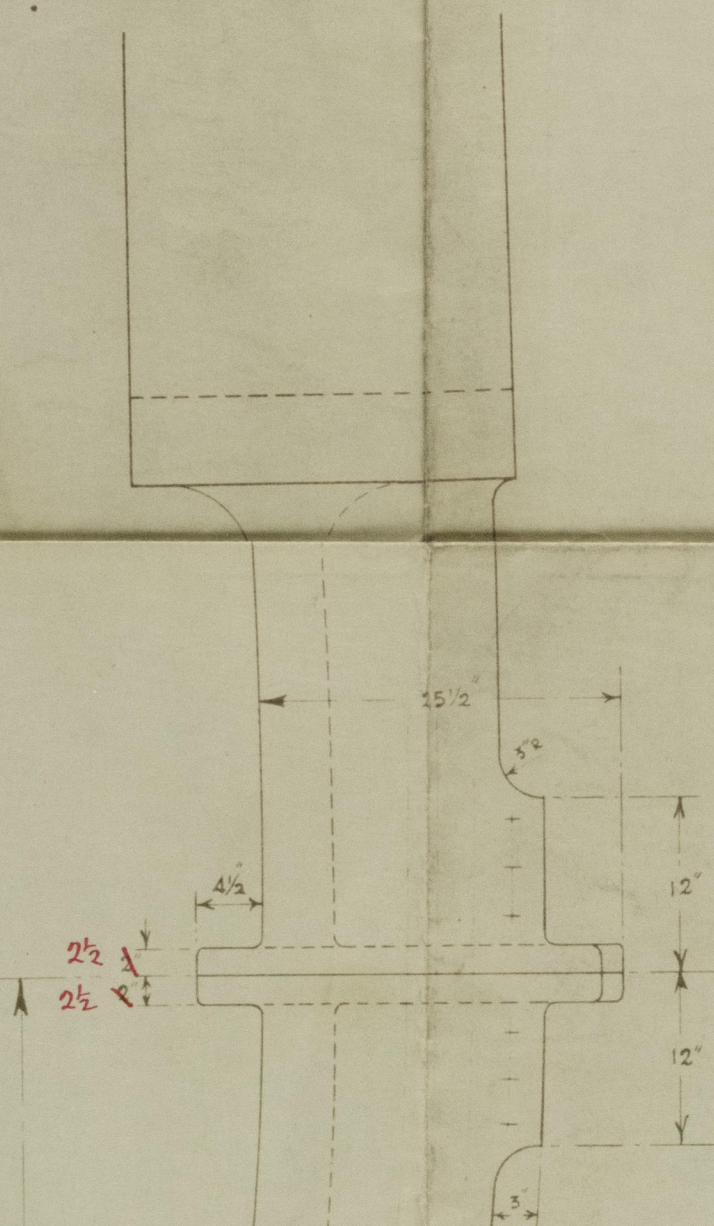


PLAN VIEW OF SCARPH

Form of Stemframe WEB
7'-3" as on Principal Plan.

W. J.

Y. 1.43

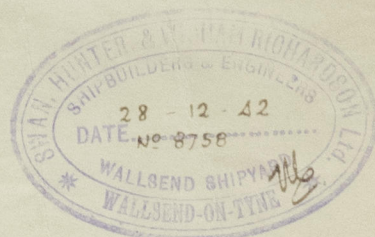

© 2020

Lloyd's Register
Foundation

003479-003486-0175

SWAN HUNTER & WIGHAM
RICHARDSON LTD.

SHIP NO. 1689

"OLNA" *

NEWCASTLE ON TYNE

Report No.

Fly to "sternframe and
rudder plan" showing
alternative scarf in
lower post.

SHIP NO. 1711

"Helicina"


NEWCASTLE ON TYNE

Report No. 104096

003479-003486-0175

1753.

10

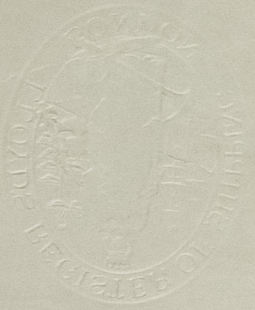

© 2020

Lloyd's Register
Foundation