


HEIGHT OF BULKHEADS

TANK TOP TO DK AT CR 28 FT 6 INS.

NEW WORK SHOWN IN GREEN

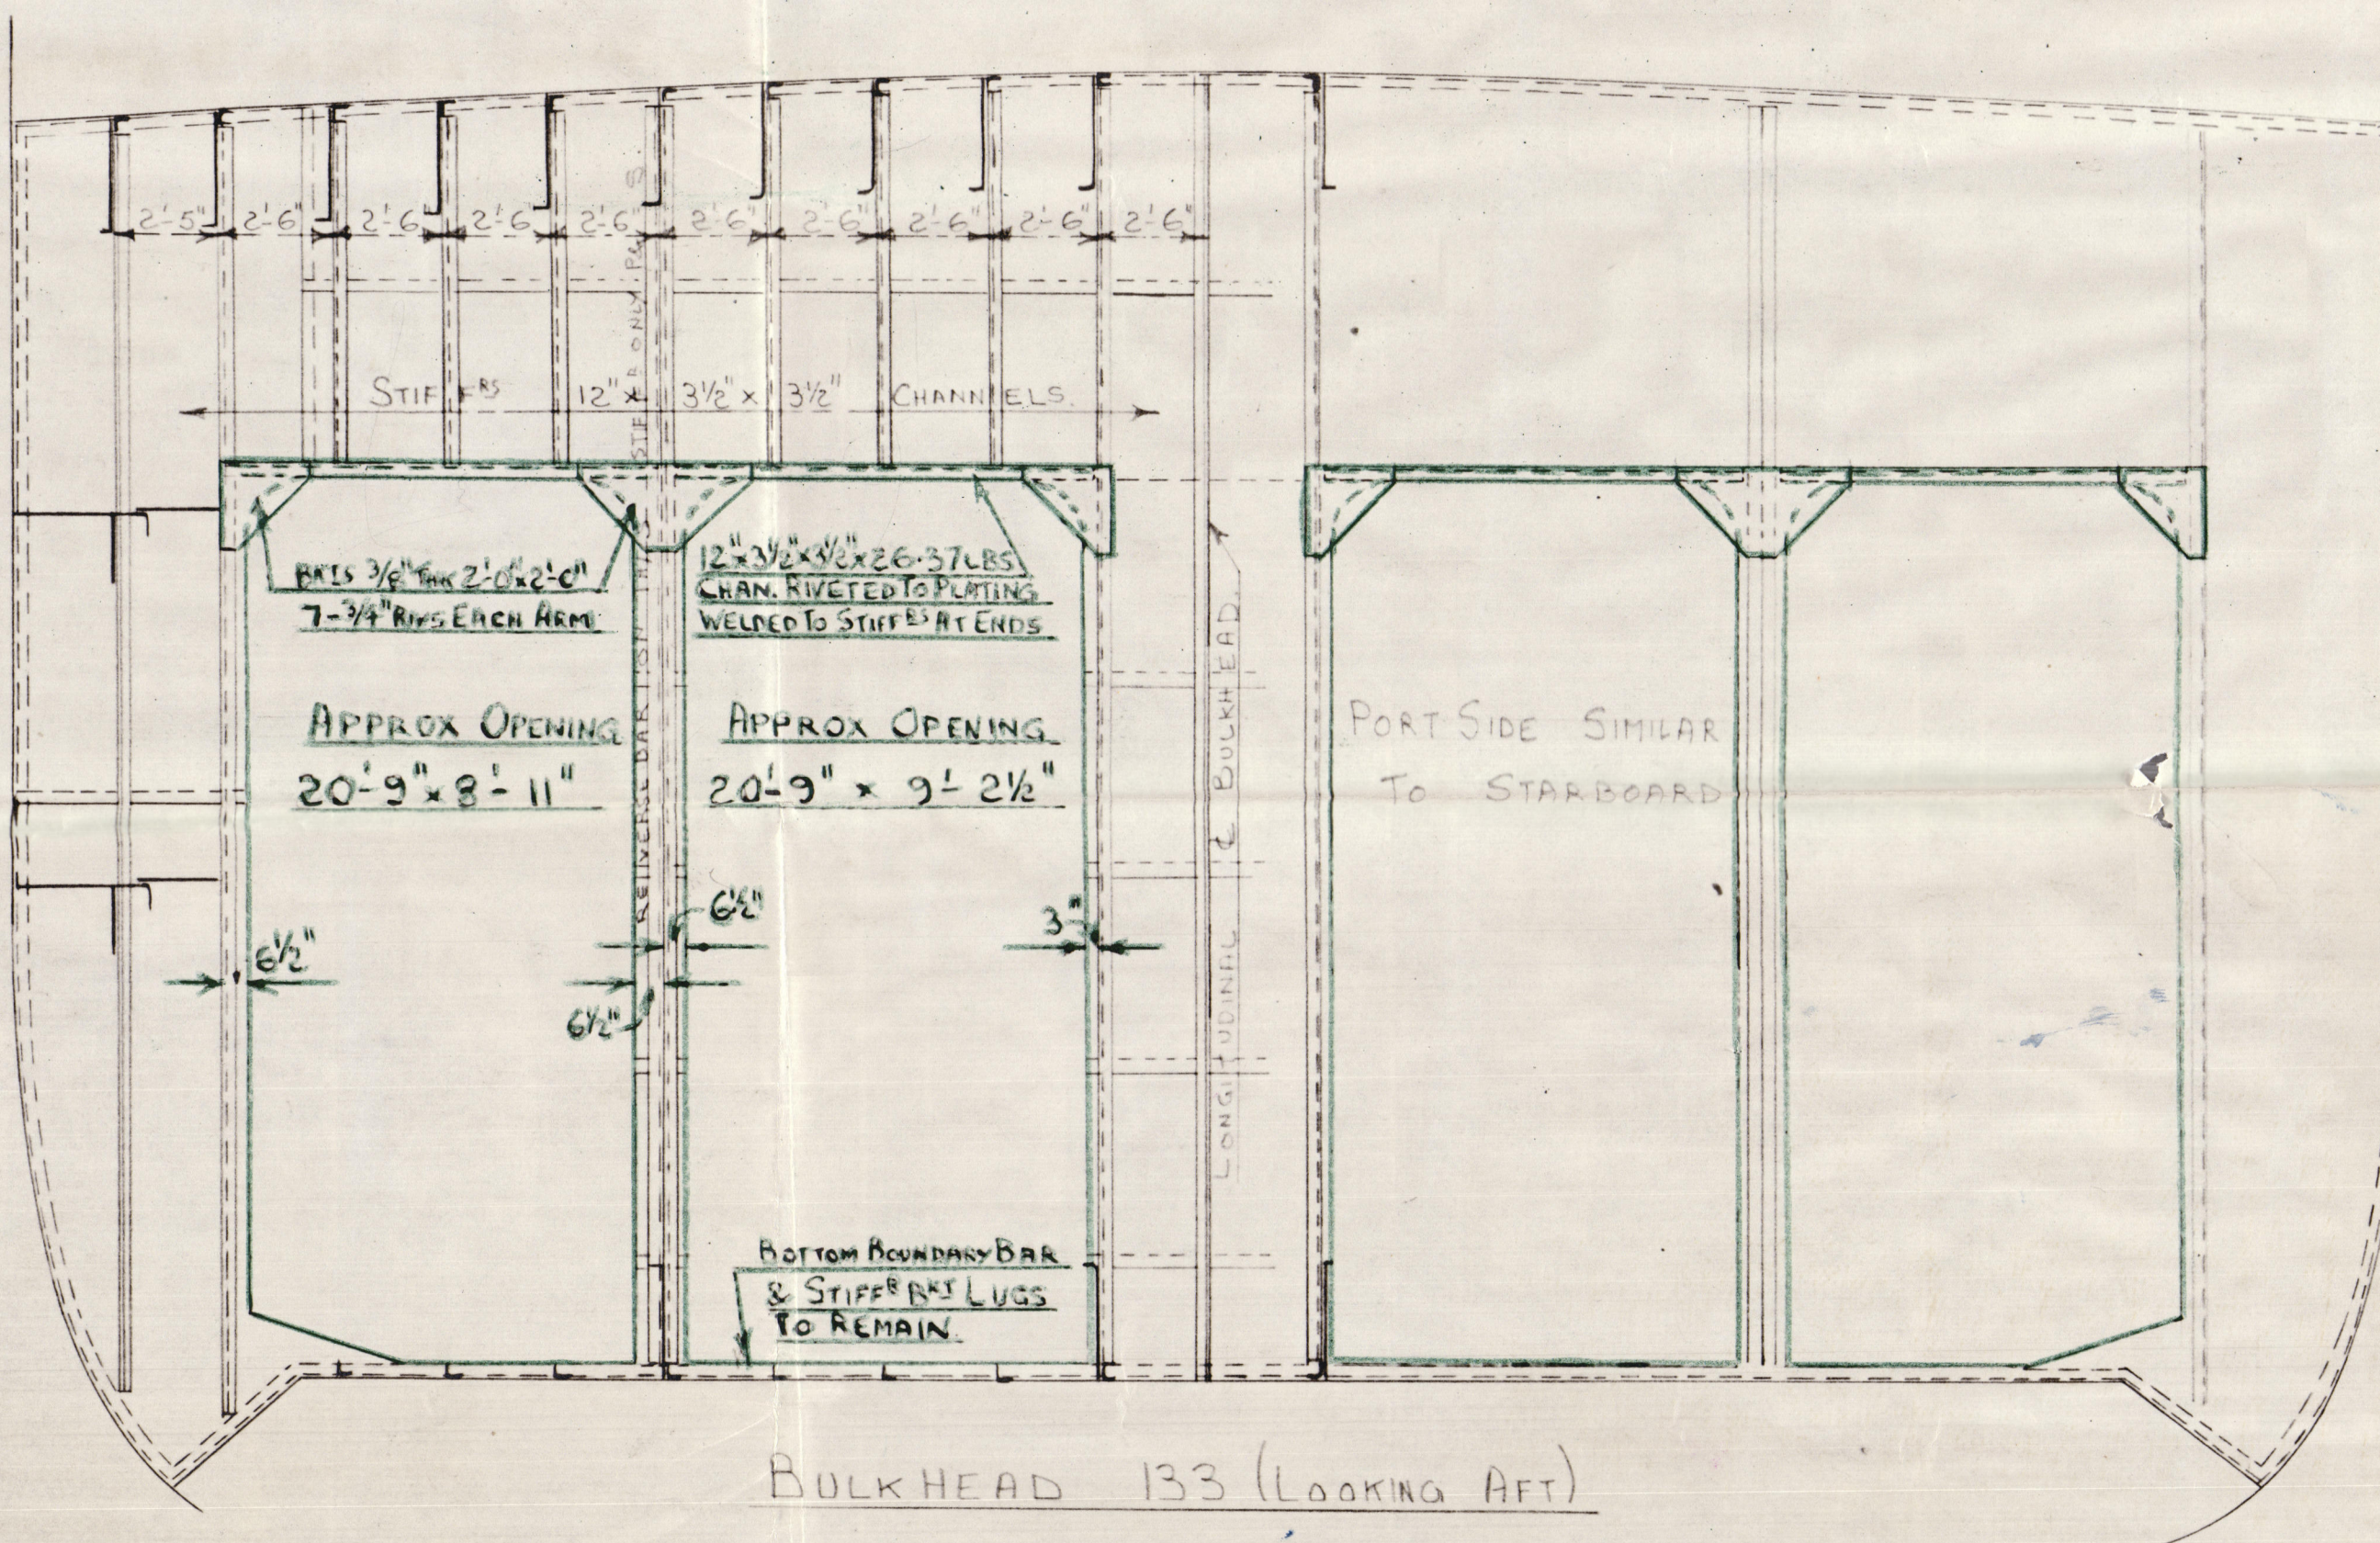

HEIGHT OF BULKHEAD

TANK TOP TO DK AT CR 30 FT

Handwritten signature
3/5/54



S.S. "SAN ANTONIO" (EX HARTBRIDGE)

PROPOSED OPENINGS TO BE CUT IN W.T.
BULKHEADS BETWEEN HOLDS NOS 1&2 & 4&5


SCALE: 1/2" = ONE FOOT.

"San Antonio"

Repl no. CFF. 58851

Proposed opening to be cut
in W.T. blocks between tracks 1 & 2
& 4 & 5

003487-003494-0075

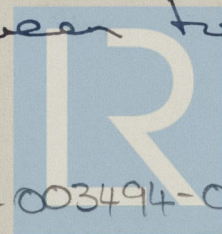

© 2020
Lloyd's Register
Foundation