
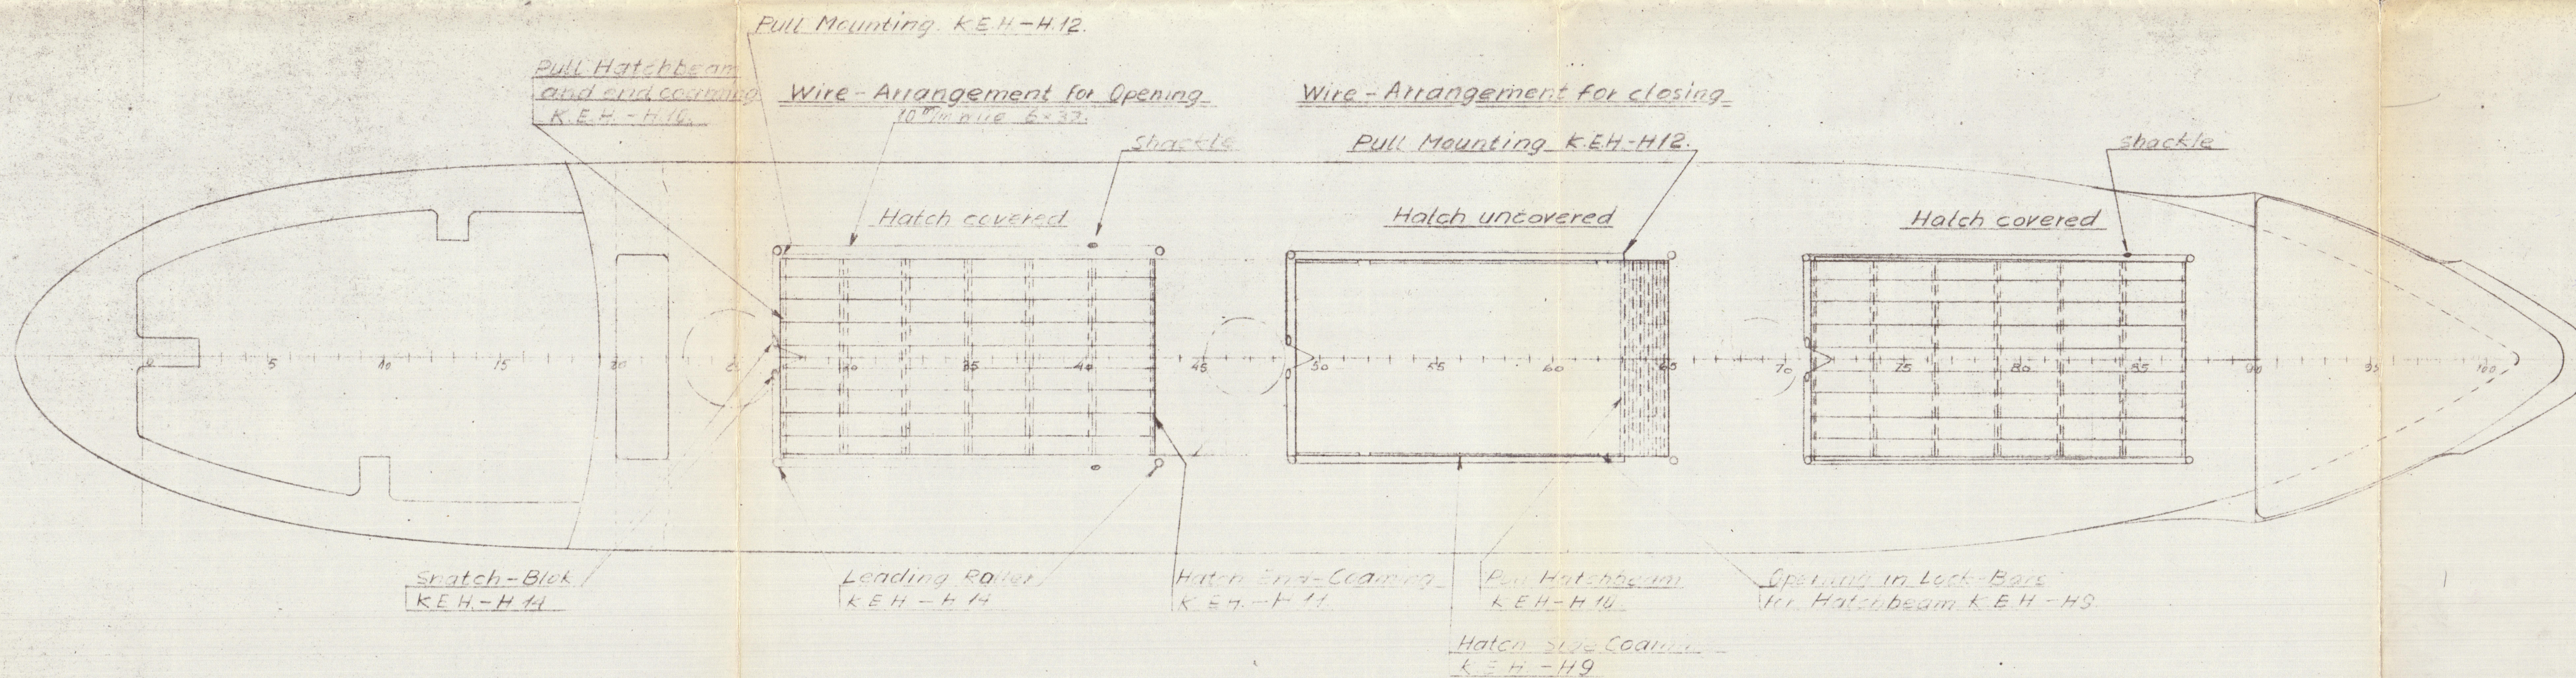


After installation of "Tello" Sliding Hatchcover they are to be operated in accordance with the class.

The Hatches are to be secured as required by the class.

locking bar
or wire rope lashings

Operating Test to be witnessed by L.R.-Surveyors

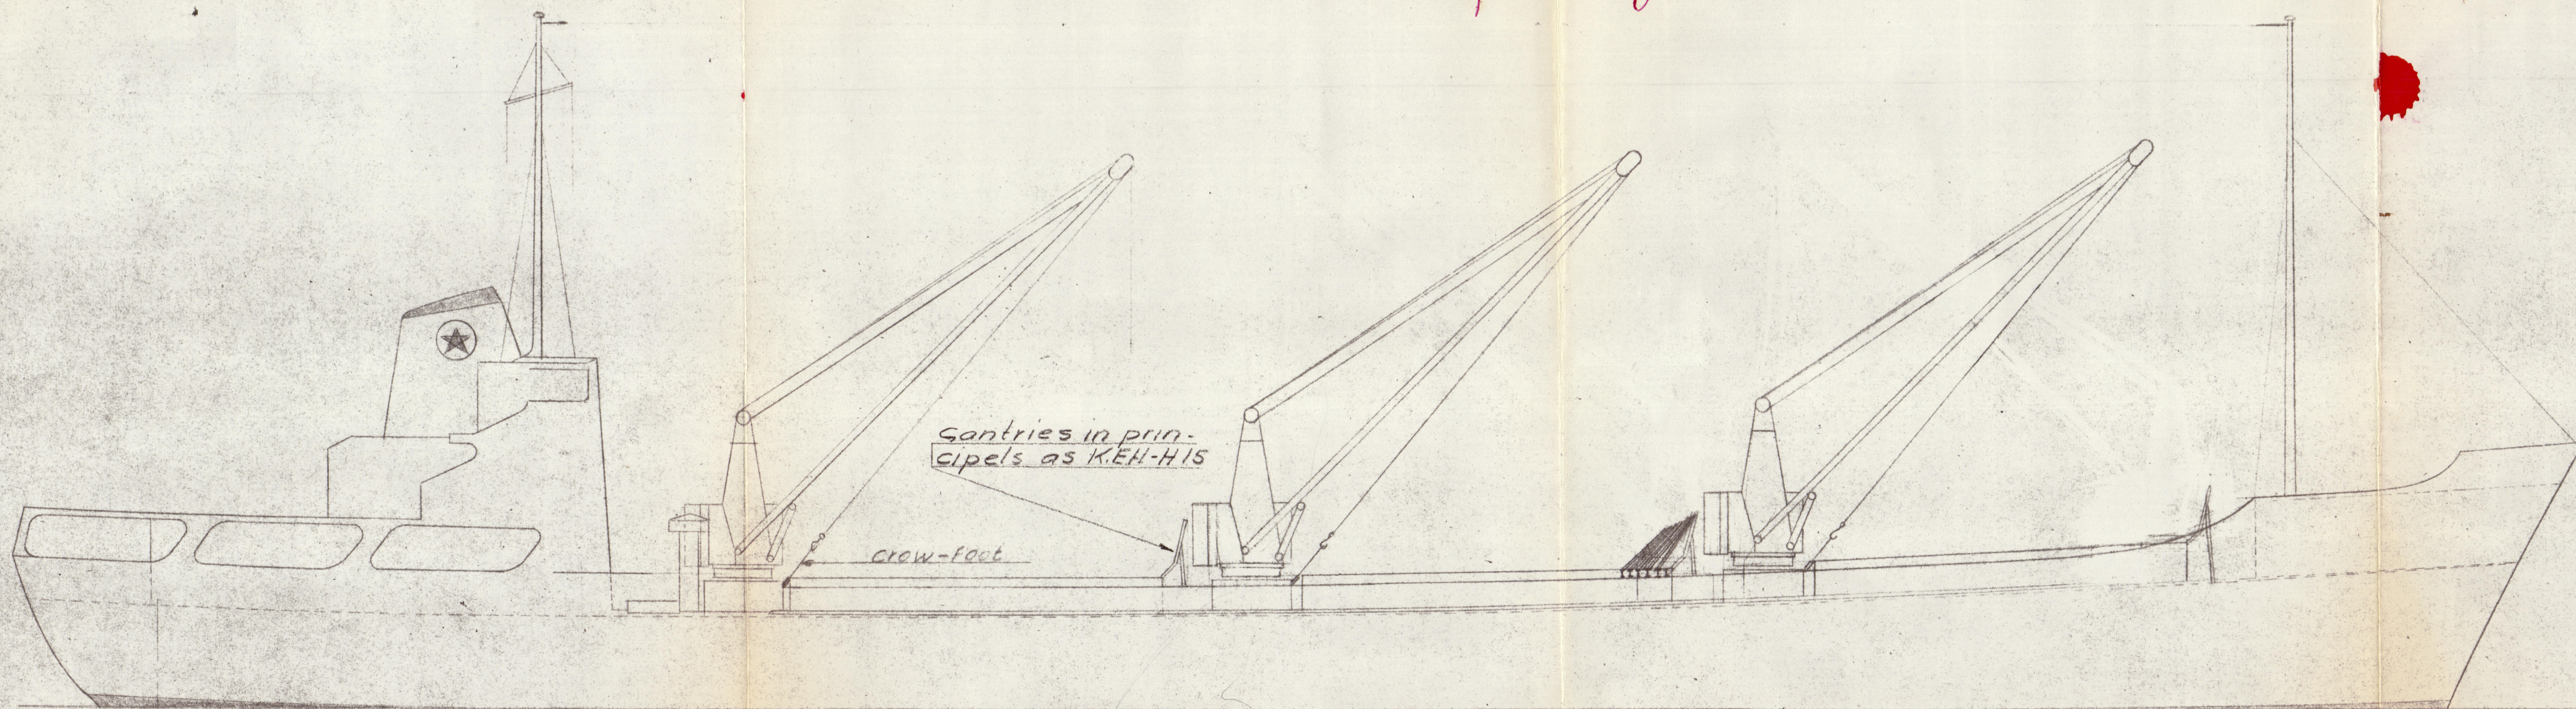

22.1655
39.3709
61.5399

2.48

OFFICE

12
2.7.57

OFFICE SHIPPING AGENCIES

Lloyd's Register

Ken 5602-4A Arkiv

L20-161500-18700