


12/9/27

DETAIL OF GUDGEONS
SCALE: 3 INS = 1 FOOT
BOTTOM GUDGEON BEARING TO RULE

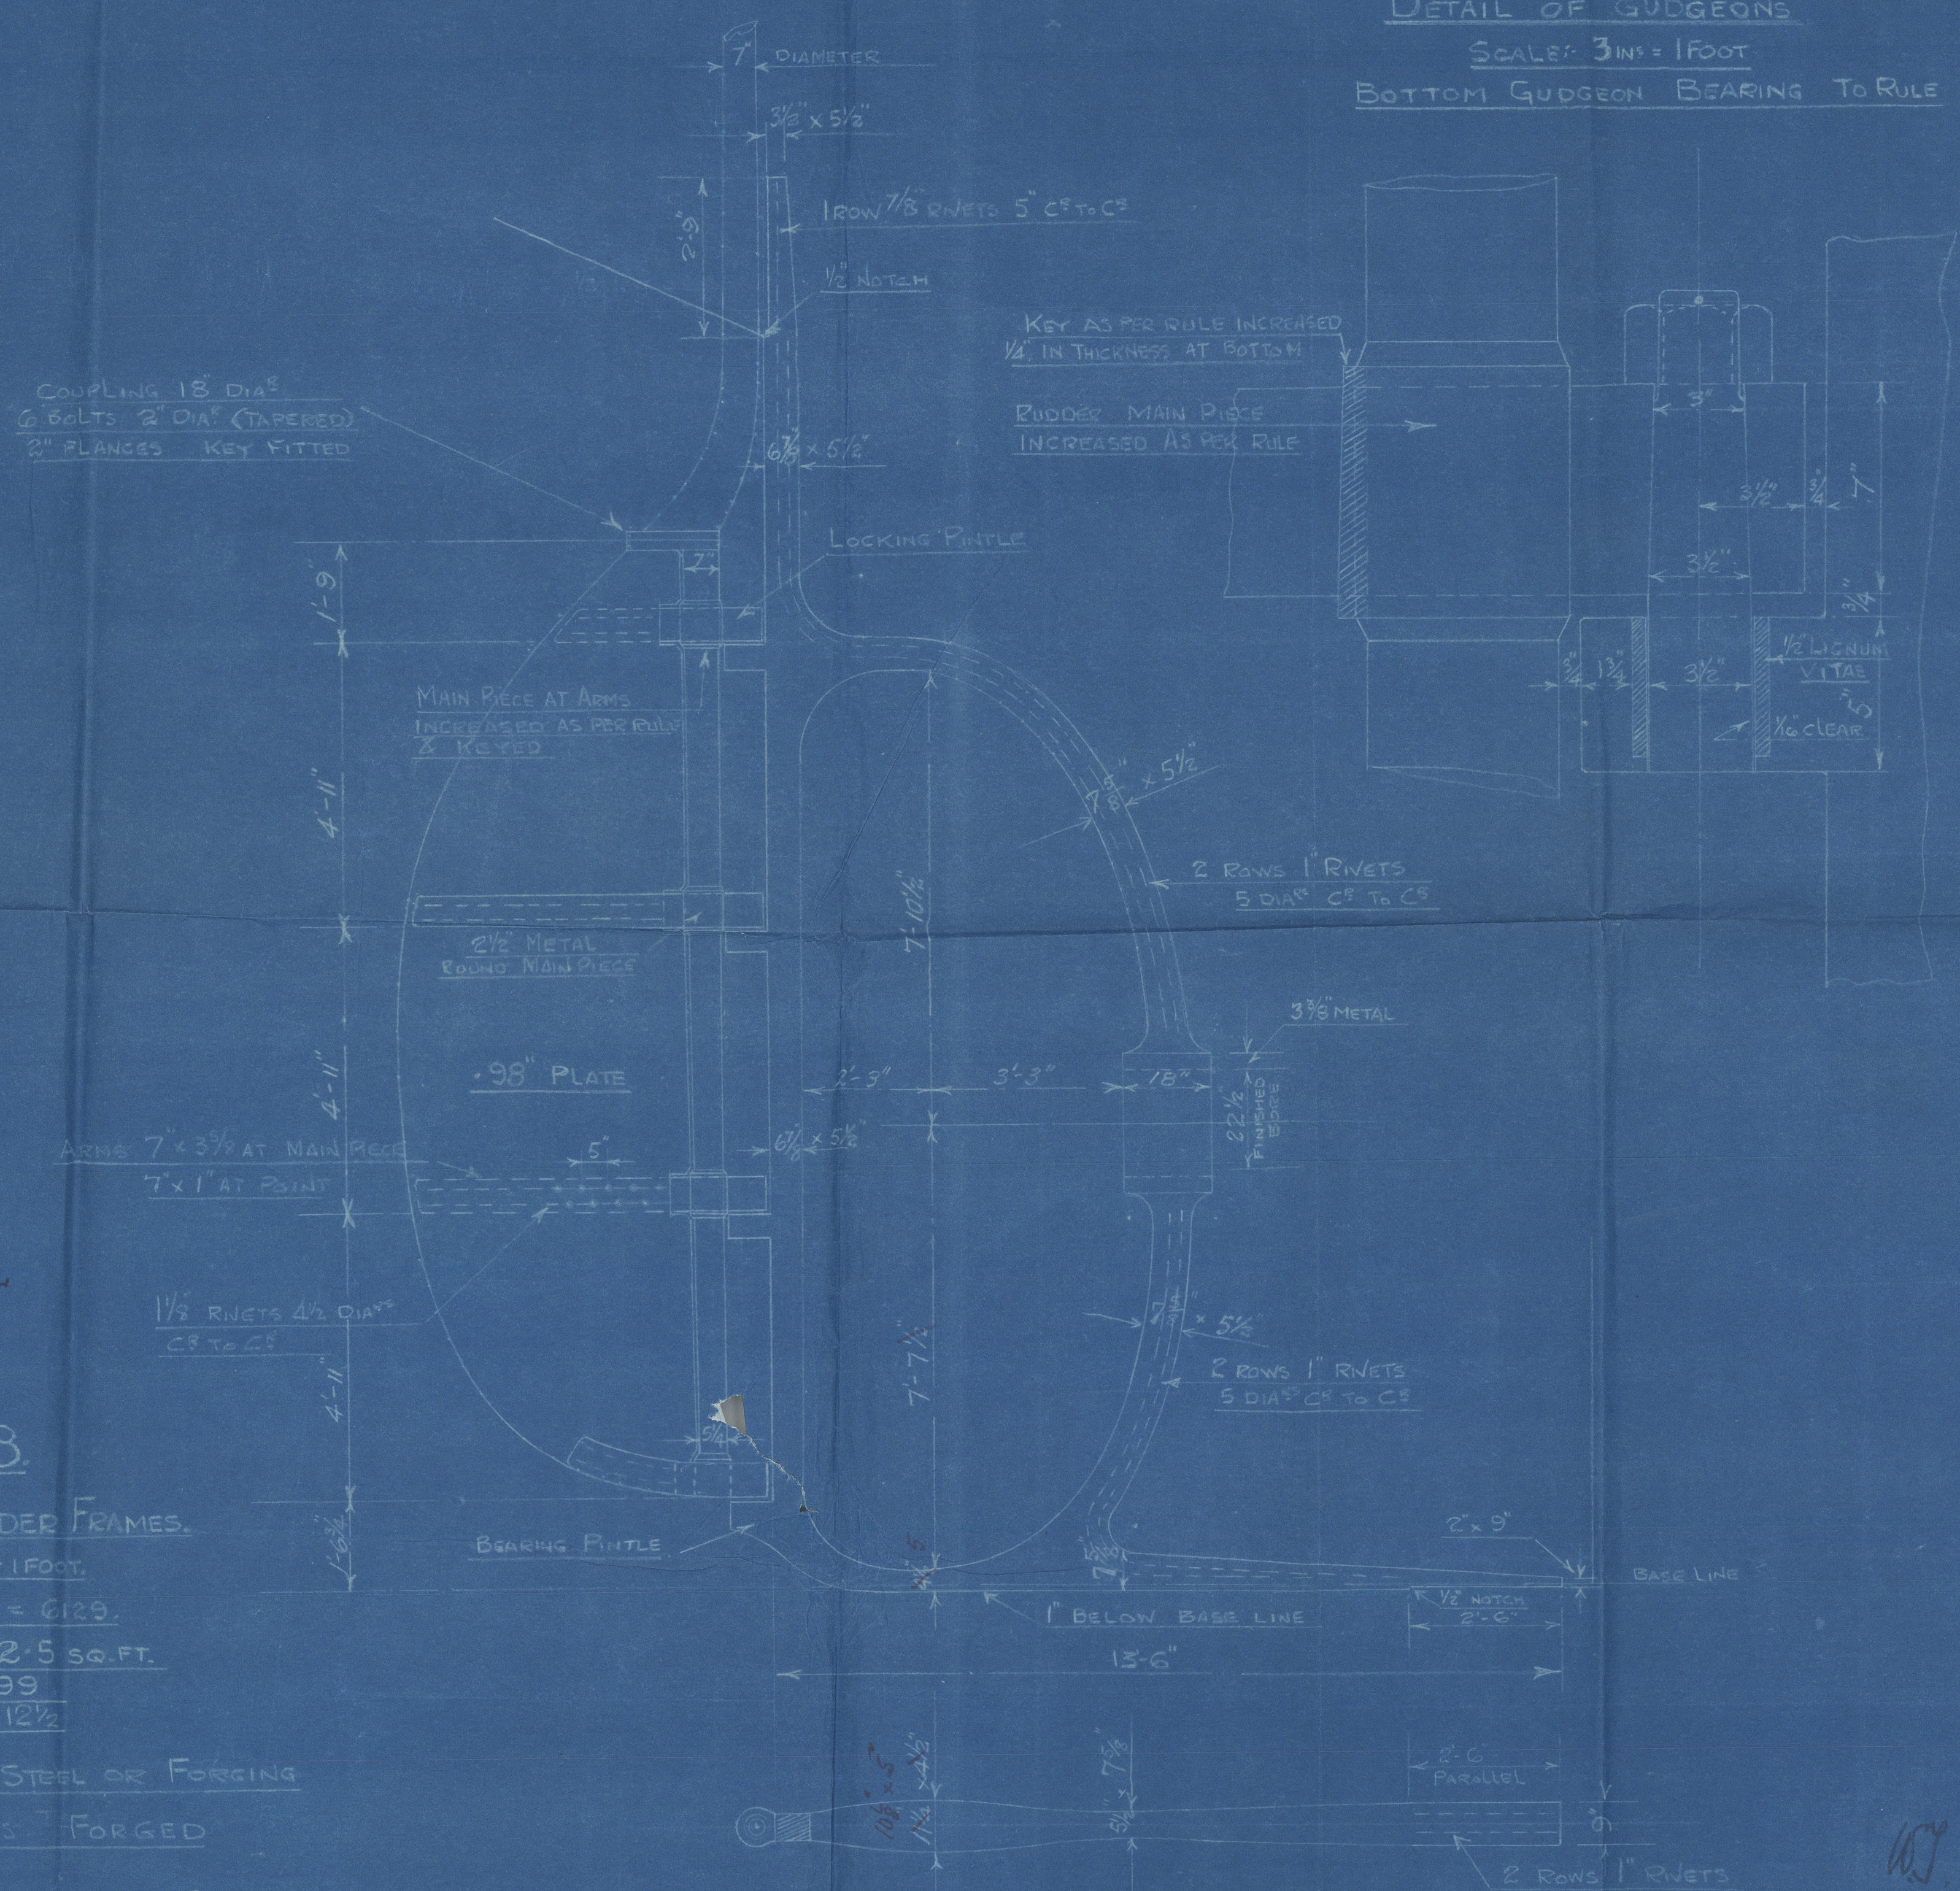

ENCLOSURE
NO. 10
REGISTERED

35173.
SHAW, MURPHY & WATSON ENGINEERS
21-9-27.
NEPTUNE WORKS
WALKER

N^o 1268.

STERN AND RUDDER FRAMES.
SCALE 1/2 IN = 1 FOOT.

LONGITUDINAL NUMBER = 6129.
RUDDER AREA = 72.5 SQ. FT.
A x D = 199
SPEED IN KNOTS = 12 1/2

STERN FRAME OF CAST STEEL OR FORGING
RUDDER FRAME AND ARMS FORGED

TOLLOYS SURVEY & TESTS.



1268

Stem frame & rudder

003495-003502-0070



© 2020

Lloyd's Register
Foundation

Swan Hunter's N^o 1268

Stern frame & Rudder

③

See later plan
for Rudder

S.S. "Alnwick"
NEWCASTLE ON TYNE.

Report No. 82605.



© 2020

Lloyd's Register
Foundation

003495-003502-0070