

<u>DIMENSIONS</u>	
LENGTH BP	420'-0"
BREADTH M ^{LD}	54'-8"
DEPTH M ^{LC}	30'-6"

S.S. N^{os} 664-5.
PROFILE & DECKS.

Round. Palars in center
under Hatch and beams
to have flat heads. heels.
41-45 to be submitted







1854 ✓

SIR JAMES LAING & SONS, LTD.
Date 13.7.16
DRAWN
No.
DEPTFORD

Per J. Lang & Sons

No 664 and 665

Profile & Plan Plans

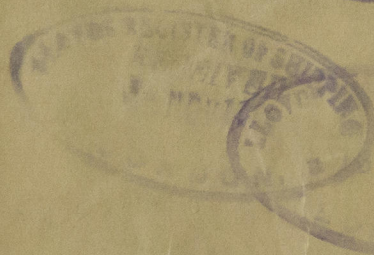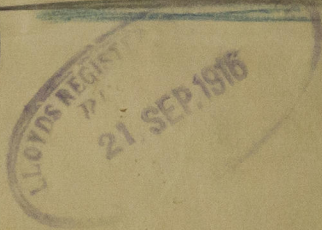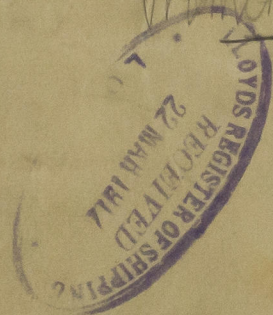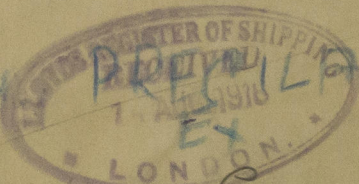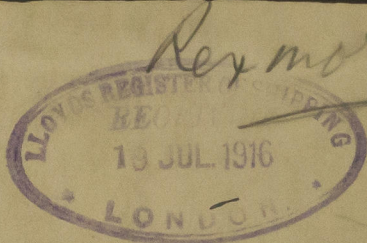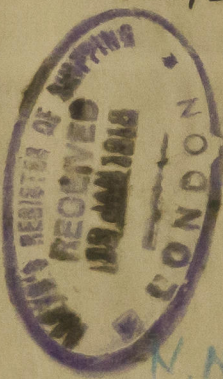

664 "Resmore"


SUNDERLAND RPT. NO. 27280

665 "Barrymore"

SUNDERLAND RPT. NO. 27797

MANCHESTER Exporters
PRECILLA

003495 - 003502

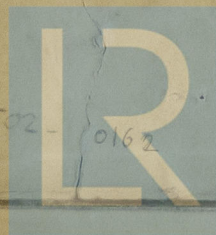

© 2020

Lloyd's Register
Foundation