

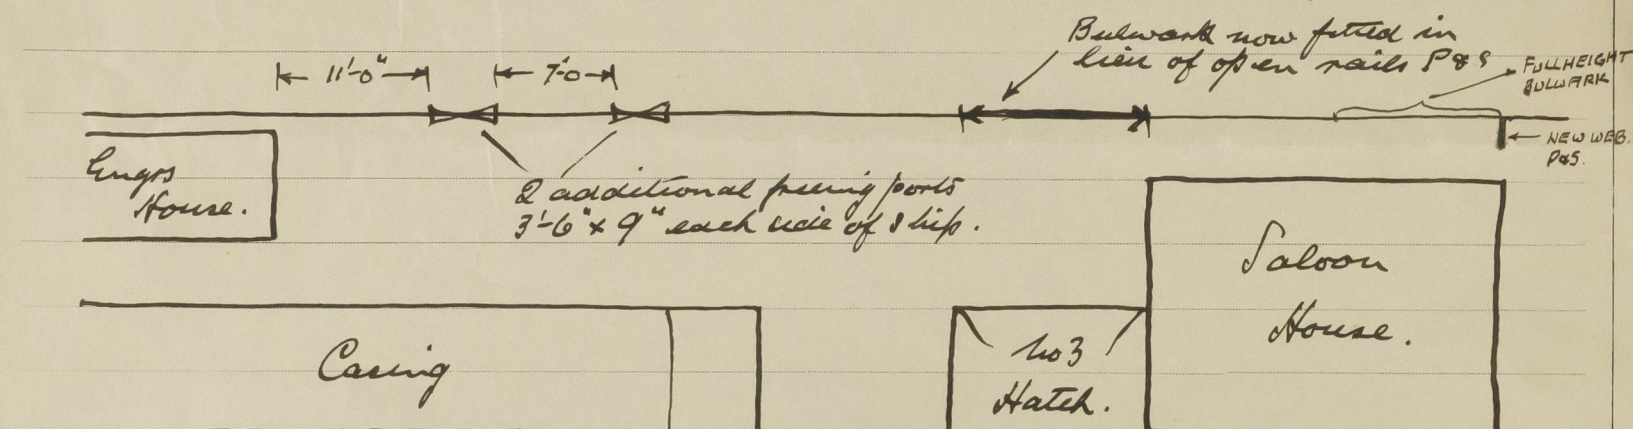
23 JAN 1943

25906

## Lloyd's Register of Shipping.

Ship's Name *S.S. Manchester Exporter*Official No. *140,584.*

Memorandum of alterations reported since ship was surveyed for assignment of Load Lines  
in *June 1941.*

Plan-Plan at Shelter Deck.

Noted

25 JAN 1943