
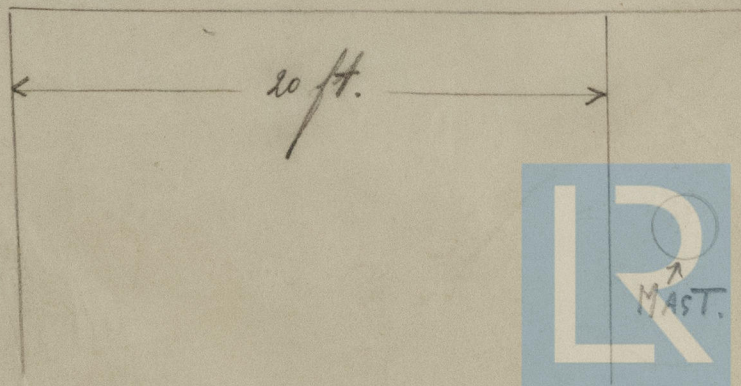


Ant. Aft. 27565.

ALTERATION "STIENTJE MENSINGA".

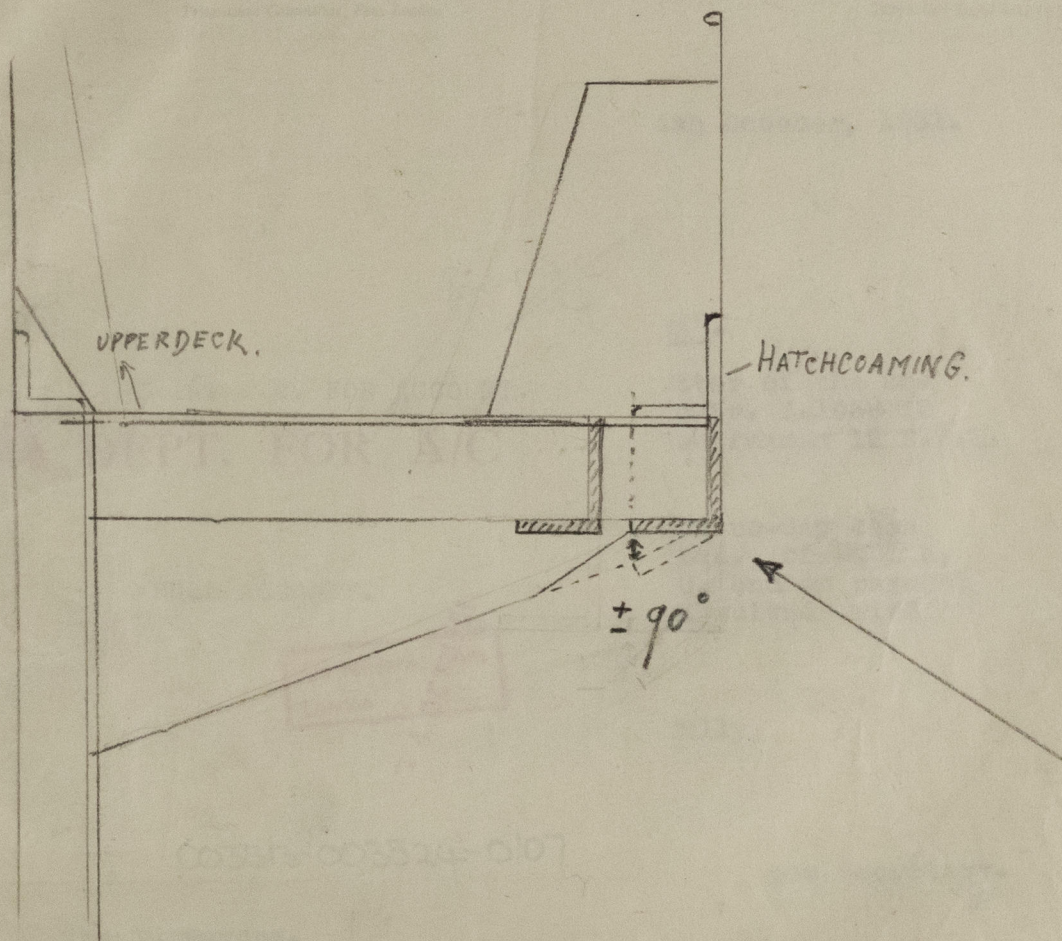

© 2020

Lloyd's Register
Foundation

003513-003524-0106

003513-003524-0110