






— WHYALLA F.E. RPT No 24 —

S.S. RIVER DERWENT

B.H.P. CO No 5

MIDSHIP SECTION

AS BUILT

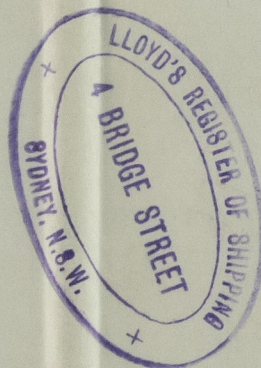

003525-003532-0056



© 2020

Lloyd's Register  
Foundation