


# PROPOSED DETAIL OF HATCH CORNER.




LAKE STEAMERS.

$\frac{3}{4}" = 1 \text{ FOOT.}$

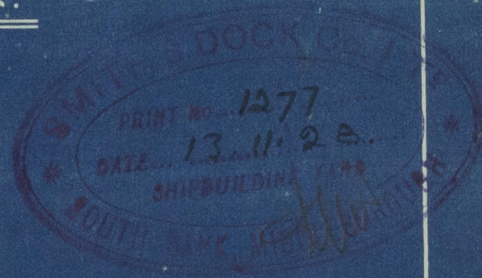

11 28

14 NOV 1928

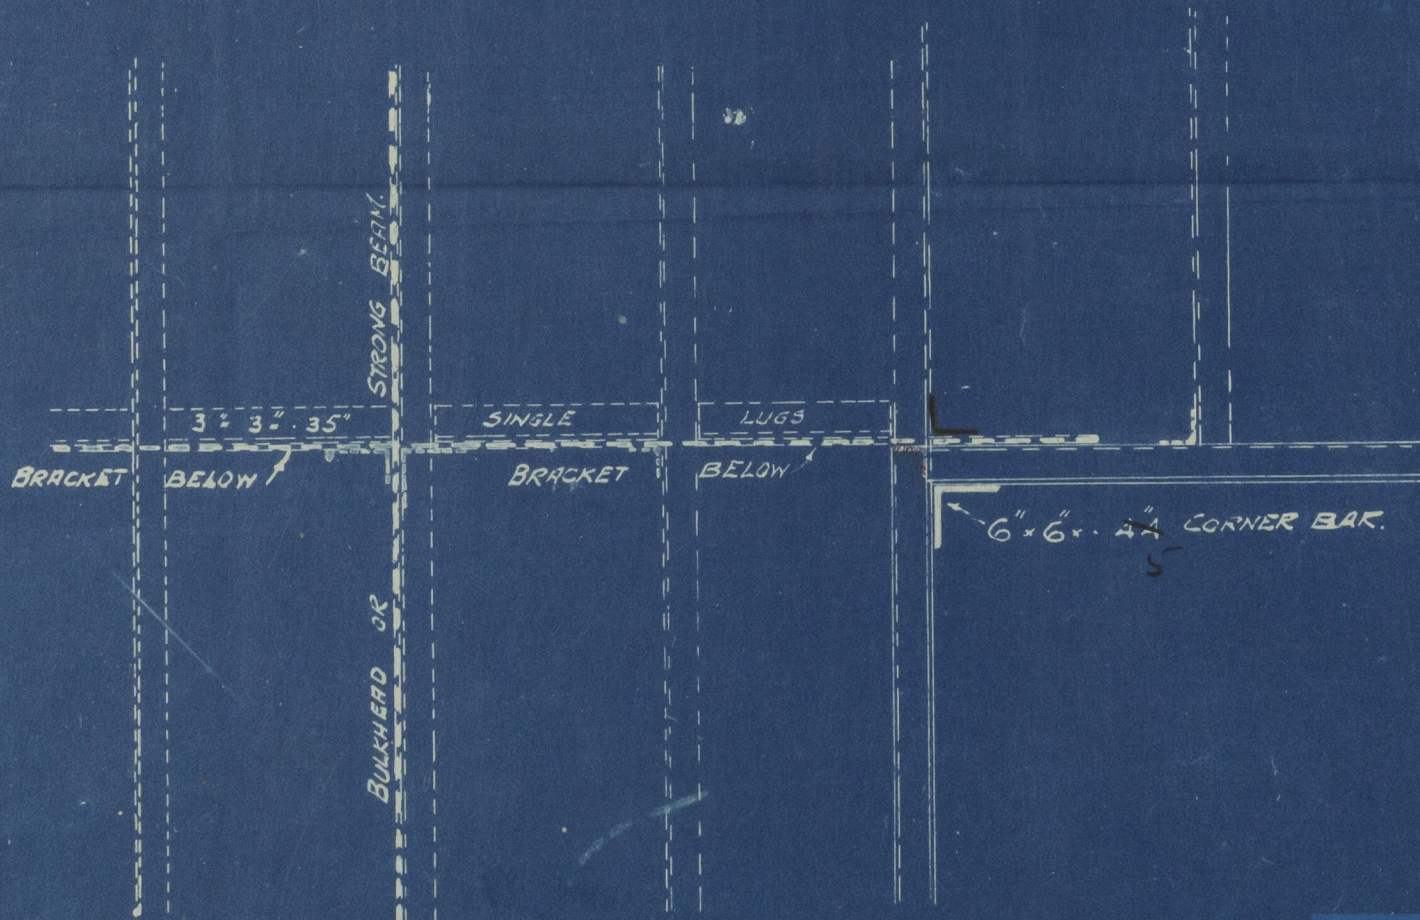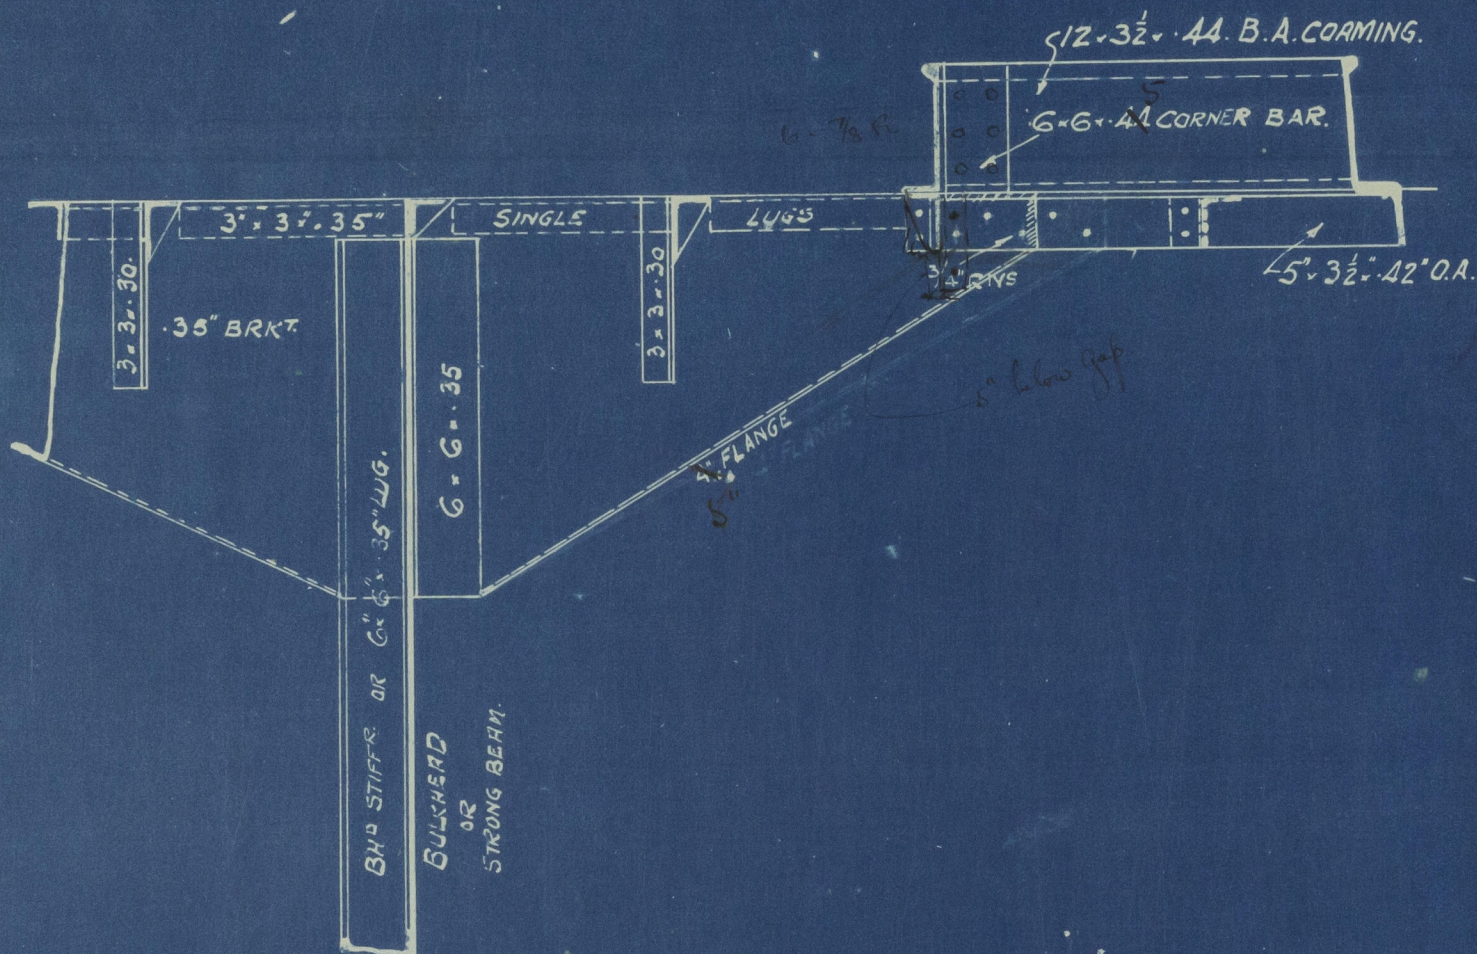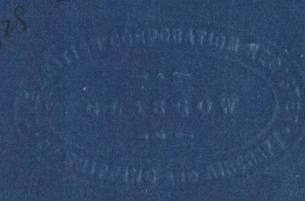

MISSRS SMITHS DOCK CO LTD.

SHIP BUILDERS, & ENGINEERS.

SOUTH BANK - ON-TEES.



Lloyd's Register Foundation

003535-003532-0110

1  
Prop. Detail of Hatch Corners.

Smith's Dock Co. Ltd.

N<sup>os</sup> 868-9-0-1.

15.11.28.

868. Meadcliffe Hall.

869. George L. Eaton.

870. Seakbay.

871. <sup>ny</sup> Sulton. Now "BROWN BEAVER"

003525-003532-0110



© 2020

Lloyd's Register  
Foundation