


# Lloyd's Register of Shipping.

Ship's Name "OMALA"

Official No.

Memorandum of alterations reported since ship was surveyed for assignment of Load Lines in 1938


Particulars of Freeing Arrangements in Fore Well and W.T. Doors in Forecastle Front.

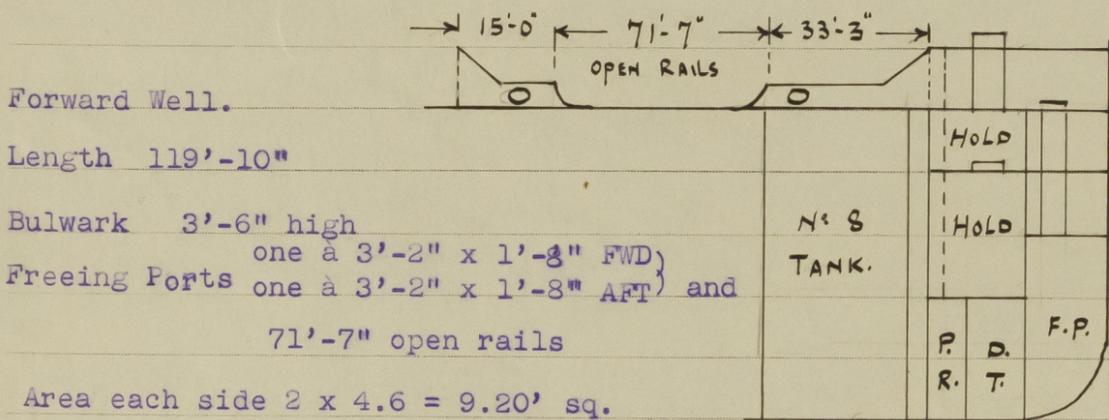

## Freeboard Deck.

Forecastle Bulkhead.

Access to tween deck (Port) and to pump room starboard gained through stairways arranged within the forecastle and substantially steel enclosed.

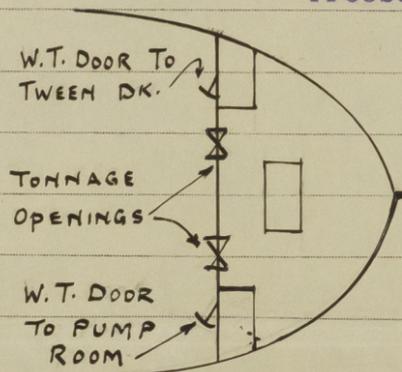

Door openings in Forecastle Bulkhead.

54 1/2" x 30' and 51" x 30' sill 25" closed by W.T. hinged steel doors secured by clips manipulated from both sides.

Two tonnage openings 4'-2" x 3'-2" with 25" sill closed by steel plates with hook bolts.  
 (copy placed on board)

marked. *[Signature]*  
 3 JUN 1947

*[Signature]*



© 2021

Lloyd's Register Foundation