
 


S.S. "JALAKANYA" Cal. reg. No. 14866.  
 SHELL EXPANSION  
 SCALE 1/8" = 1 FOOT

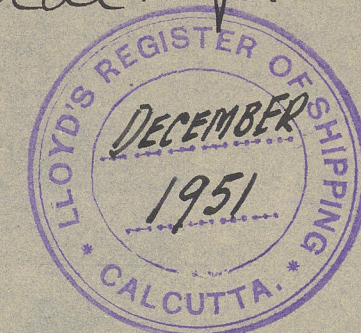

FIP - INDICATE PLATES FAIRED IN PLACE.  
 OFR - OFF & REPLACED.  
 X - RENEWED.