



6/4/96

SCALE $\frac{1}{4}$ = ONE FOOT.

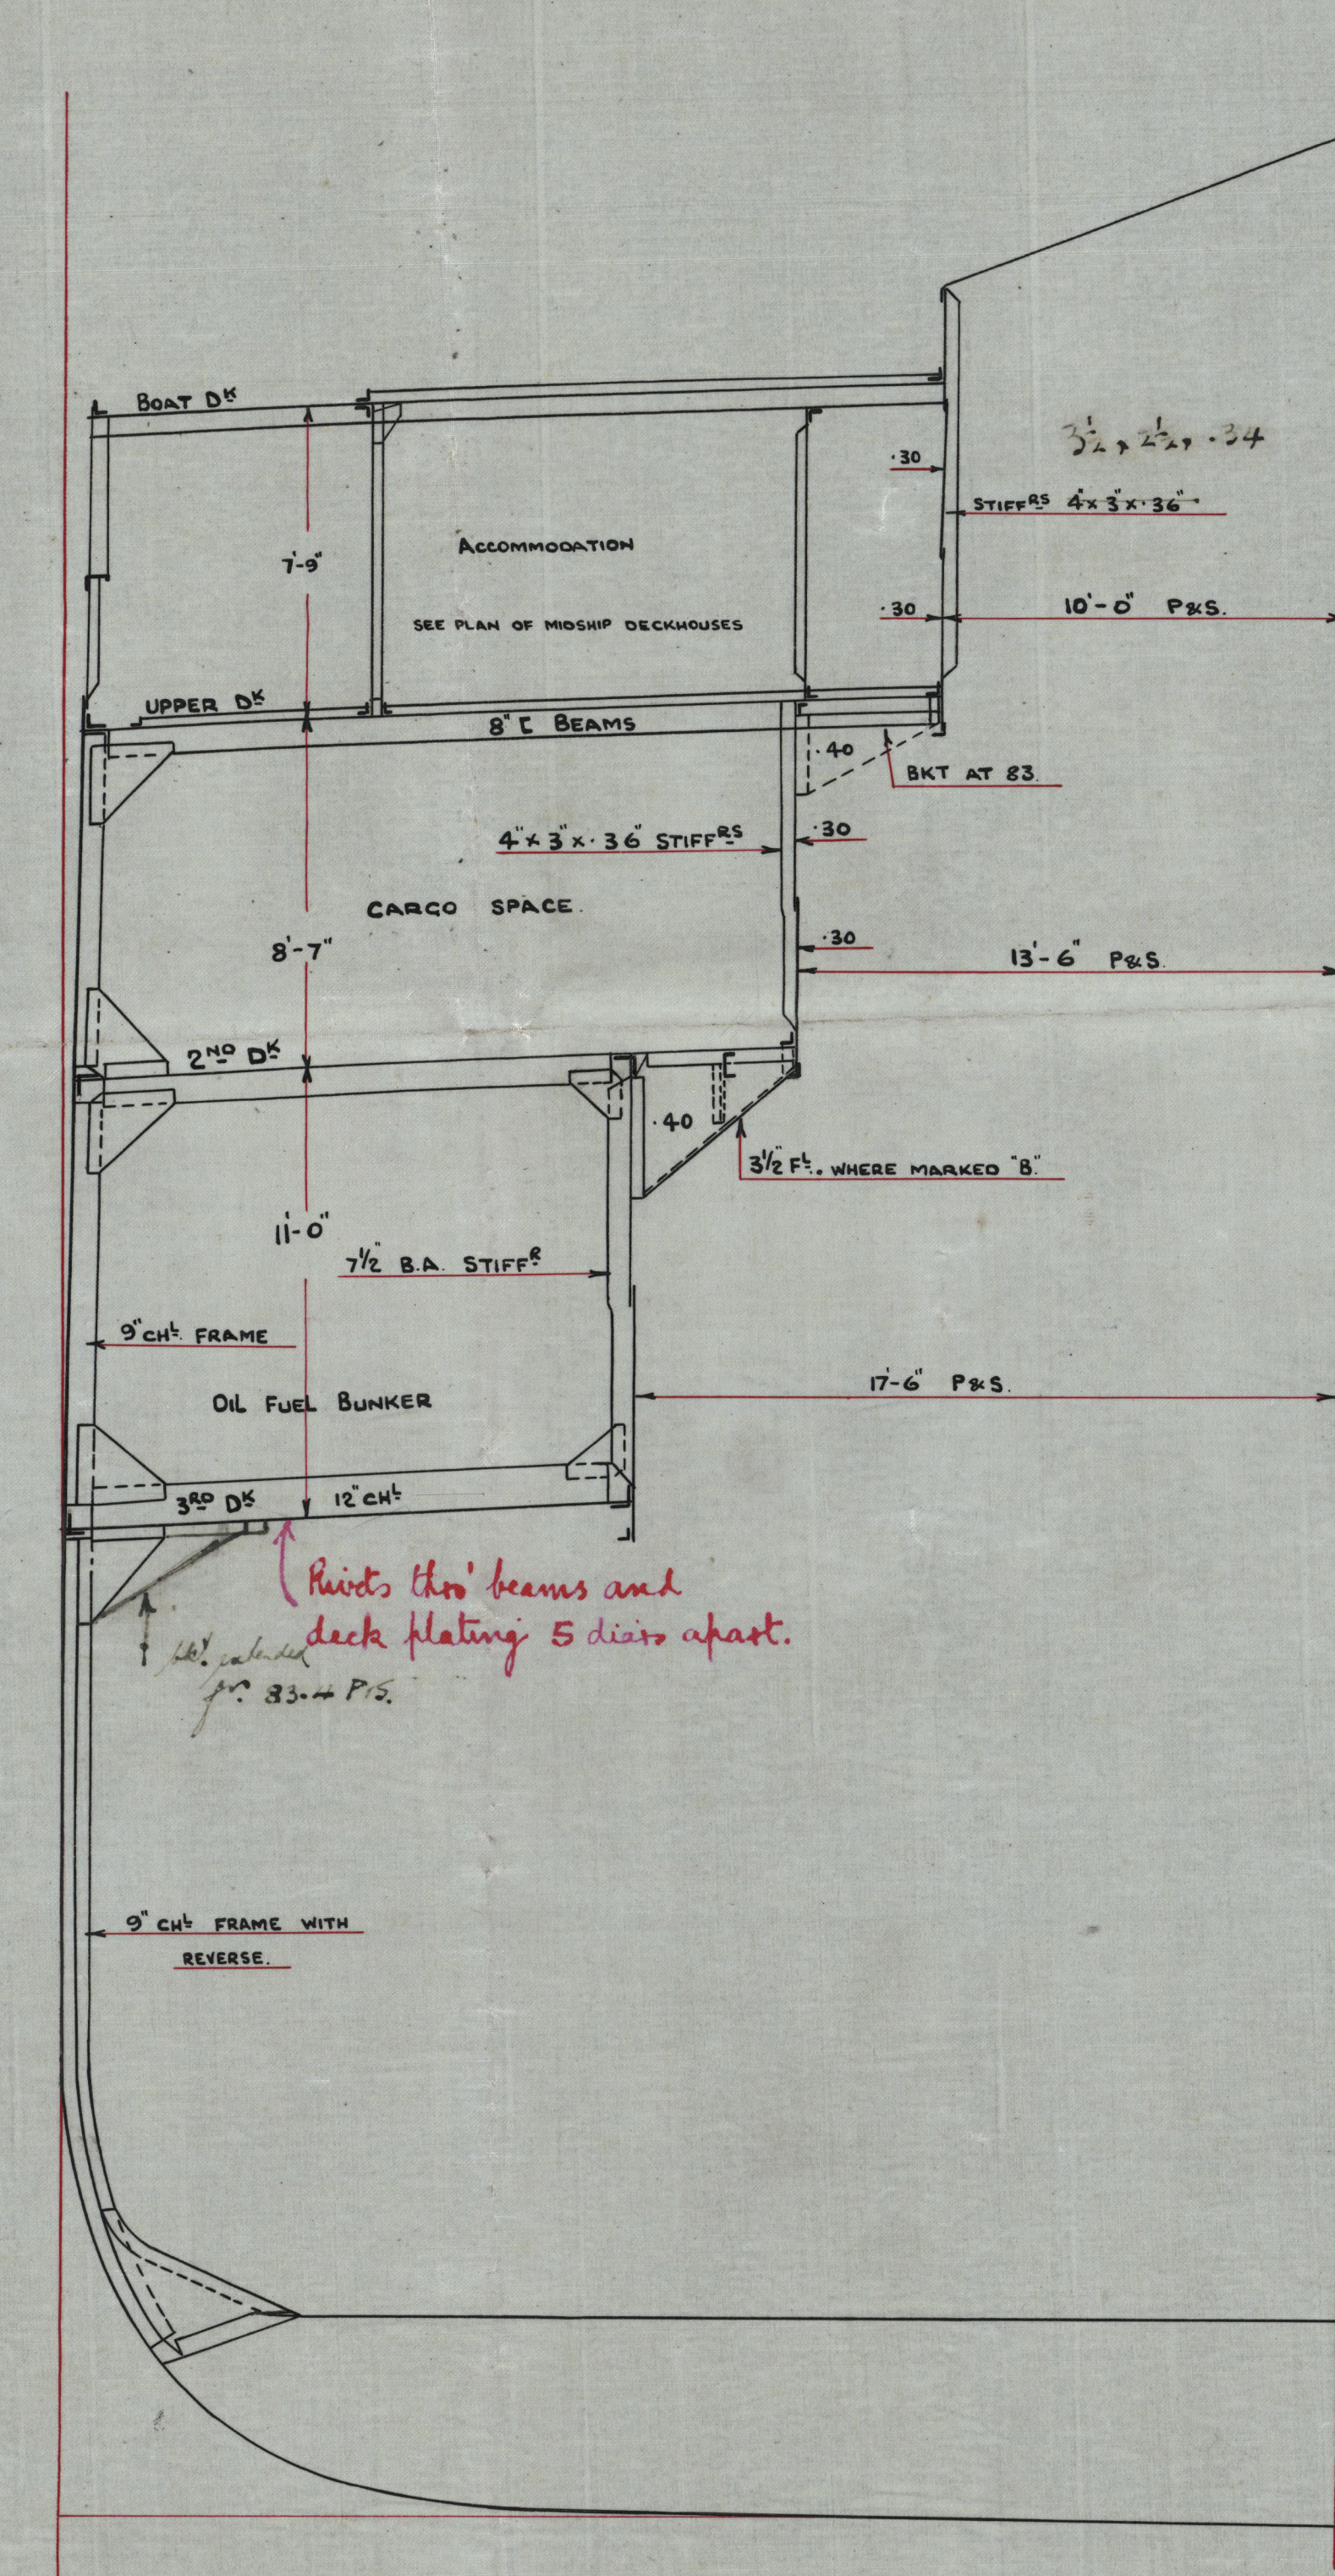

664.
6. 4. 26.

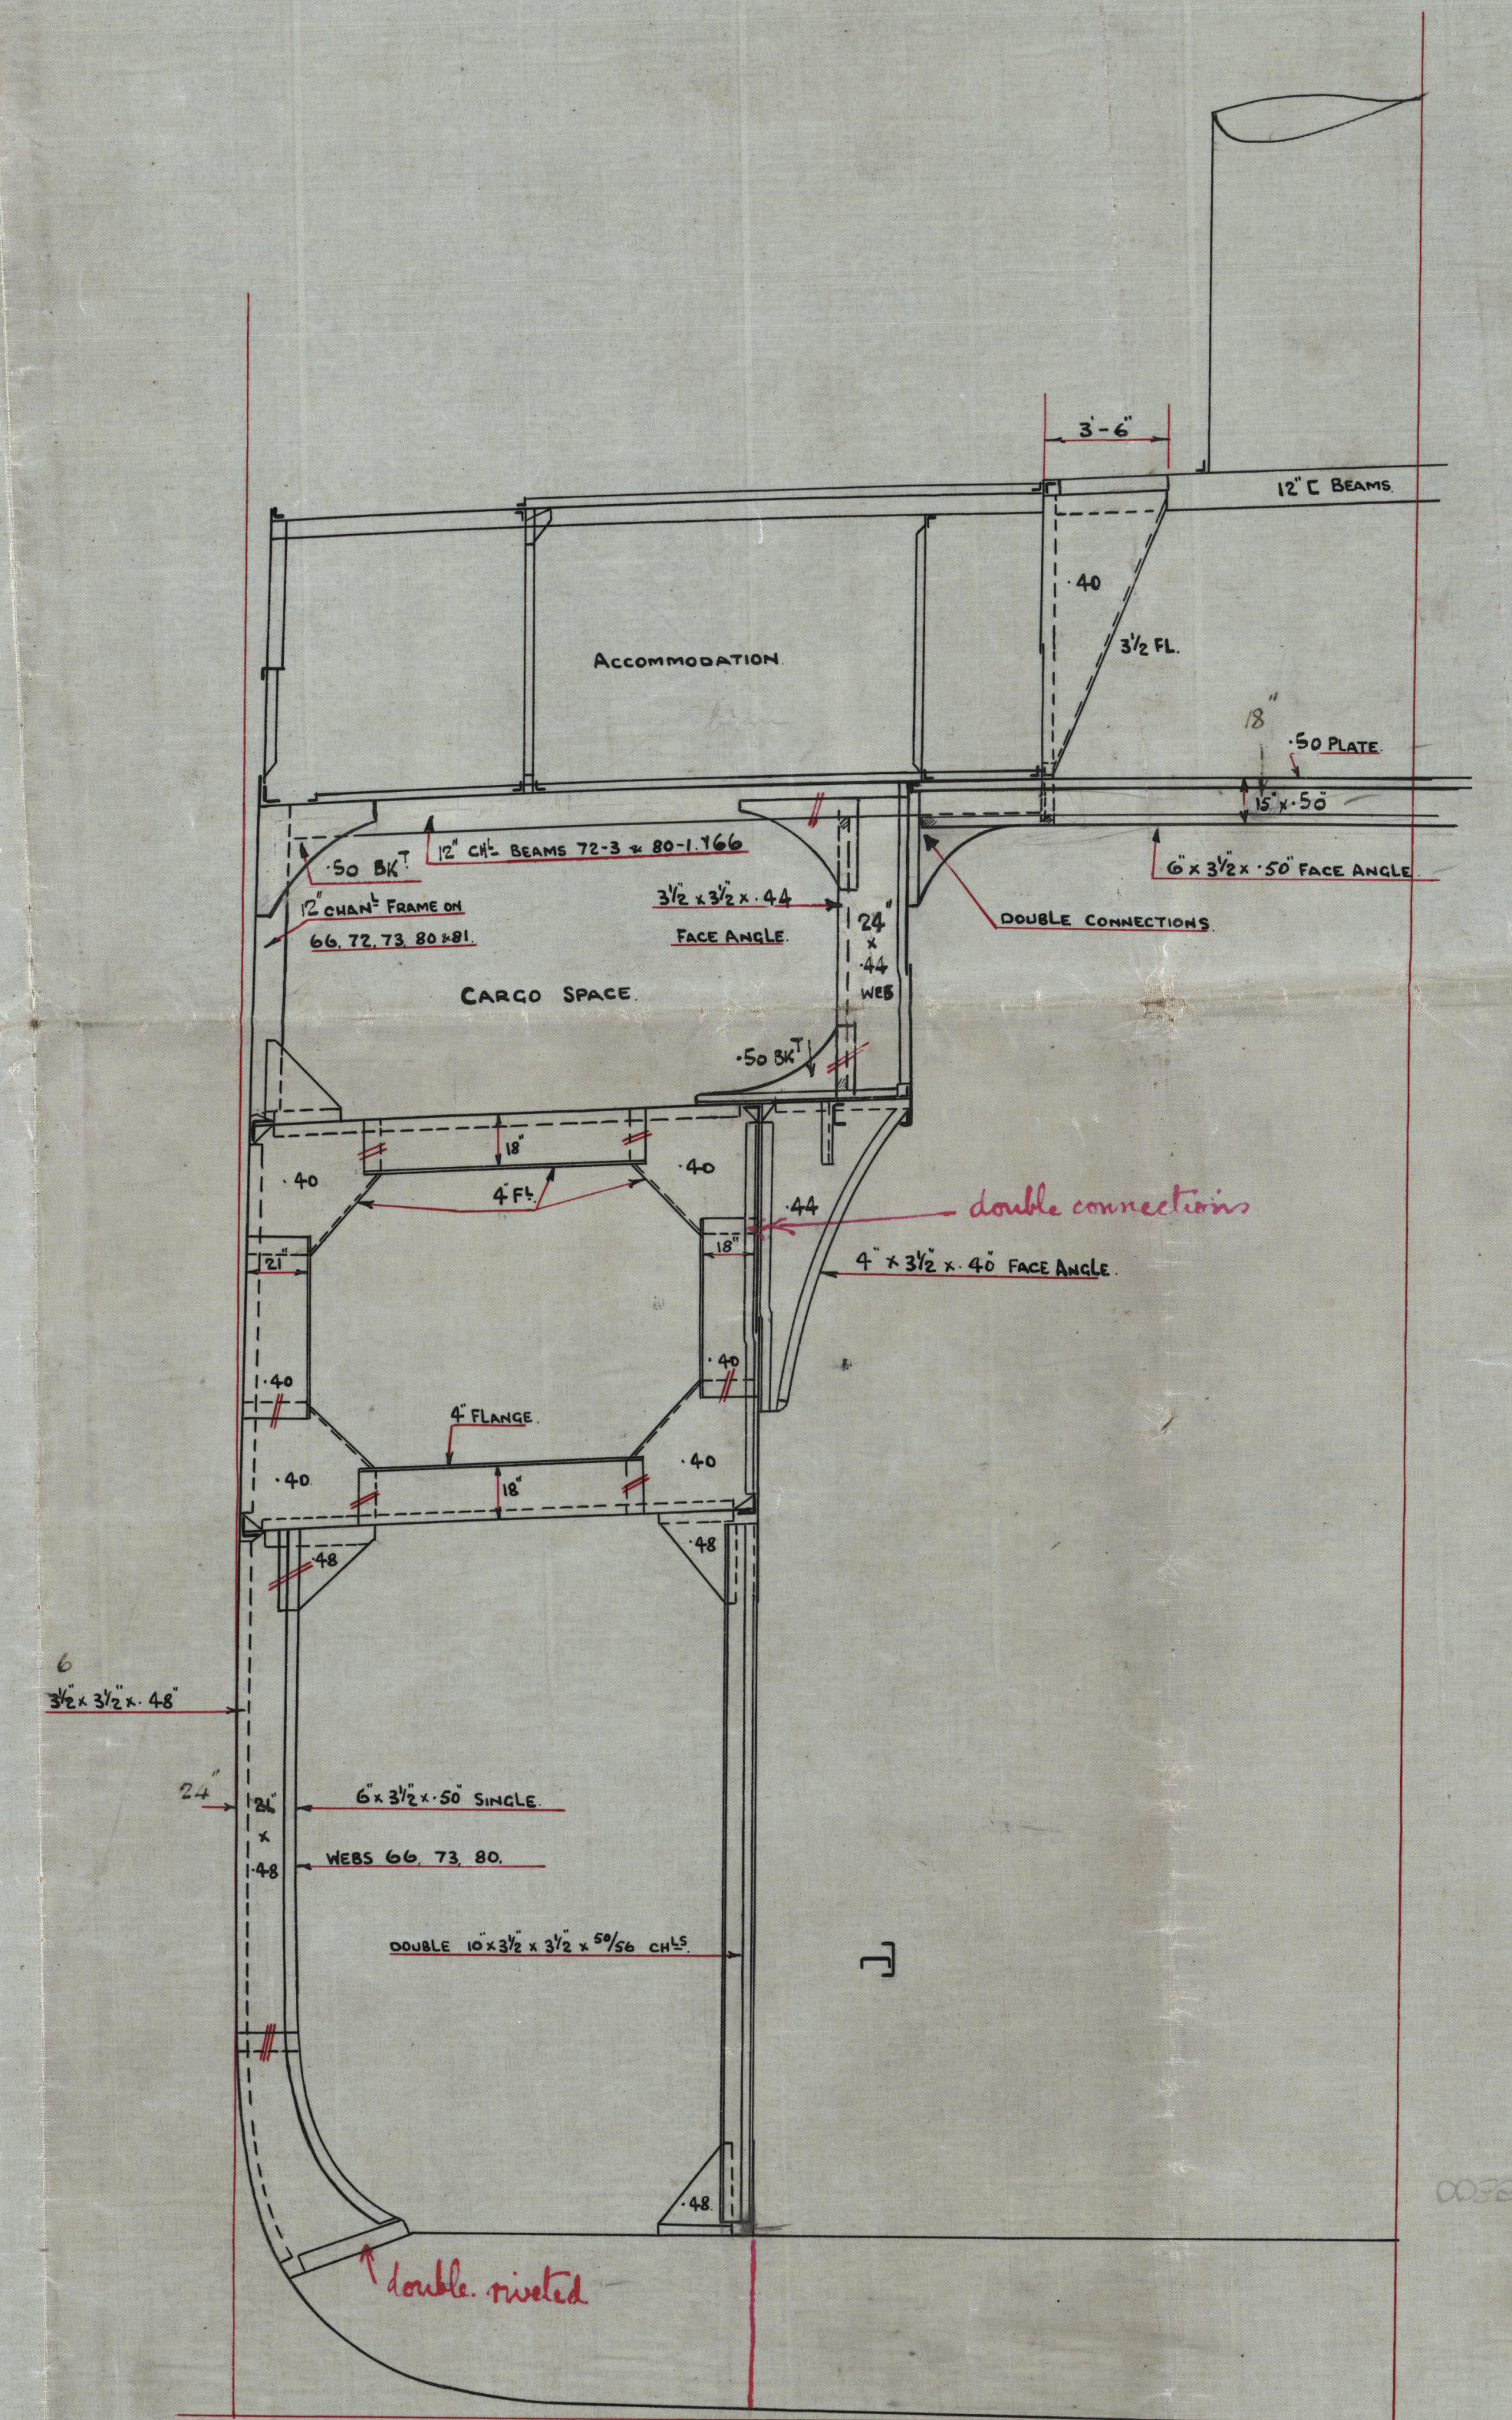

SECTION ABOUT FRAME 80.

15-88-118
Lloyd's Register
Foundation

003549-003555-0094

(18) Construction in
Engine Space

N^o 489

Workman Clark

Belfast

M.V. PORT FREMANTLE

Repl. N^o

003549-003555-0094



© 2020

Lloyd's Register
Foundation