


DIMENSIONS.- 475'-6" x 63'-0" x 43'-4" TO UPPER DK.

SCALE $\frac{1}{2}$ " = ONE FOOT.

TO CLASS 100 A.I. "WITH FREEBOARD" corresponding to a draft not exceeding that contemplated by the Rules for a complete superstructure ship having a tonnage opening.

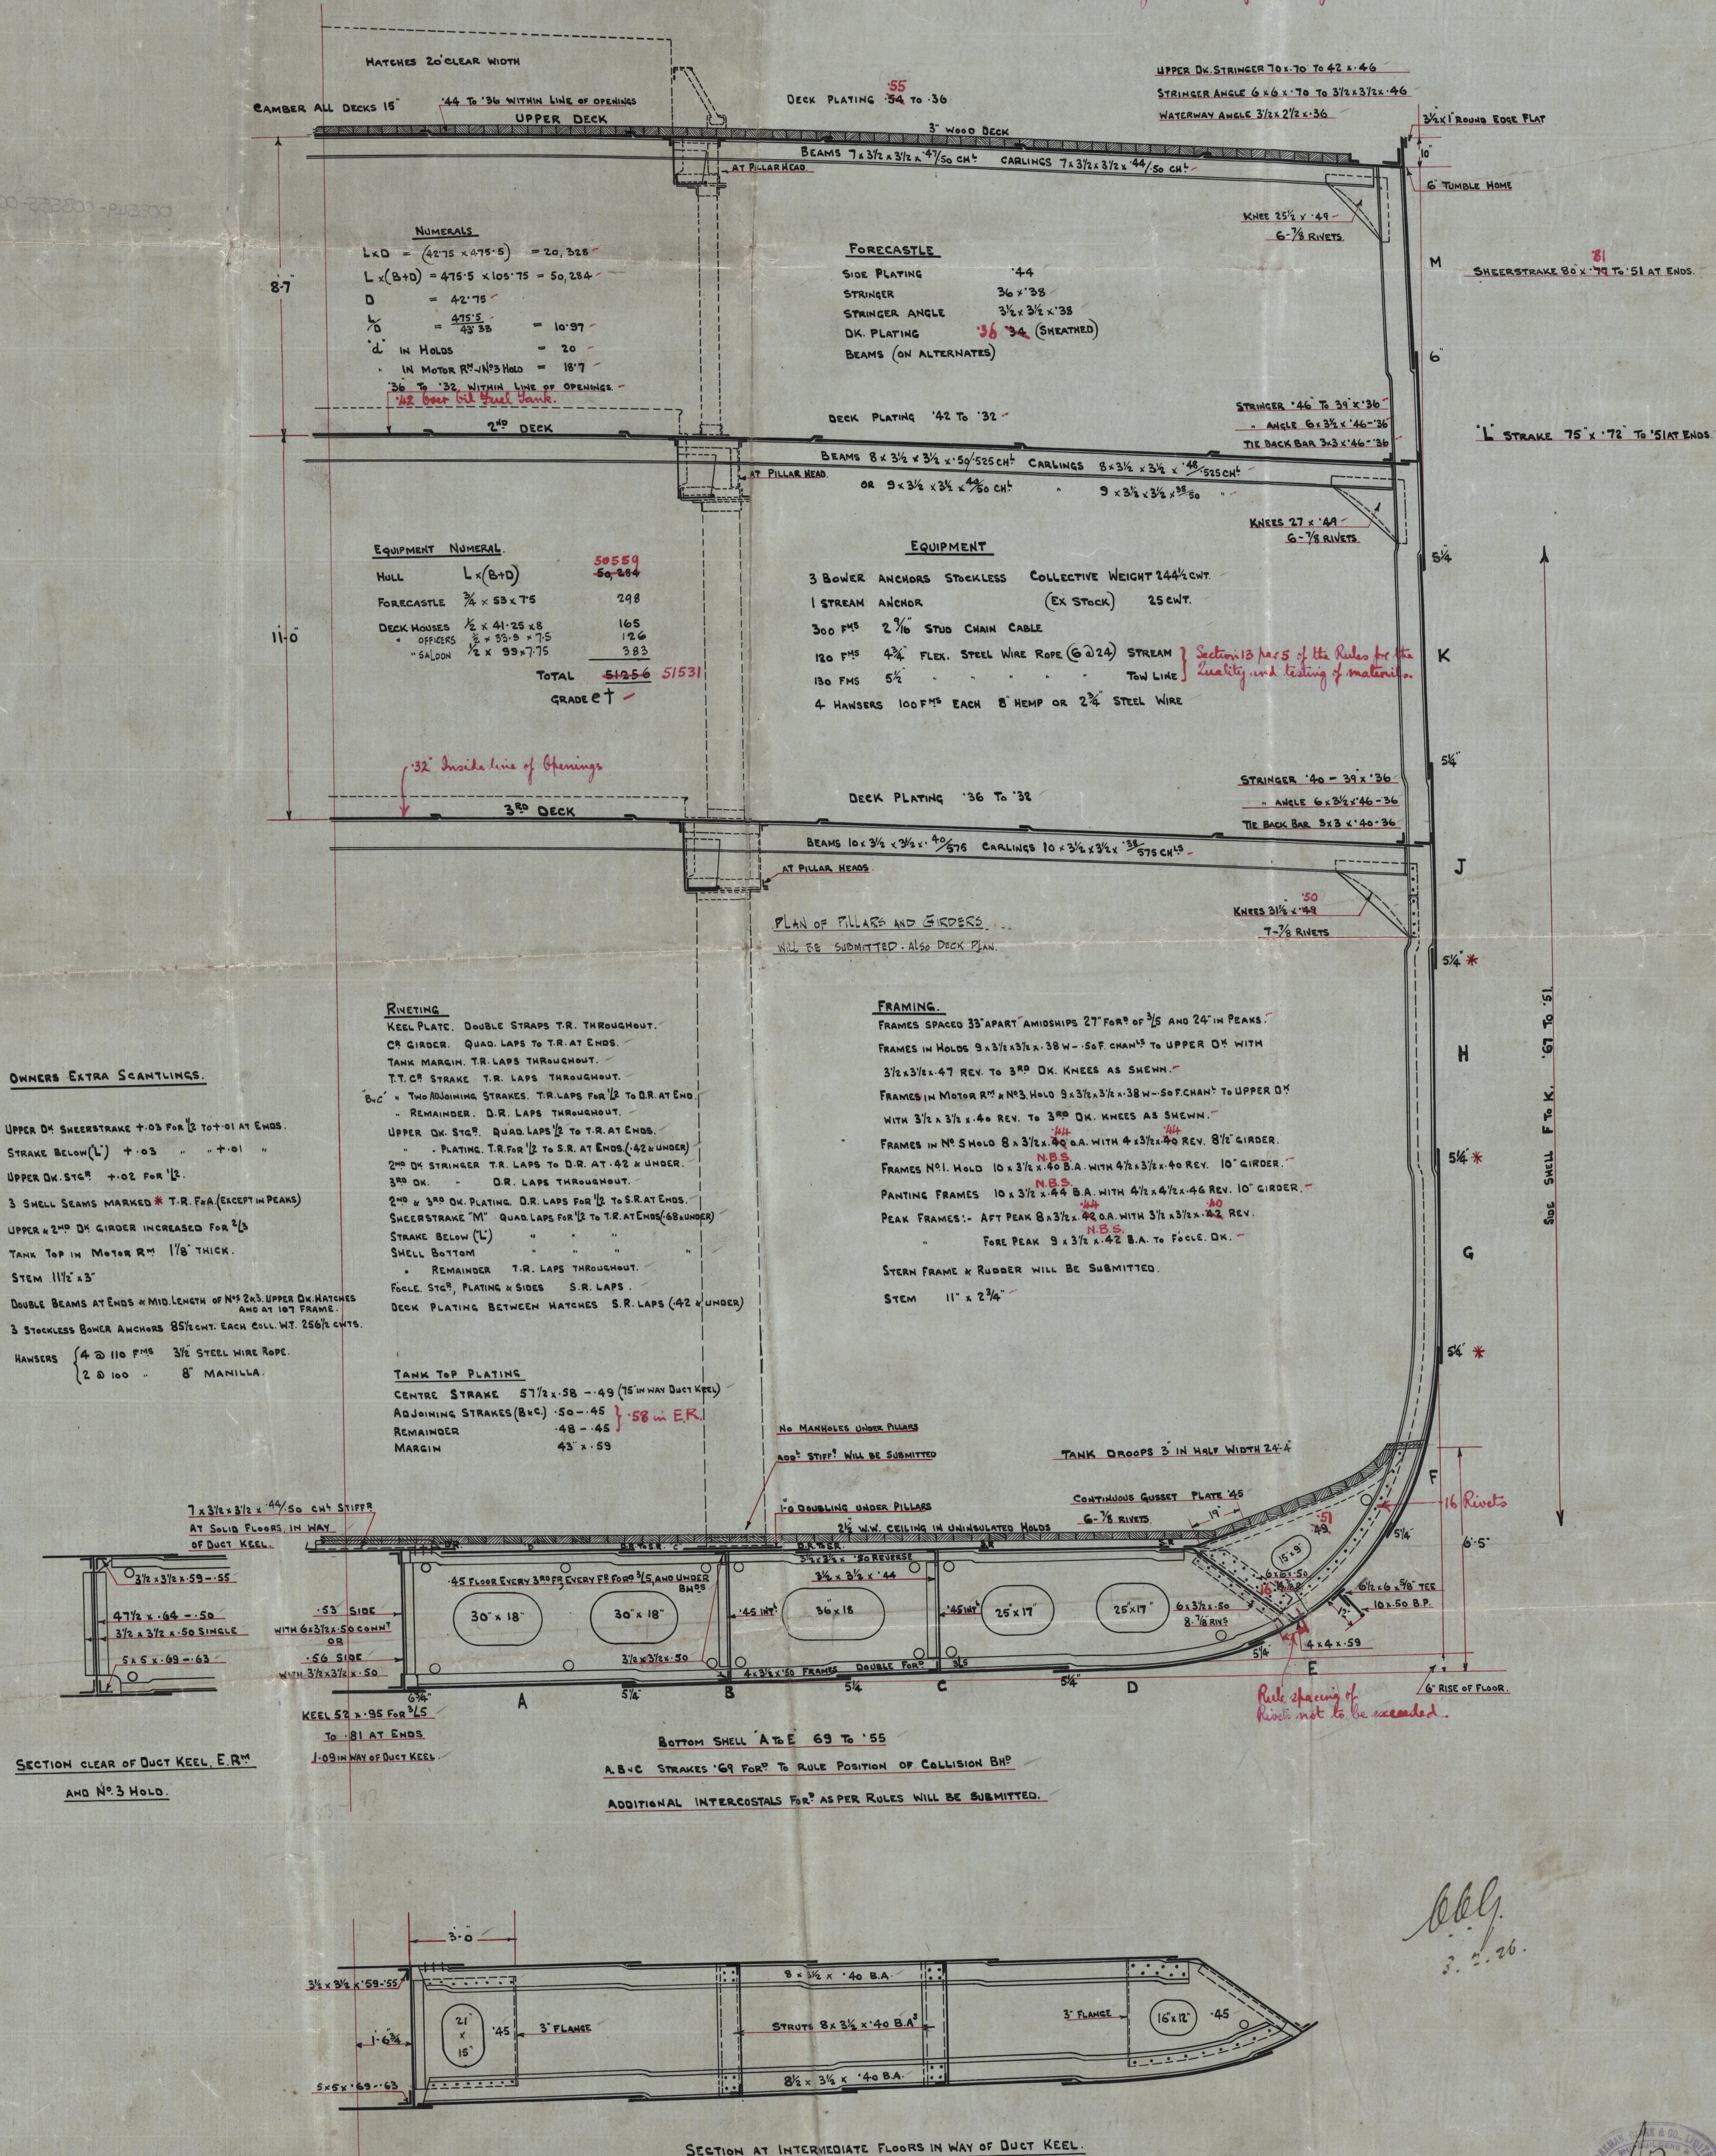

BBG.
3. 2. 26.

003549-003555-0098

(1) Midship Section
N^o 489
Workman Clark
Belfast

N.Y. "PORT FREMANTLE"

Ref N^o

RECORDS DEPT.,
LONDON.



003549-003555-0098



© 2020

Lloyd's Register
Foundation