

Lloyd's Register of Shipping.

Ship's Name

PORT FREMANTLE

Official No. 149807

Memorandum of alterations reported since ship was surveyed for assignment of Load Lines

in

1932

- 1) Tonnage opening on the shelter deck permanently closed by fitting a B.A. beam and wood decking caulked and payed.
- 2) Wash ports in the tonnage space permanently closed by welding plates over the openings.
- 3) All overboard scuppers from the shelter tween decks permanently closed by welding plates over the openings at the shell, and the tween decks are efficiently drained to the bilges.
- 4) The present battening arrangements of the shelter tween deck hatchways are being maintained and are efficient.
- 5) Efficient lifelines provided in all parts of the ship.
- 6) The statutory deck line has been cut in at the top of the wood sheathing of the shelter deck.

Arthur N. Smith
6/1/40

a copy of the above memorandum has been placed on board the ship.


✓ no alterations have been effected to the tonnage space bulkheads

new gross tonnage = 10241.63

" nett "

6373.81

Registered depth = 39.6'

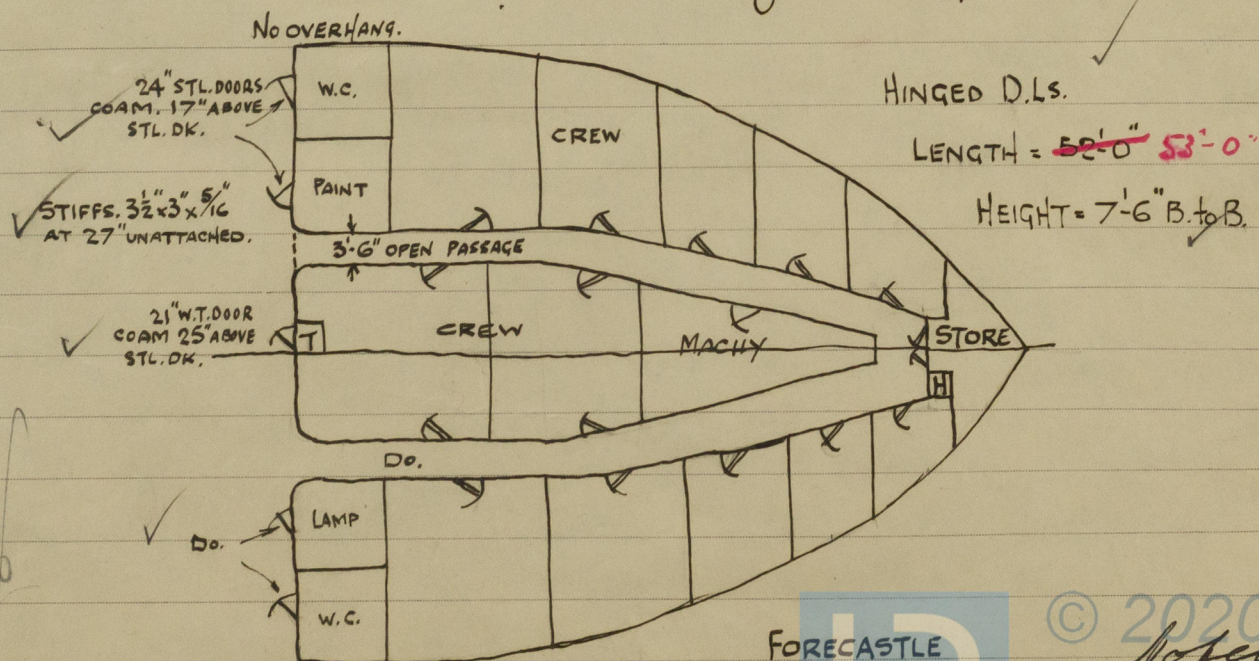

Fee £5-0-0

12 JAN 1940

FORECASTLE

© 2020

Lloyd's Register
Foundation