


READINGS IN WAY OF NO. 6 CENTRE

FRAME 61 - 62

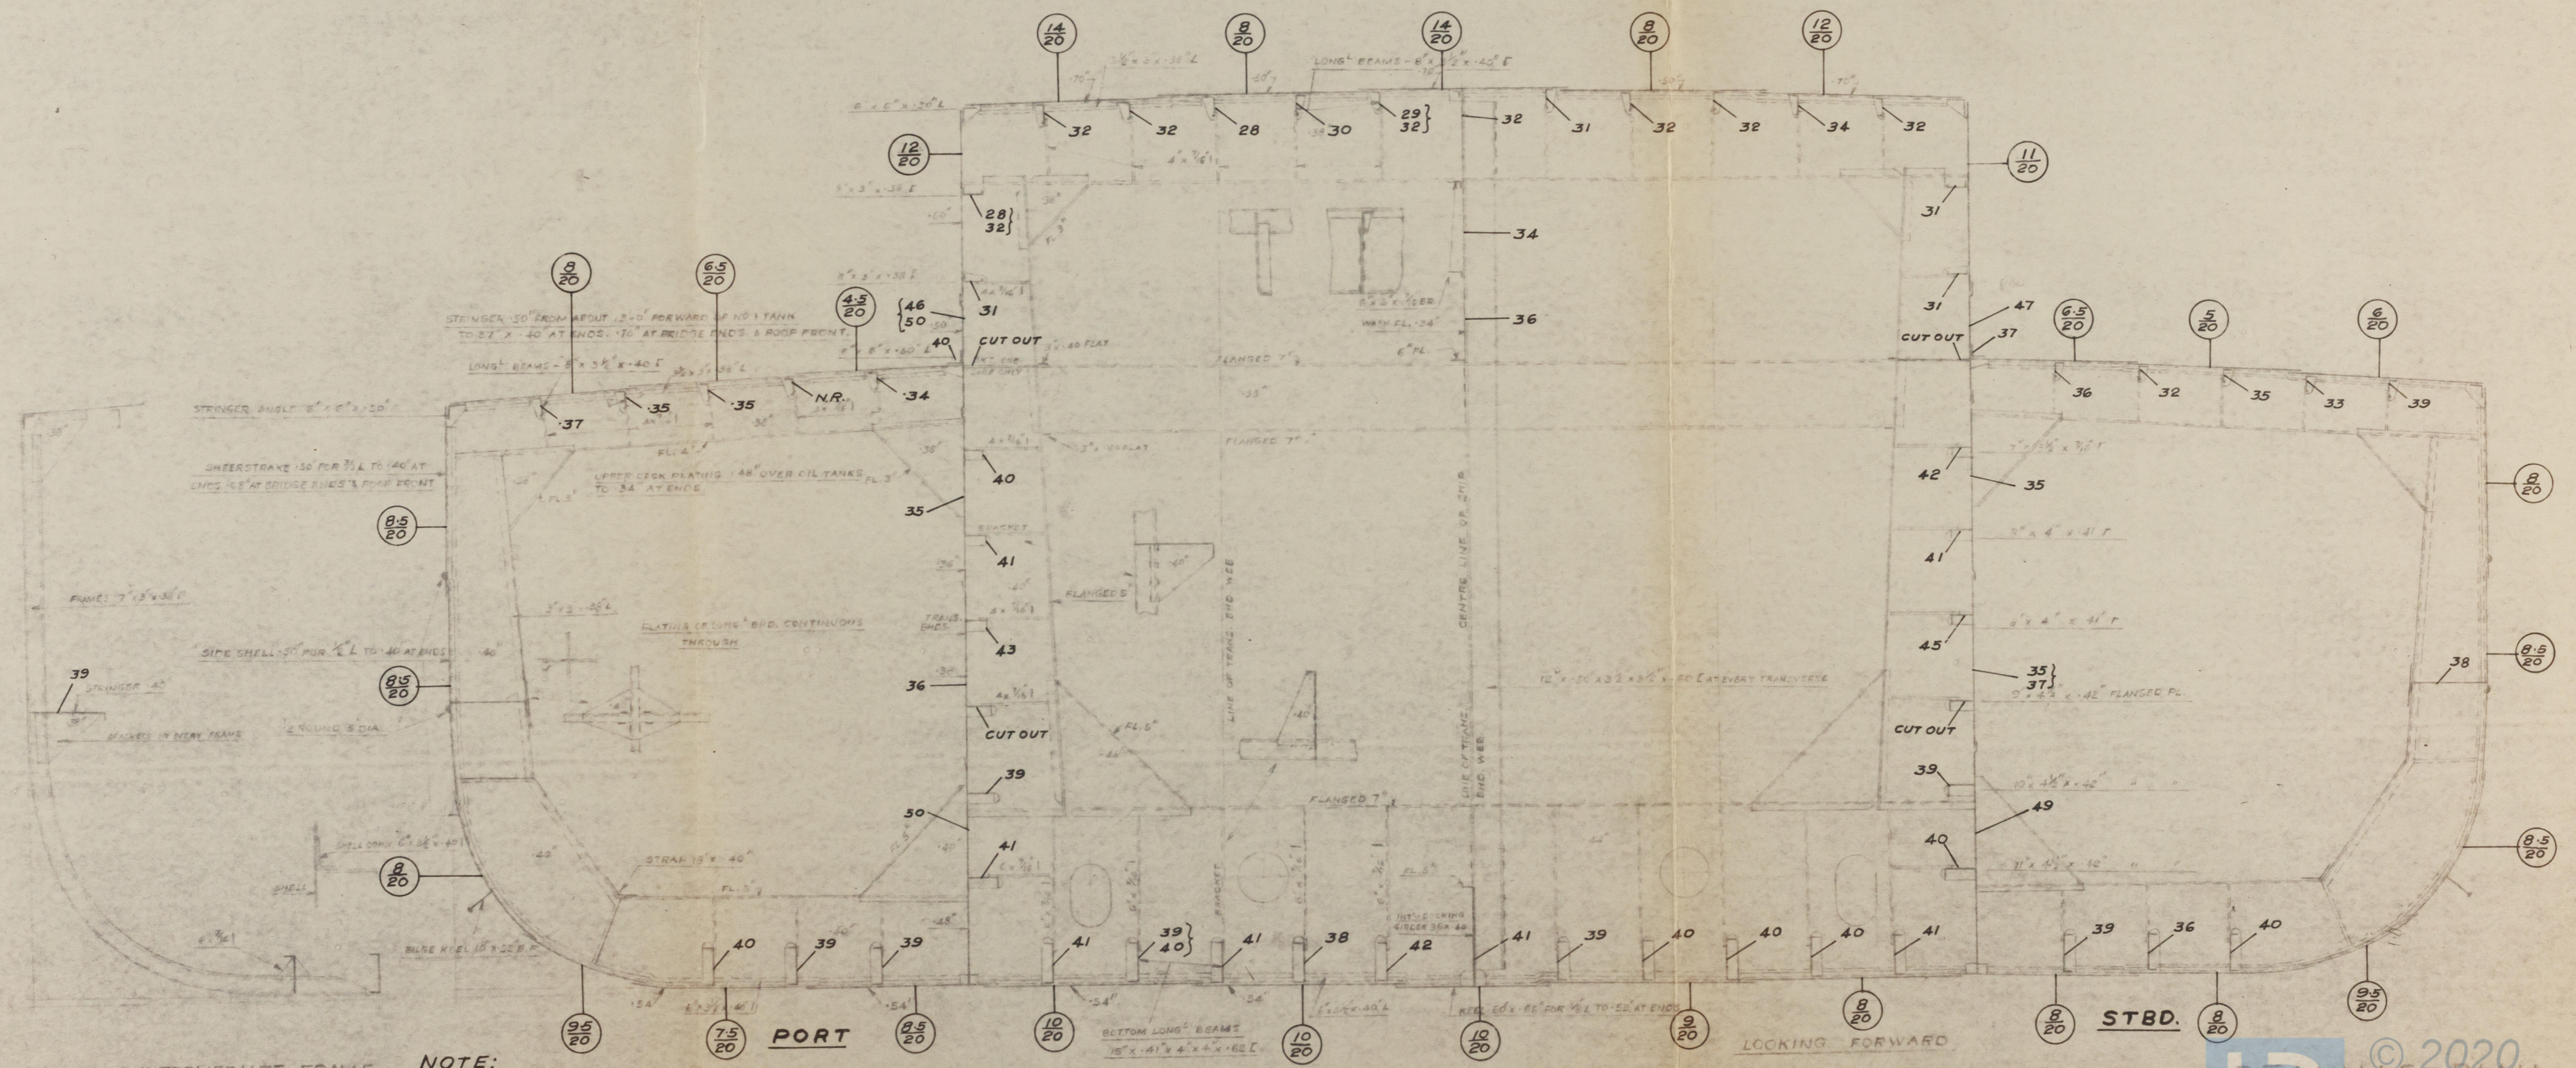

SECTION AT INTERMEDIATE FRAME

NOTE:

BELT DRILLING IN 20TH OF AN INCH.

ALL OTHER READINGS OBTAINED BY ULTRASONIC

GAUGINGS IN 100TH OF AN INCH.

MIDSHIP SECTION

LOOKING FORWARD

STBD.

© 2020
STANVAC RTAU
Lloyd's Register
Foundation
WHH - MAY 25, 1941

003549-003555-0179