


FRAME 131 - 132

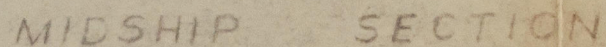

NOTE:

ALL OTHER READINGS OBTAINED BY ULTRASONIC
GAUGINGS IN 100TH OF AN INCH.

LOOKING FORWARD

STBD

© 2020
STANVAC RTAU
Lloyd's Re
Foundat

© 2020
VAC RTAU
Lloyd's Register
Foundation
WHOLE - MAY 25 '62

003549-003555-0180