



Lloyd's Register of Shipping.

Ship's Name "MISOA" Official No. -

Memorandum of alterations reported since ship was surveyed for assignment of Load Lines in

Openings in forecastle bulkhead and bridge after bulkhead are now provided with strong hinged steel watertight doors.

While vessel was engaged as a landing craft height of bridge was increased to 10' 6" and this height has been retained.

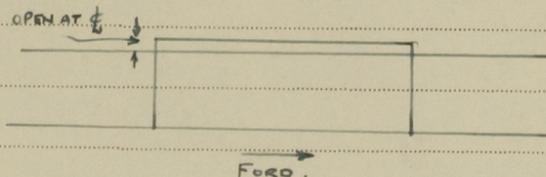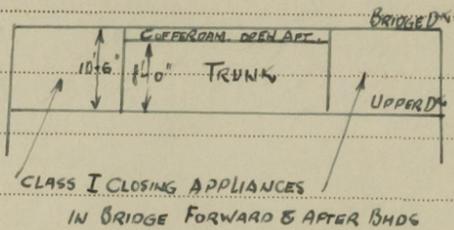

M. Medin

Surveyor to Lloyd's Register of Shipping

g

