


11-12-54
12-13-54

MATERIAL ORDERED.				
MATERIAL	ITEM	DIMENSIONS	QTY	REMARKS
M.S. PLATE	Nº1 WALLS	20'-0" x 72'-0" x 3/16"	2	CT.1.1. USE 88 20'-0" CUT 2 @ 12'-0"
"	"	30'-0" x 60'-0" x 3/16"	5	CT.1.2. USE 4 @ 30'-0" CUT 1 @ 12'-0"
"	"	30'-0" x 60'-0" x 3/16"	2	CT.1.3. CUT TO TEMPLATE ALSO USE REMAINDER OF 1.2.2
"	Nº2 "	30'-0" x 72'-0" x 3/16"	10	CT.2.1. USE 8 @ 30'-0" CUT 2 @ 25'-0"
"	"	30'-0" x 60'-0" x 3/16"	5	CT.2.2. USE 4 @ 30'-0" CUT 1 @ 25'-0"
"	"	30'-0" x 60'-0" x 3/16"	2	CT.2.3. CUT TO TEMPLATE ALSO USE REMAINDER OF 1.2.2
"	Nº3 "	30'-0" x 72'-0" x 3/16"	10	CT.3.1. USE 8 @ 30'-0" CUT 2 @ 25'-0"
"	"	30'-0" x 60'-0" x 3/16"	5	CT.3.2. USE 4 @ 30'-0" CUT 1 @ 25'-0"
"	"	30'-0" x 72'-0" x 3/16"	2	CT.3.3. CUT TO TEMPLATE ALSO USE REMAINDER OF 1.2.2
"	Nº4 "	30'-0" x 72'-0" x 3/16"	12	CT.4.1. USE 9 @ 30'-0" CUT 3 @ 12'-0"
"	"	30'-0" x 72'-0" x 3/16"	1	CT.4.2. CUT TO TEMPLATE ALSO USE REMAINDER OF 1.2.2
M.S. ANGLE	ALL WALLS	40'-0" x 5'-0" x 3/16"	74	CT. CUT TO TEMPLATE CUT BRACKETS FROM STOCK PLATE.

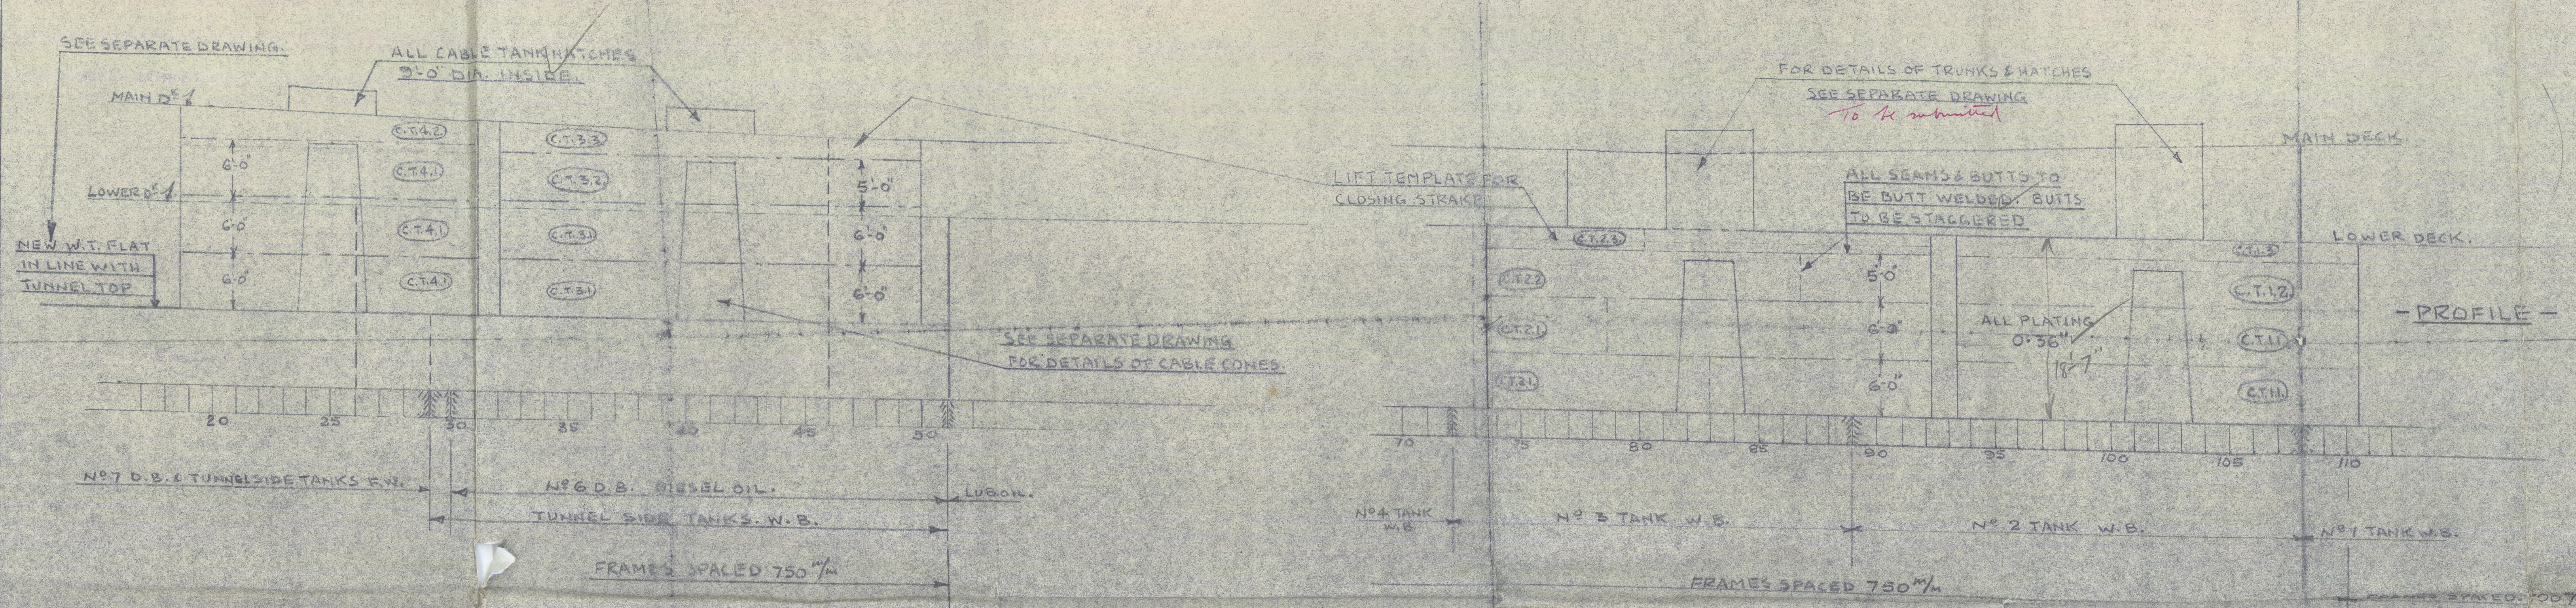


Plan showing of deck showing girders etc. to be submitted. 37

Plan showing oil fuel structure and tunnel side tanks to be submitted.

$17' 33" \times 2' 5" \times 9' 29" = 257' 0"$

35 x 8

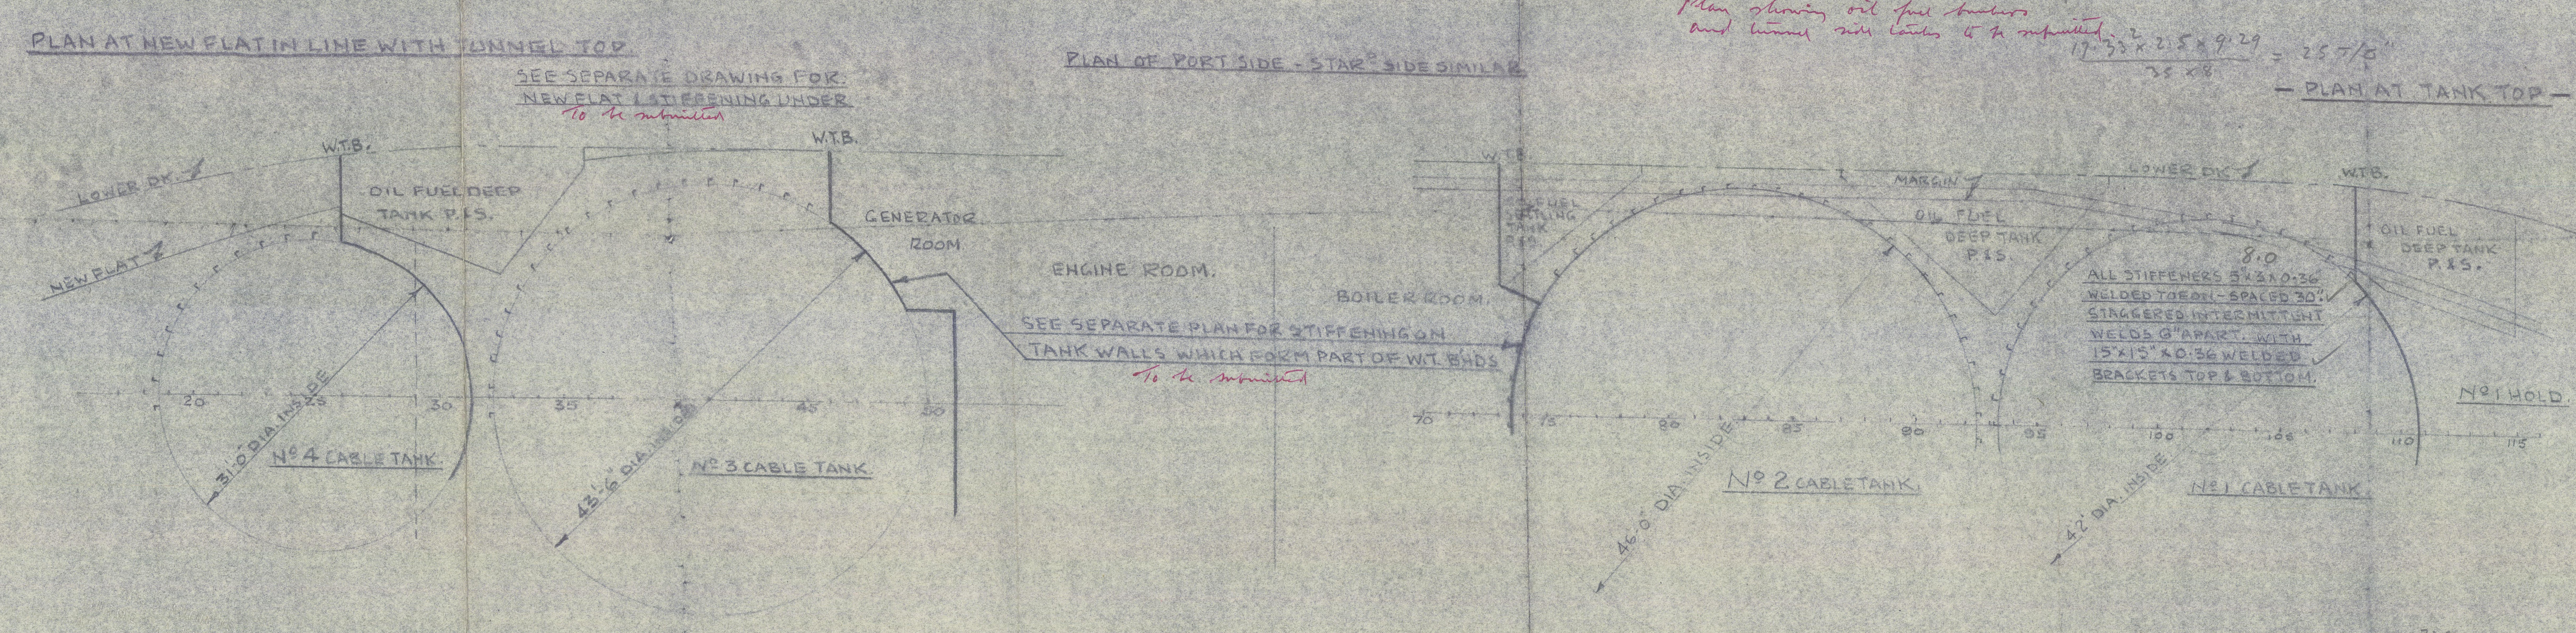

Office

23/4/54

"OCEAN LAYER" ★ *Md 9964*

CABLE TANKS .

RECORDS DEPT.
Md 9964
LONDON.

44

003556-003566-0008



© 2020

Lloyd's Register
Foundation