


# Lloyd's Register of Shipping.

Ship's Name "OBSIDIAN." Official No. 145709.

Memorandum of alterations reported since ship was surveyed for assignment of Load Lines in C11. Glasgow Report No. 52465.

No. 1 Hatchway on Freeboard deck. (Well forward) has been extended in length by 4' making the length of Hatchway 35' 5" thus making the aftermost bay 5' 56" in lieu of 4' 98" as originally fitted. The Hatch covers in this bay has been renewed of 3" W.P.

S.B.  
8.6.38

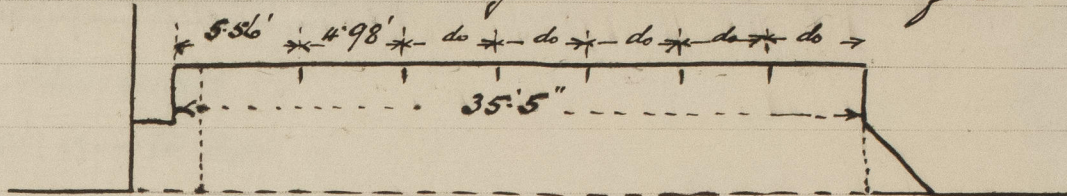

Noted. *Ward.*  
*F.B.*

7 JUN 1938