

Lloyd's Register of Shipping.


Ship's Name ULMUS.Official No. 148764.

Memorandum of alterations reported since ship was surveyed for assignment of Load Lines in June 1932.


WATER BALLAST TANK

BUILT IN POOP.


POOP DECK.

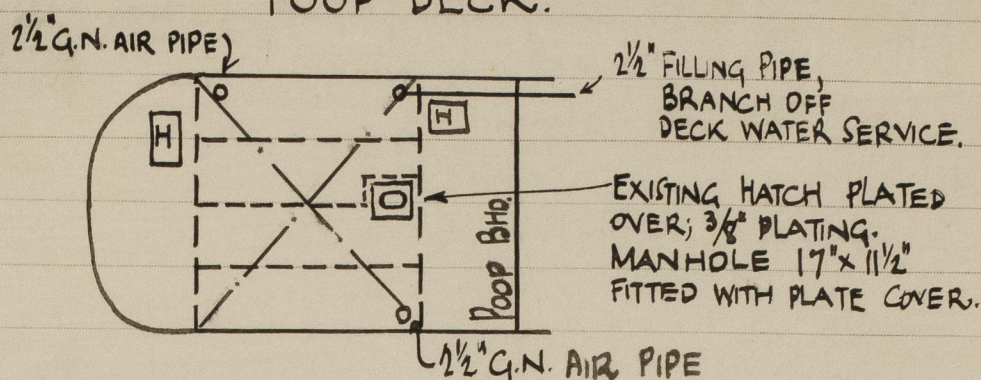

H. HATCH TO STORES 28" x 20"
COAMINGS 18 1/2" x 3/8"
2 1/2" WOOD COVERS
6 CLEATS
2 TARPULINS
BATTENS AND WEDGES.

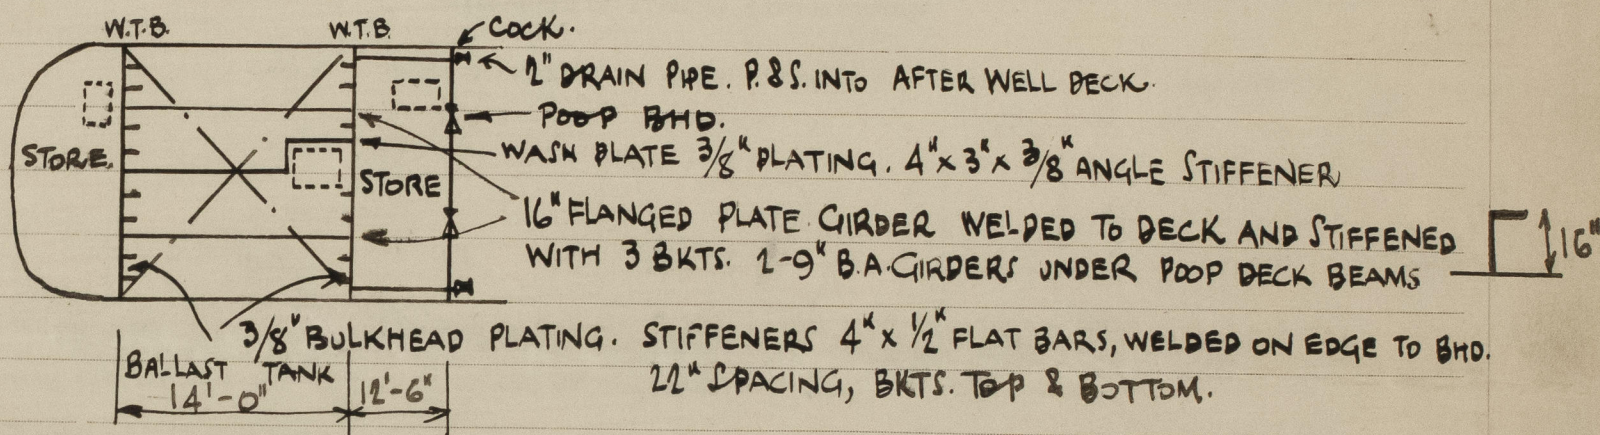

BUNKER HATCH ON CASING TOP.

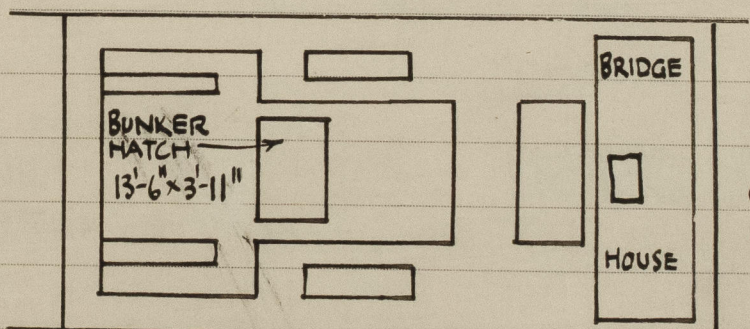

DIMENSIONS OF HATCHWAY 13'-6" x 3'-11".
COAMINGS 9" B.A.
HATCH COVERS 2 1/2" W.P. FITTED F. & A.
CLEATS 23" APART.
1 TARPULINS
BATTENS & WEDGES.

Annual Survey. C.F. Nov. 1937

Noted *[Signature]*
17/11/37