

PLAN No 14

SHIP No 278 & 308

PROFILE & DECKS

SCALE 1/8" = 1 FOOT

DIMENSIONS: 27'4" x 37'8" MLD. 10'5" To MAIN DK 25'8" MLD To SHELTER DK

To CLASS 100 A.1 AT LLOYDS



TRANSVERSE No 55.91

LONGITUDINAL No 15319.34

DEPTH To LENGTH = 10.68' To SHELTER DK

= 15.00' To MAIN DK

Holds & Top of TUNNEL Ceiled as per MIDSHIP SECTION.

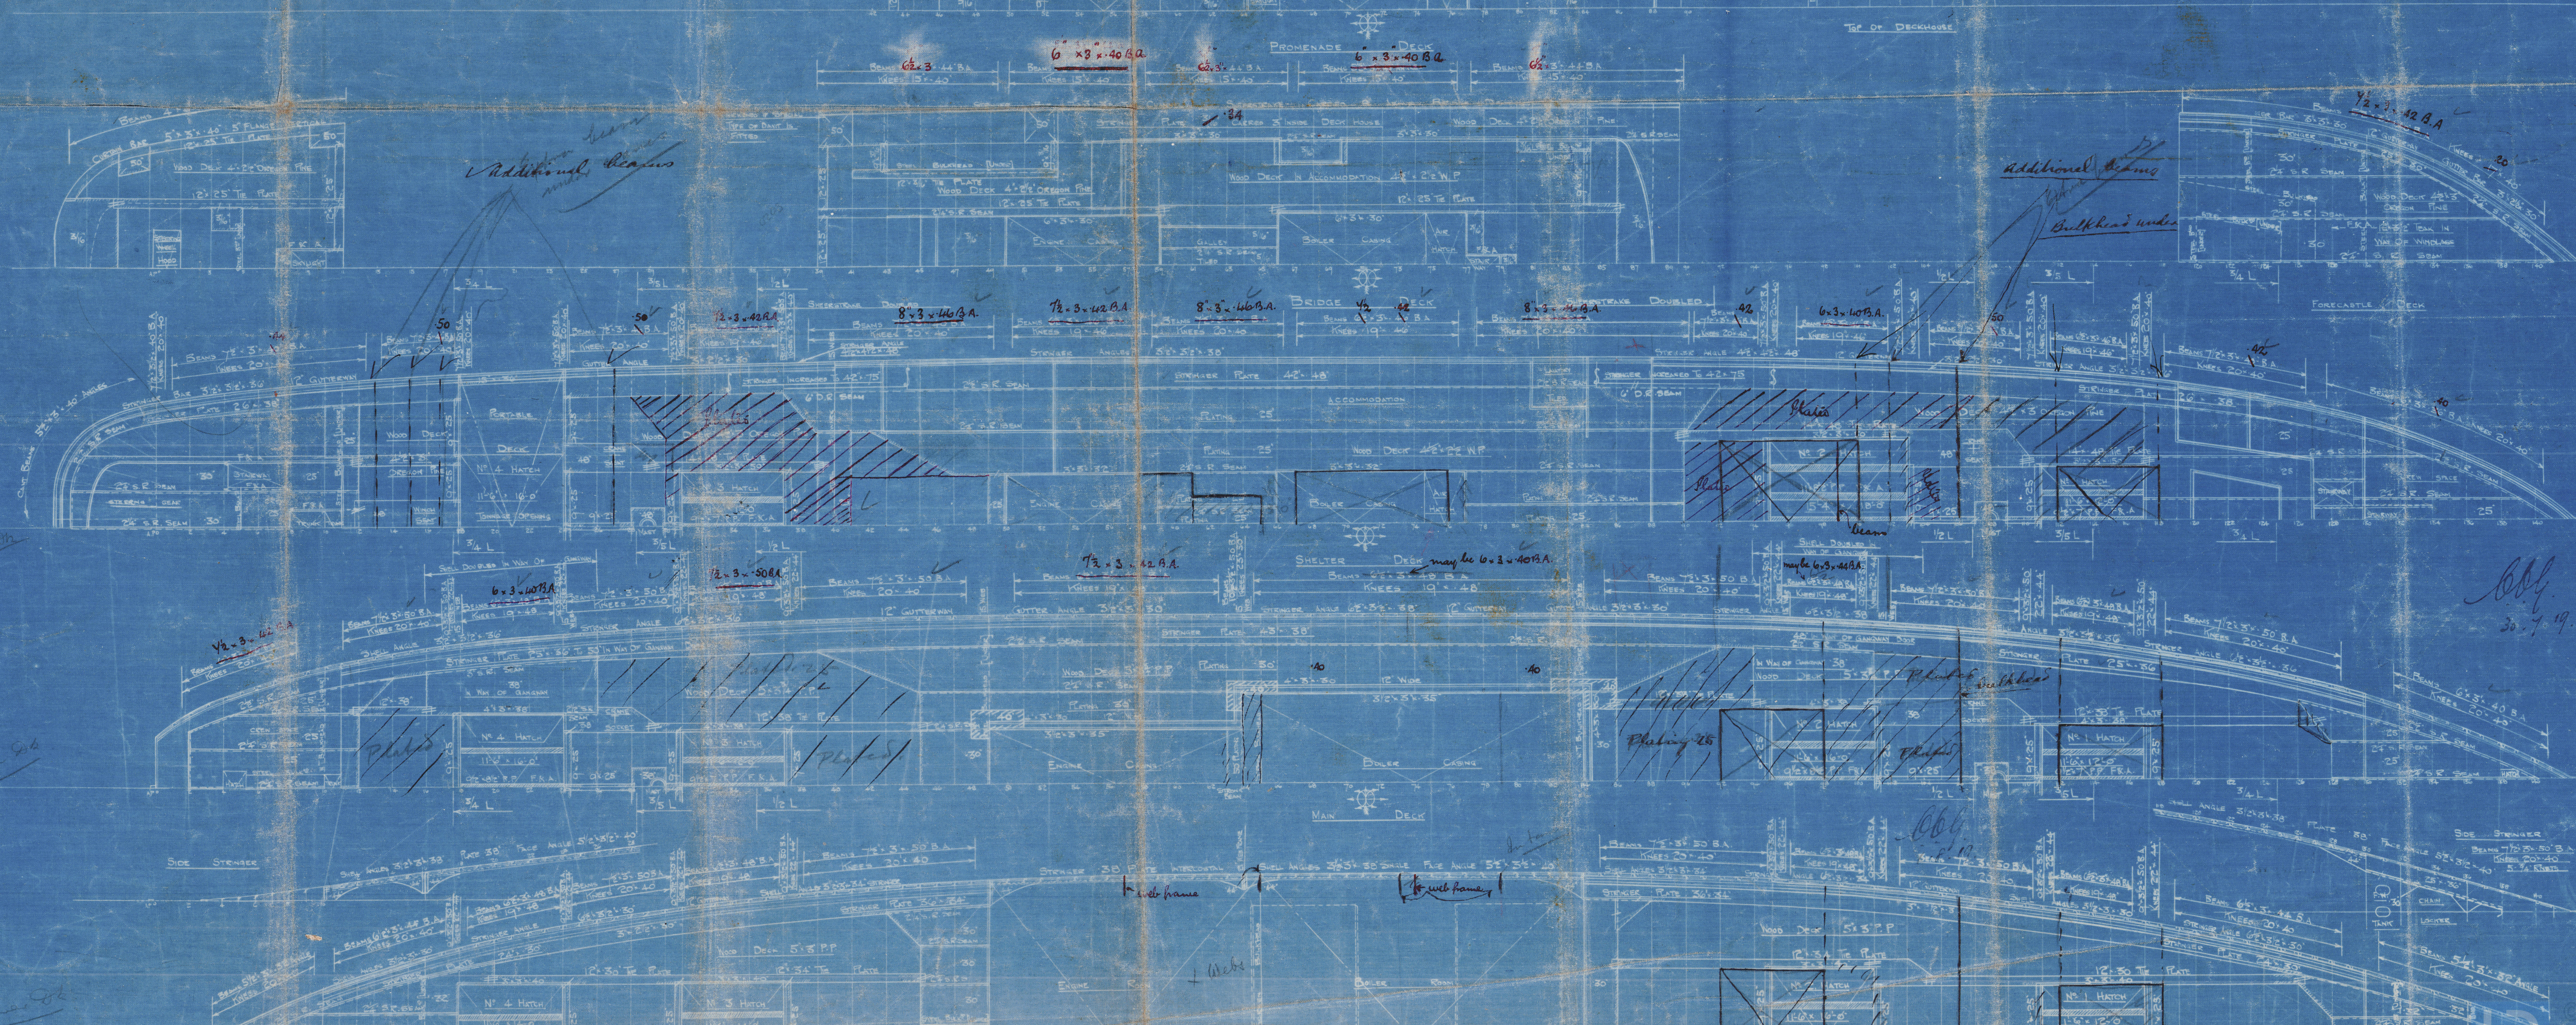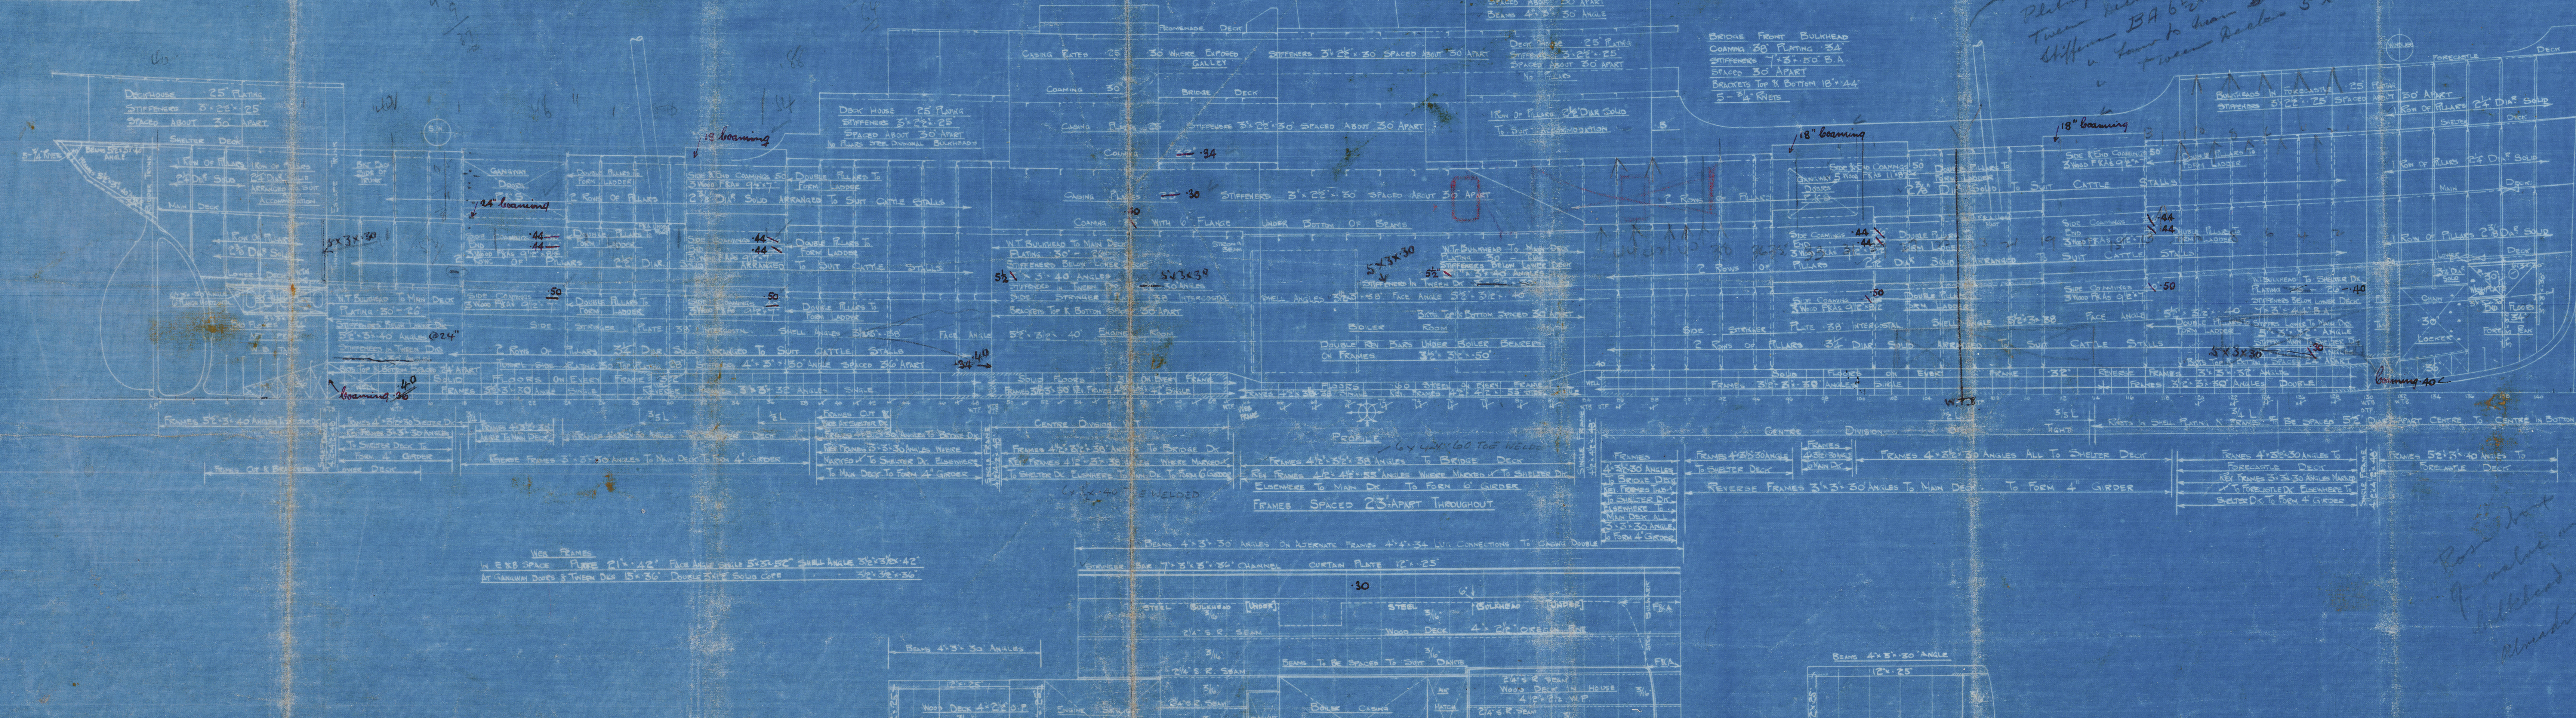




Anderson Cl.

No. 278 & 308

Profile & Deck

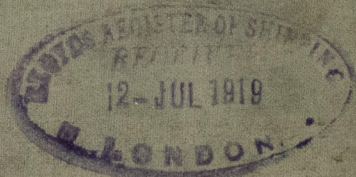

GLASGOW REPORT No. 41045

S. Ordmore

No. 278- S. Kenmare

41518

GLASGOW REPORT No. 41518  
**RETAIN**

Lady Longford  
Lairdshill

