

1/5/19

PLAN No 13
SHIP No 278,308
MIDSHIP SECTION.

DIMENSIONS 274'0" x 37'8" M.D. x 18'3" M.D. To MAIN DECK x 25' M.D. To SHELTER DECK.

To CLASS 100 A.1. At LLOYD'S.




SCALE 1/2" = 1 FOOT.



EQUIPMENT	NUMERALS
Long: 18' 3" (57' 6" + 18' 3")	15319
SHELTER DECK 17' 4" x 75'	1522
FORECASTLE DECK 17' 55" x 75'	252
BRIDGE DECK 15' 75" x 75'	522
MT DECKHOUSE 18' 5" x 33' x 20'	102
MIDSHIP DECKHOUSE 20' 5" x 75' x 20'	22
CAPTAIN'S HOUSE 21' 5" x 75' x 20'	22
CABING 26' 5" x 33' x 20'	22
EQUIPMENT	NUMERALS
EQUIPMENT	LETTERS

EQUIPMENT	NUMERALS	LETTERS
2 BOWS ANDRUSS (STOCKLESS) 35% CWT	101	CWT
1 STRAIN ANCHOR 34 CWT + 2 PLANTS + 1 PLANT FL. STOCK	101	CWT
1 STRAIN ANCHOR 34 CWT + 2 PLANTS + 1 PLANT FL. STOCK	101	CWT
240 FATHOMS 15' 30" CABLE CABLE MINIMUM HEIGHT 370 CWT LBS 22 LBS	101	CWT
75' 1/2" STEEL WIRE STRAIN	101	CWT
40' 3/4" STEEL WIRE STRAIN	101	CWT
20' 8" MANILLA WIRE	101	CWT
10' 8" STEEL MANILLA	101	CWT

LLOYD'S NUMERALS
B = 37' 00"
D = 18' 25"
LONG No 5591
L = 274' 00"
LONG No 1531934
d in Hold = 7' 92"
d in E.B.S. = 15' 33"
Depth To Length = 10' 08" To SHELTER DECK
Depth To Length = 15' 00" To MAIN DECK

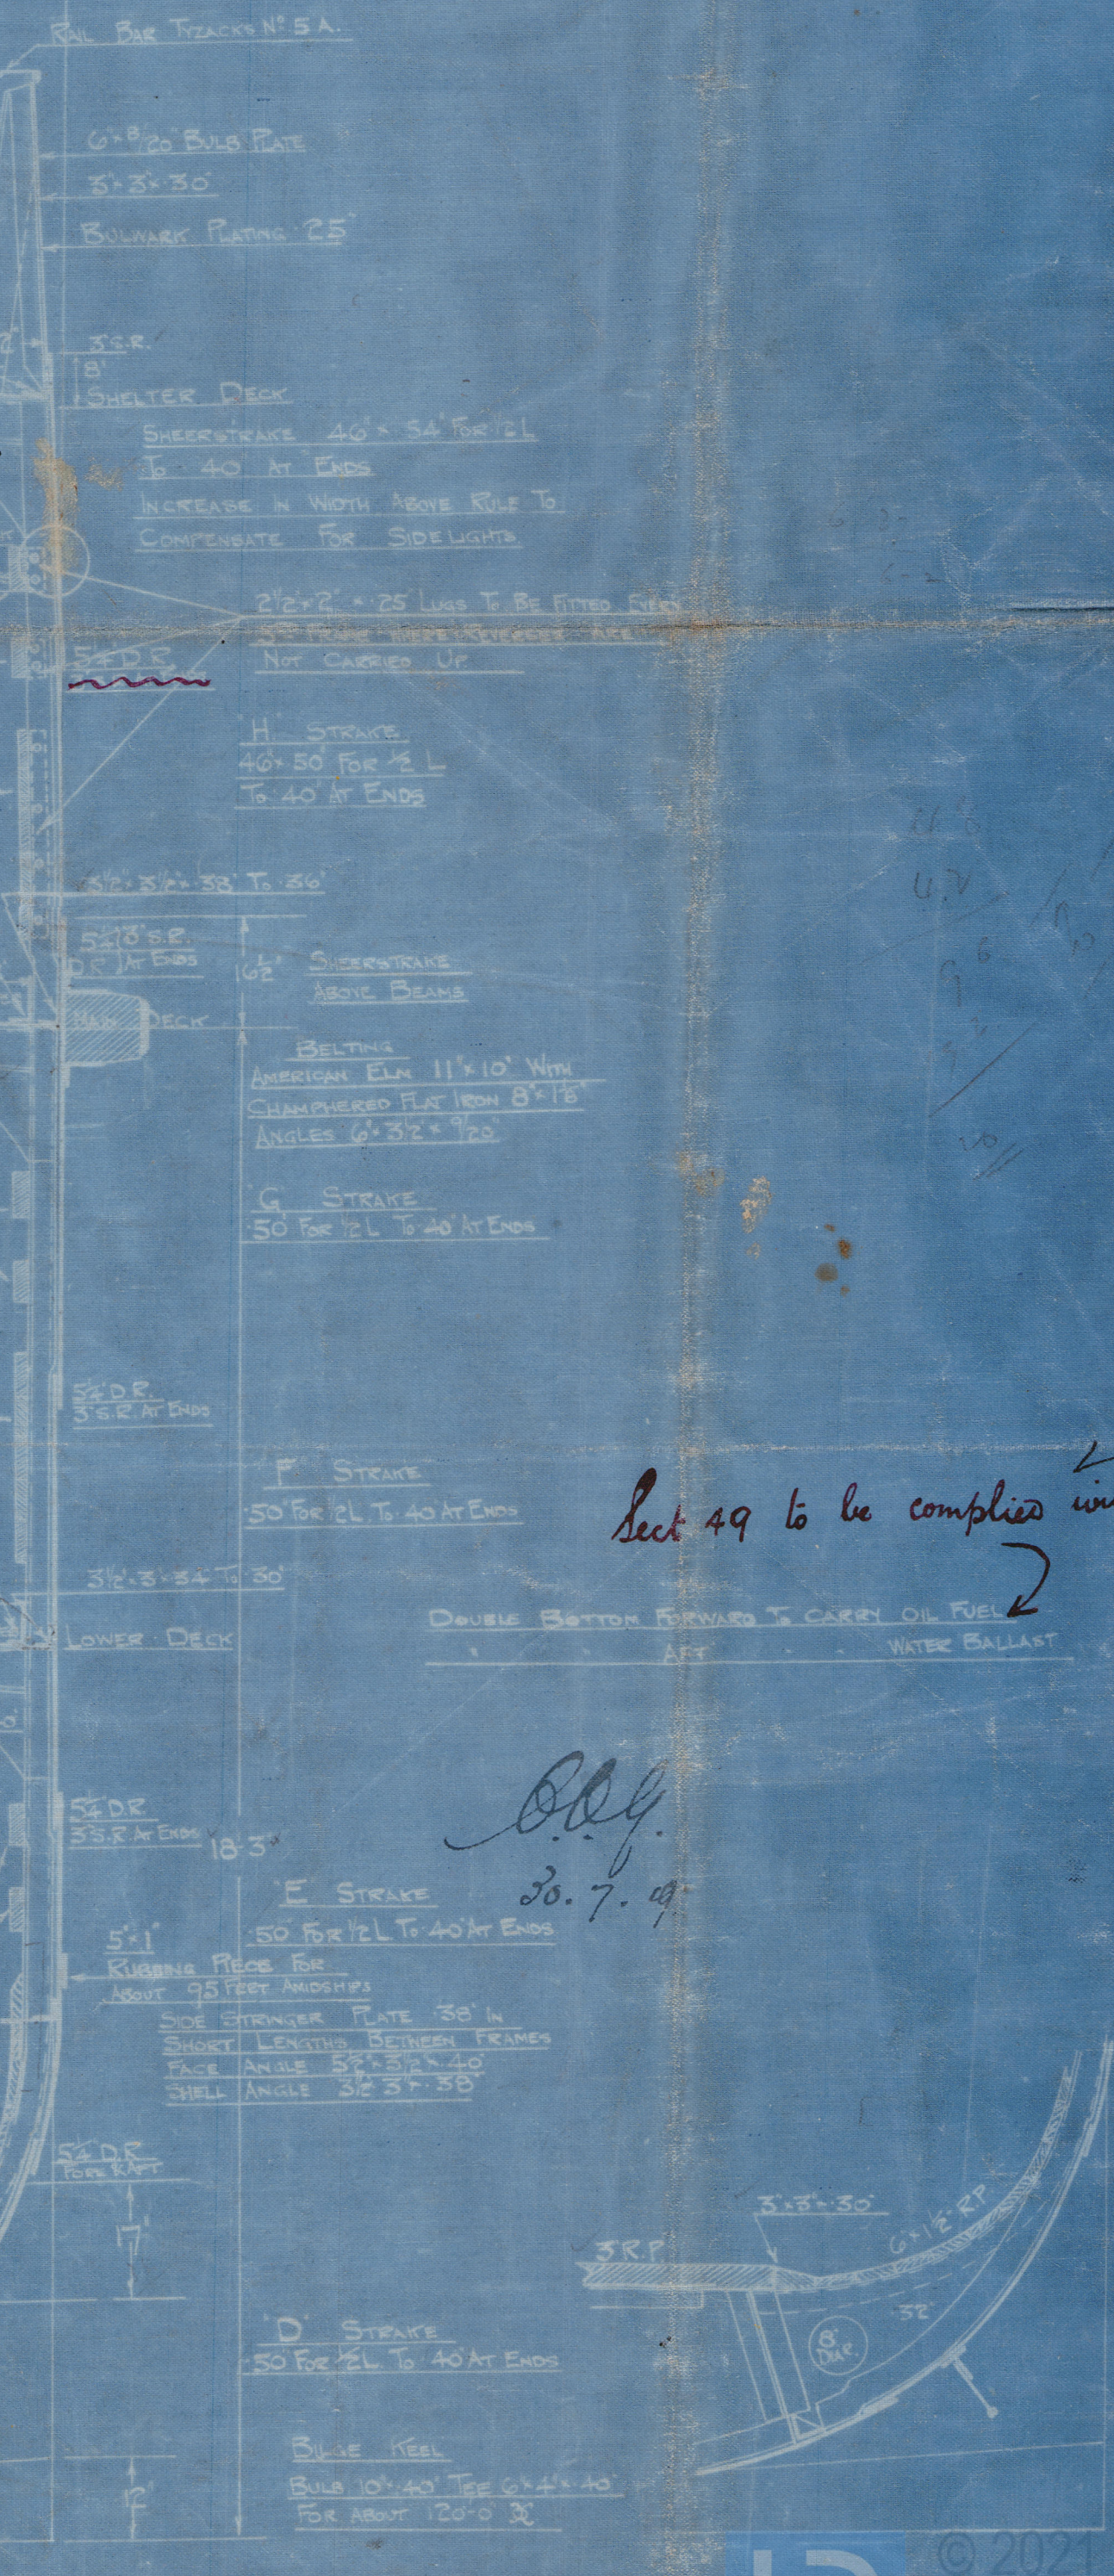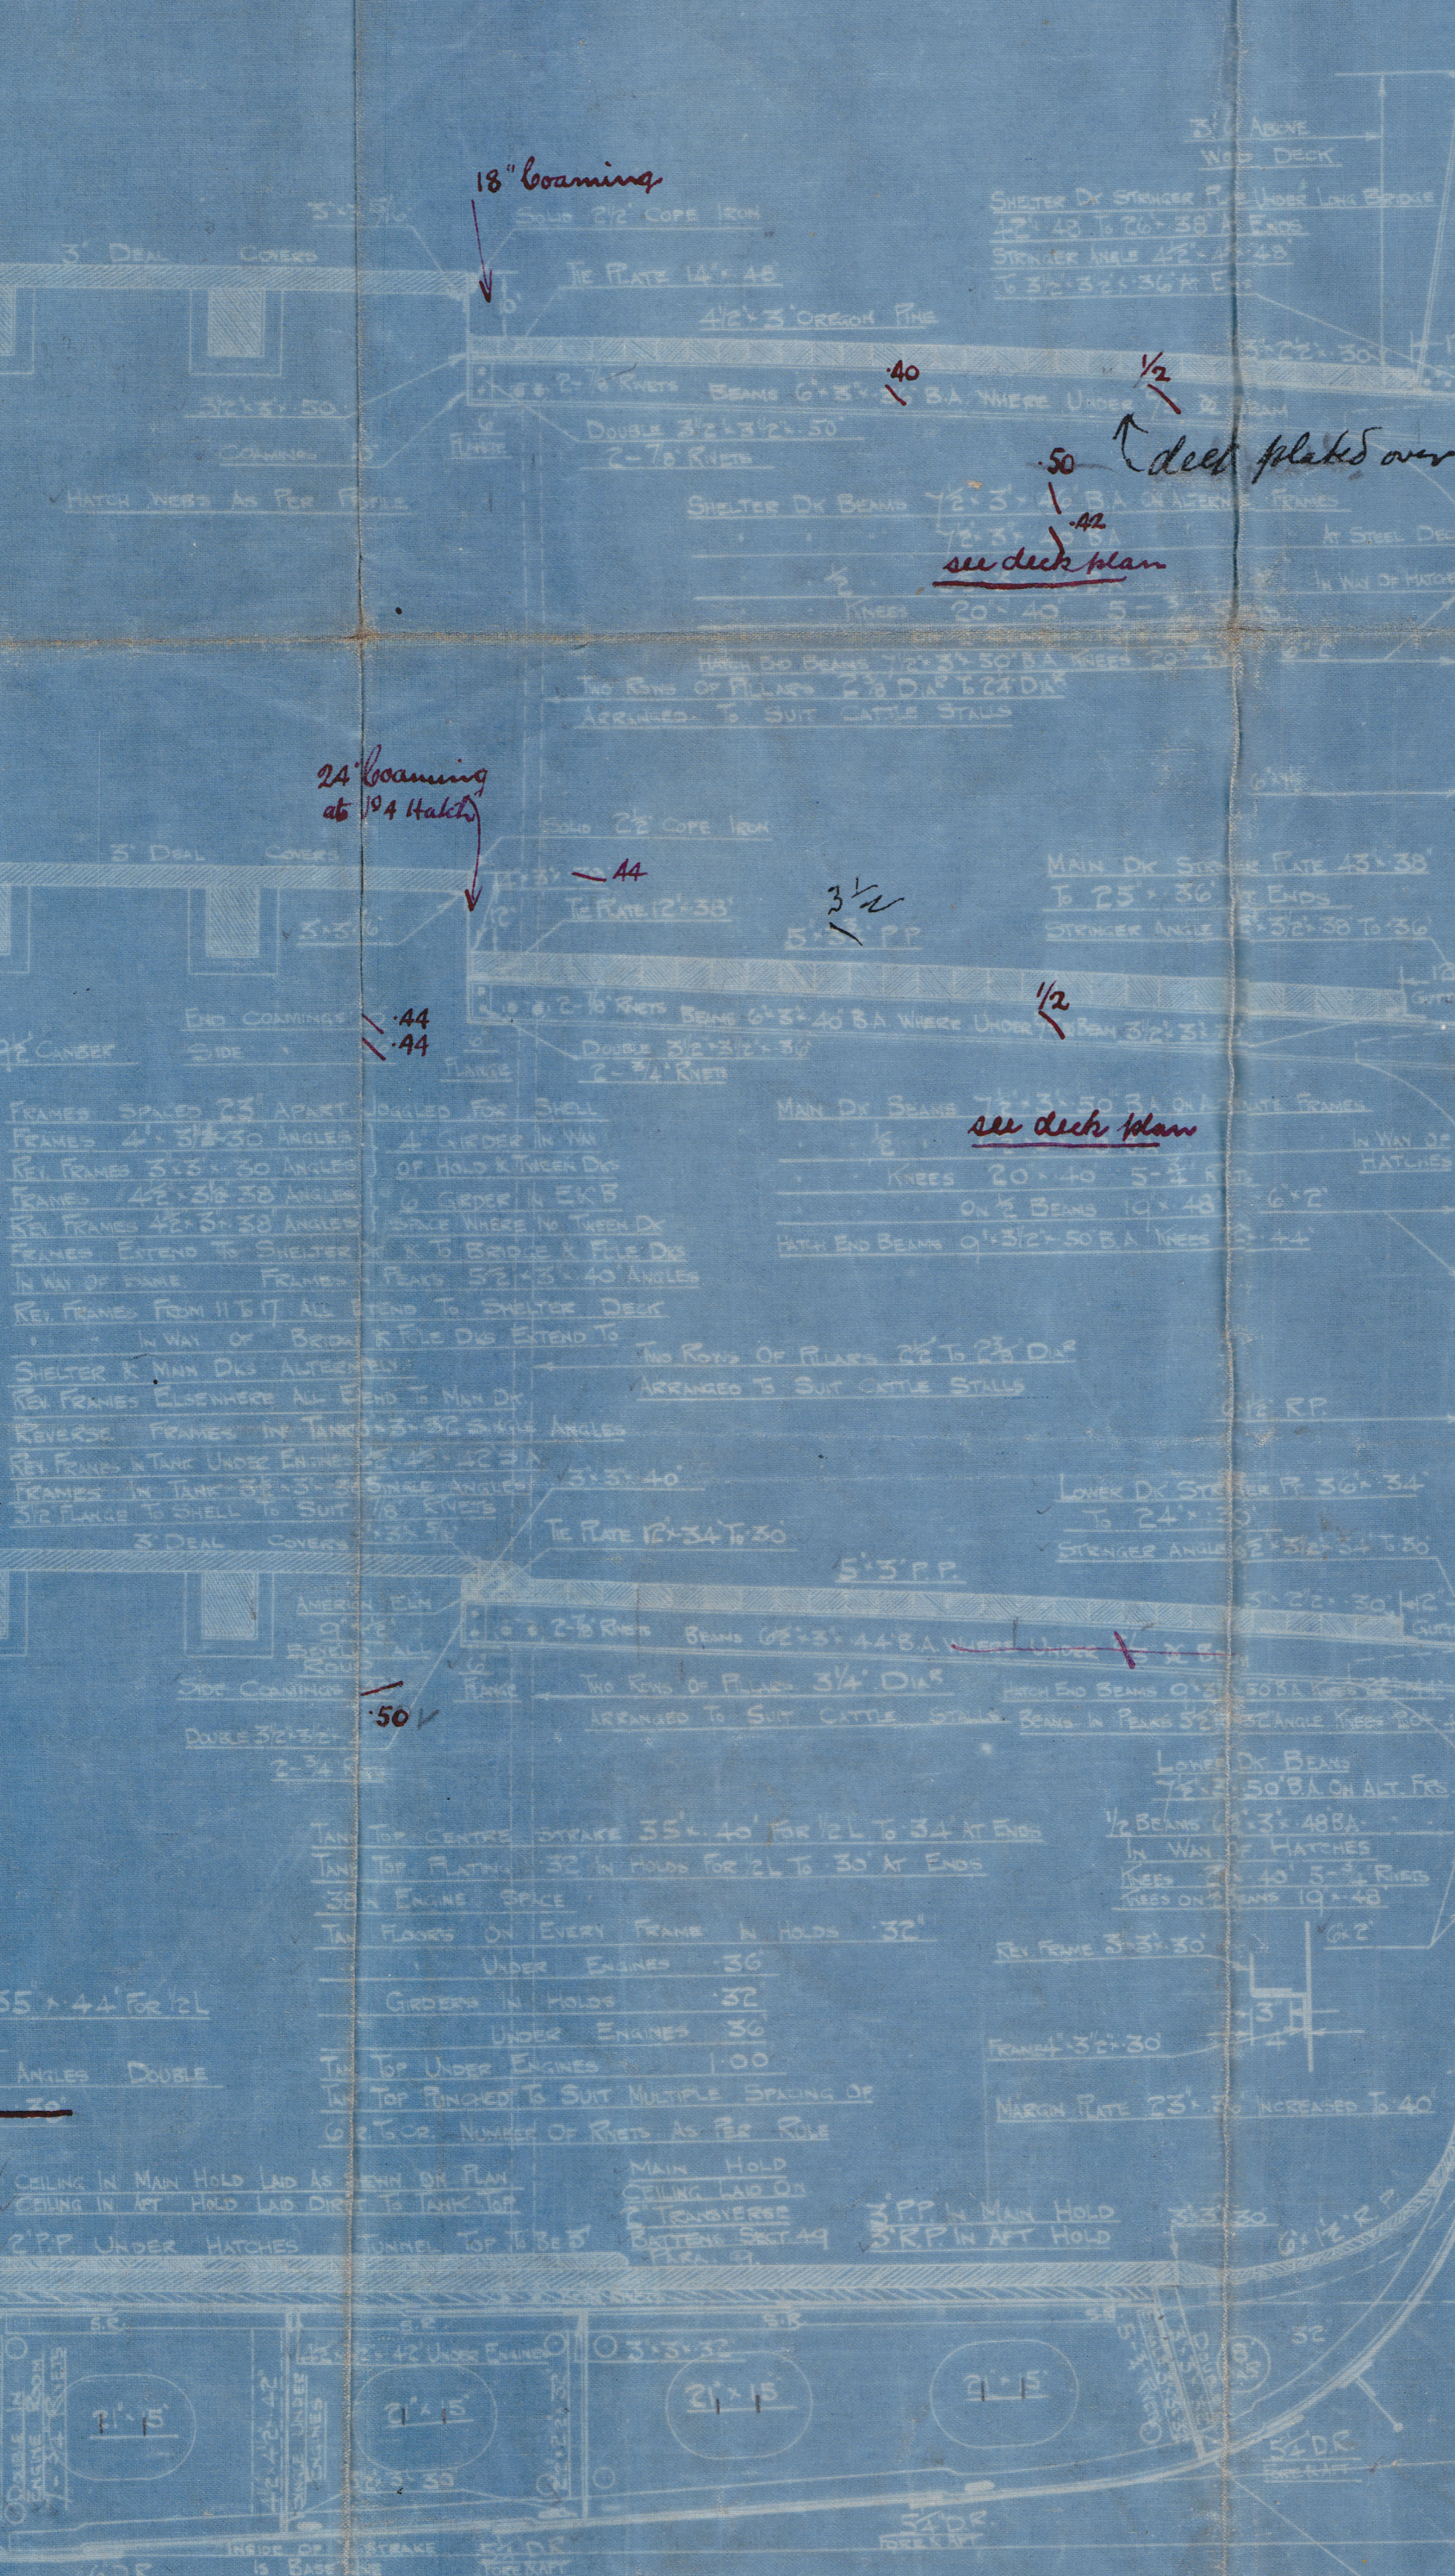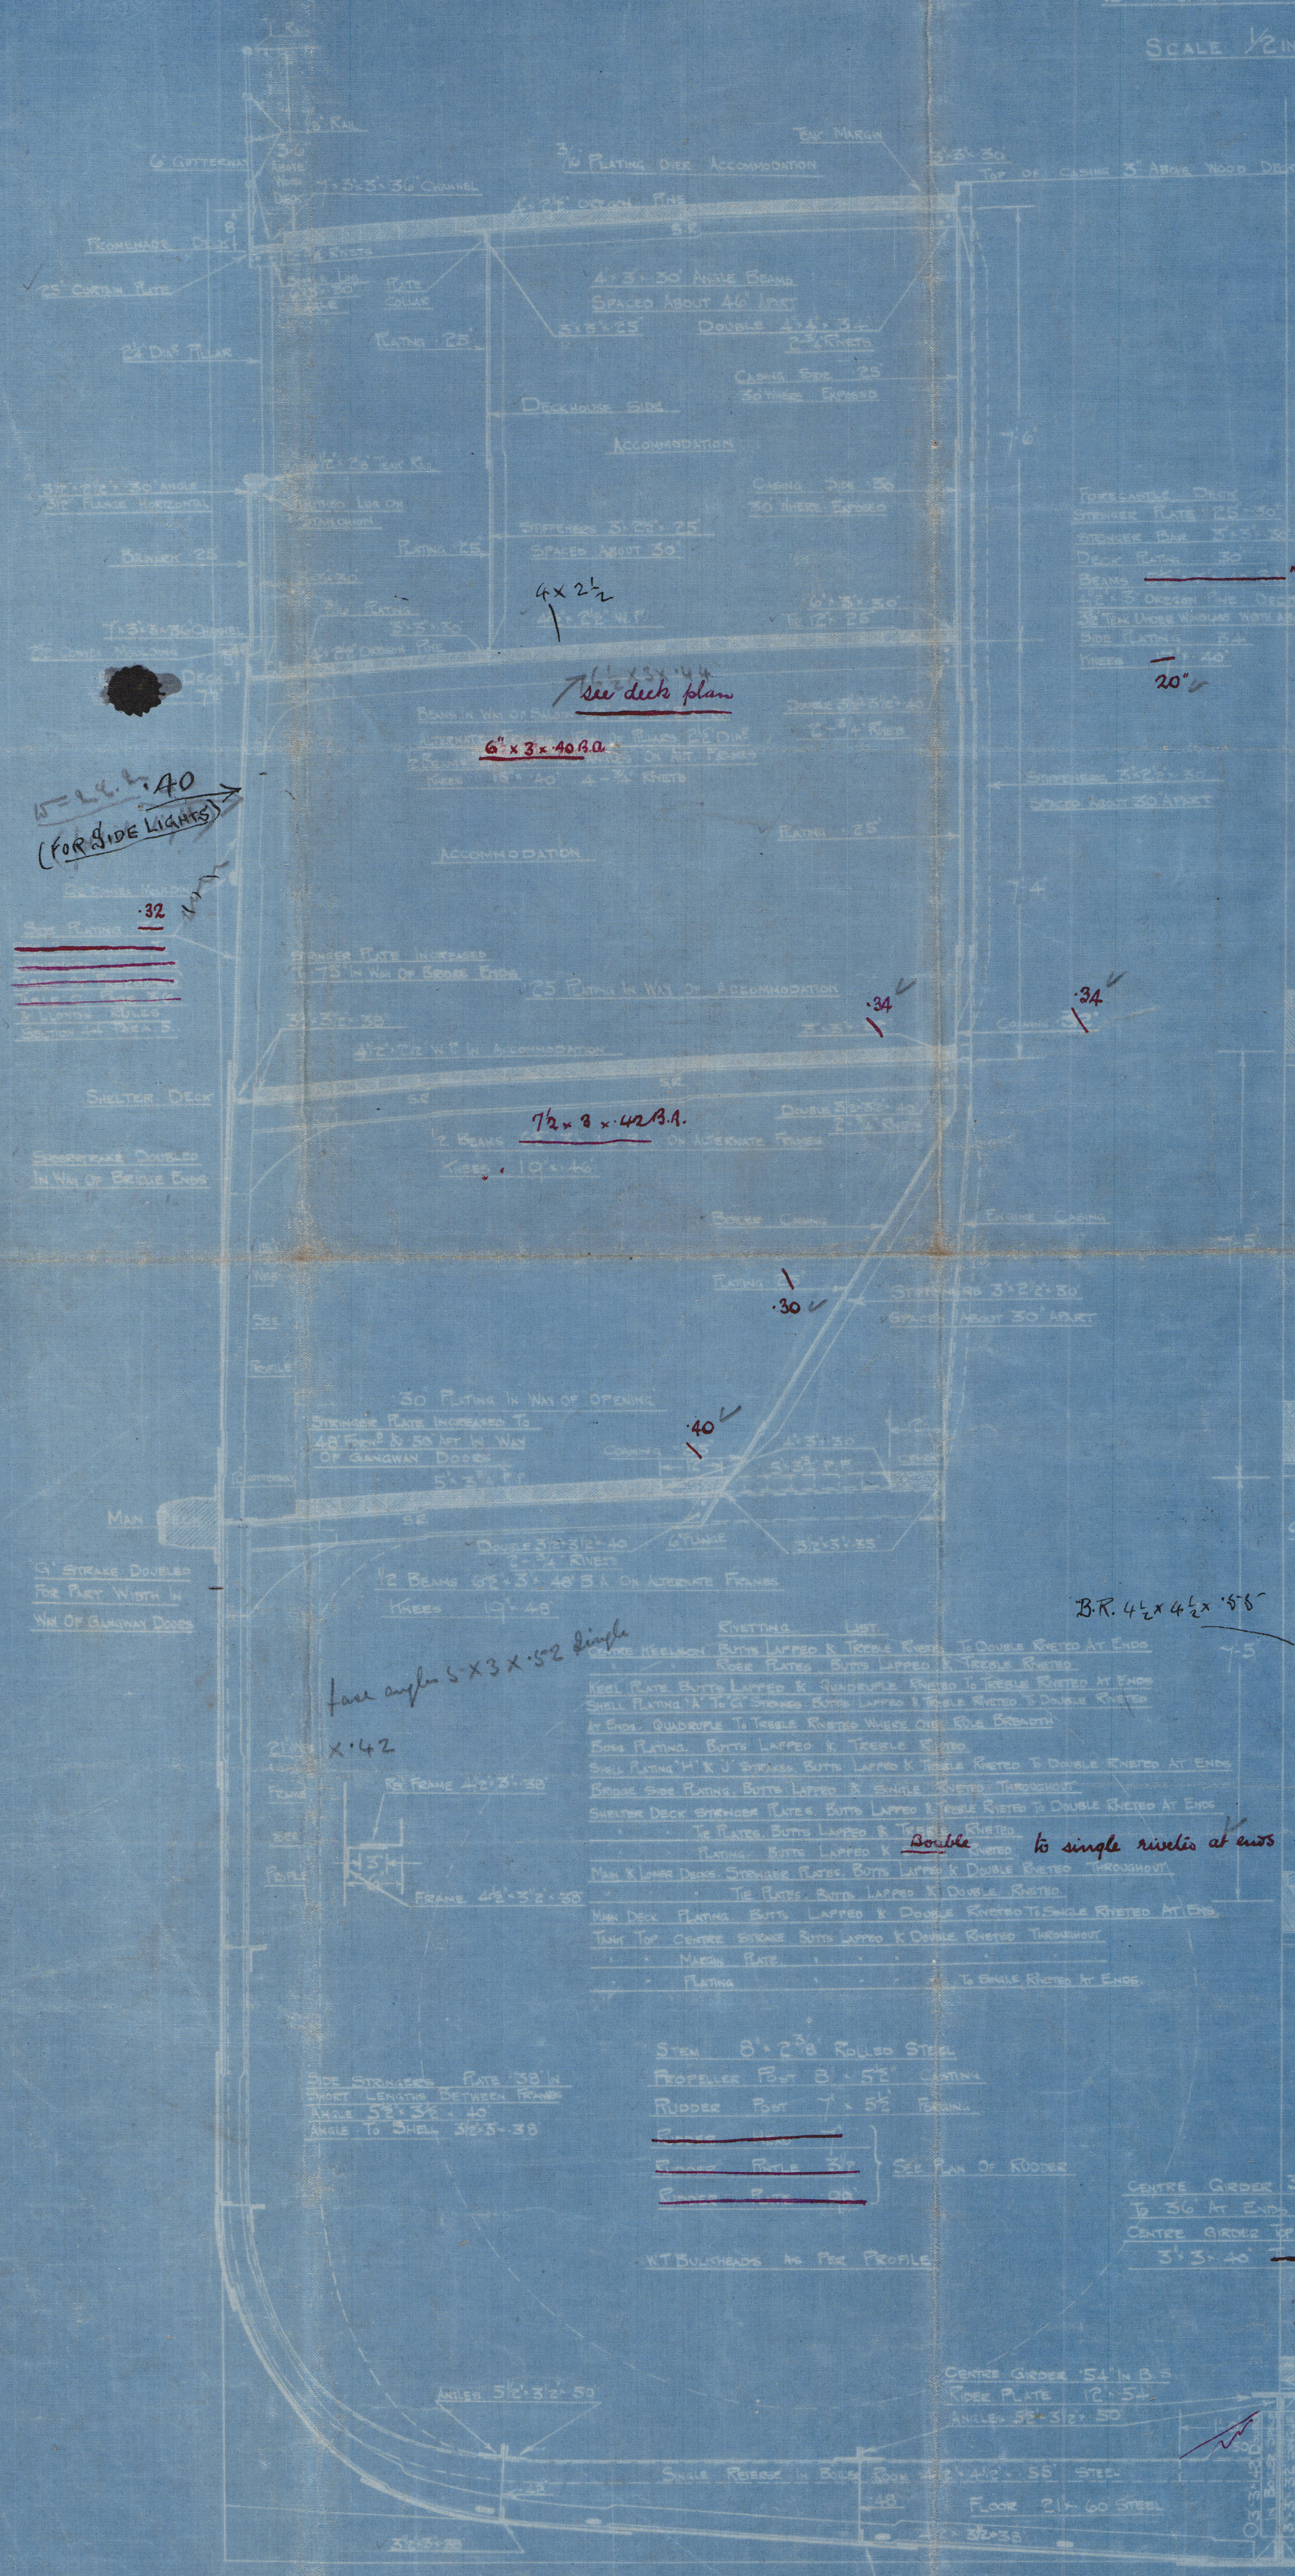

See 49 to be complied with

20.7.19

Andrusan Co.

Nos 278 & 308

Friendship Letter



No 308. GLASGOW REPORT No 41045

J. Andmore

No. 278 - S.S. "Lennax"

GLASGOW REPORT No 41518


Lairdskill



© 2021

Lloyd's Register
Foundation

003572-003580-0199

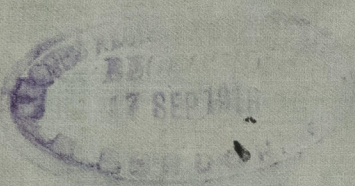

003572-003580-0199



© 2021

Lloyd's Register
Foundation