


EQUIPMENT
1 BOWER ANCHOR - 12 CHTS. STOCKLESS
1 BOWER ANCHOR - 11 " " "
1 KEDGE 4 1/2 " EX. STOCK
150 FATHOMS 1 1/4" STUD CHAIN CABLE
60 FATHOMS 6" MANILLA HANSEL
60 " 6" " WARPES

NUMERALS
LONGITUDINAL NUMBER L x D = 2736
DEPTH "D" = 16.0
EQUIPMENT NUMBER L x (B + D) = 7609.5

PROFILE & MIDSHIP SECTION.
OF A
STEEL SCREEN TRAWLER

DIMENSIONS - 171'-0" BP x 28'-6" B³ MLD x 16'-0" D³ MLD
TO CLASS 100 A.1 LLOYDS STEAM TRAWLER


SCALE - PROFILE 1/4" = 1 FT
SECTION 3/8" = 1 FT

 

SMITH'S DOCK CO. LTD.
SUPERVISORS & ENGINEERS
SOUTH BANK - M. T. BBS

SHIP NOS. 1026 & 1027


003581-003590-0001

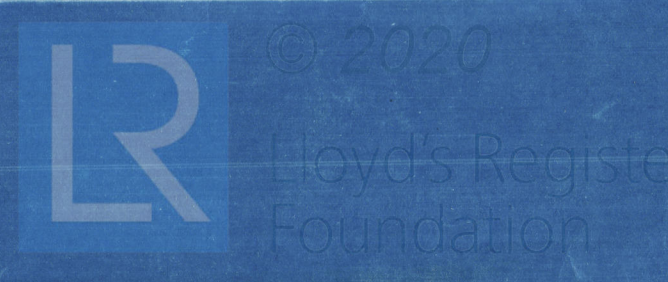

RETAIN

SMITH'S DOCK CO. LTD

No 1026-7.


1026 "LOCH OSKAIG" 

MDR. RPT. NO.

S.S.

MIDSHIP SECTION & PROFILE

AS BUILT.



15997

003581-003590-0001



© 2020

Lloyd's Register
Foundation