

880

EQUIPMENT.

- 1 BOWER ANCHOR - 11 1/2 CWT. STOCKLESS.
- 1 BOWER ANCHOR - 10 1/4 " "
- 1 KEEDGE - 4 " " EX. STOCK.
- 150 FATHOMS 1 1/4" STUD CHAIN CABLE.
- 60 FATHOMS 6" MANILLA HANSE.
- 60 " 5 1/2 " " WARPS.

NUMERALS.


LONGITUDINAL NUMBER L x D = 2658 x 15.75  
DEPTH "D" = 15.75  
EQUIPMENT NUMBER L x (B+D) = 7385 x 7.42

PROFILE & MIDSHIP SECTION  
OF A  
STEEL SCREW TRAWLER.

DIMENSIONS: 168'-9" B.P. x 28'-0" B.T. M.O. x 15'-9" O.T. M.O.  
TO CLASS 100 A.I. LLOYDS STEAM TRAWLER.

SCALES: PROFILE 1/4" = 1'-0"  
SECTION 1/2" = 1'-0"

16-0 per 1/4" entry  
no effort on  
seamling or  
equipment

 

SOUTH DOCK CO. LTD.  
SHIPBUILDERS & ENGINEERS  
SOUTH BARN-ON-TEES

SHIPS NO 1003, 1004-5-6

003581-003590-0035



SMITH'S DOCK CO.

Nos 1003. 4. 5-6.


MIDSHIP SECTION PROFILE.

Loch Monteth

766

①

RETAIN

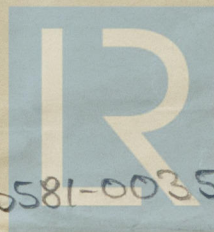

© 2020

Lloyd's Register  
Foundation

003581-003590-0035