
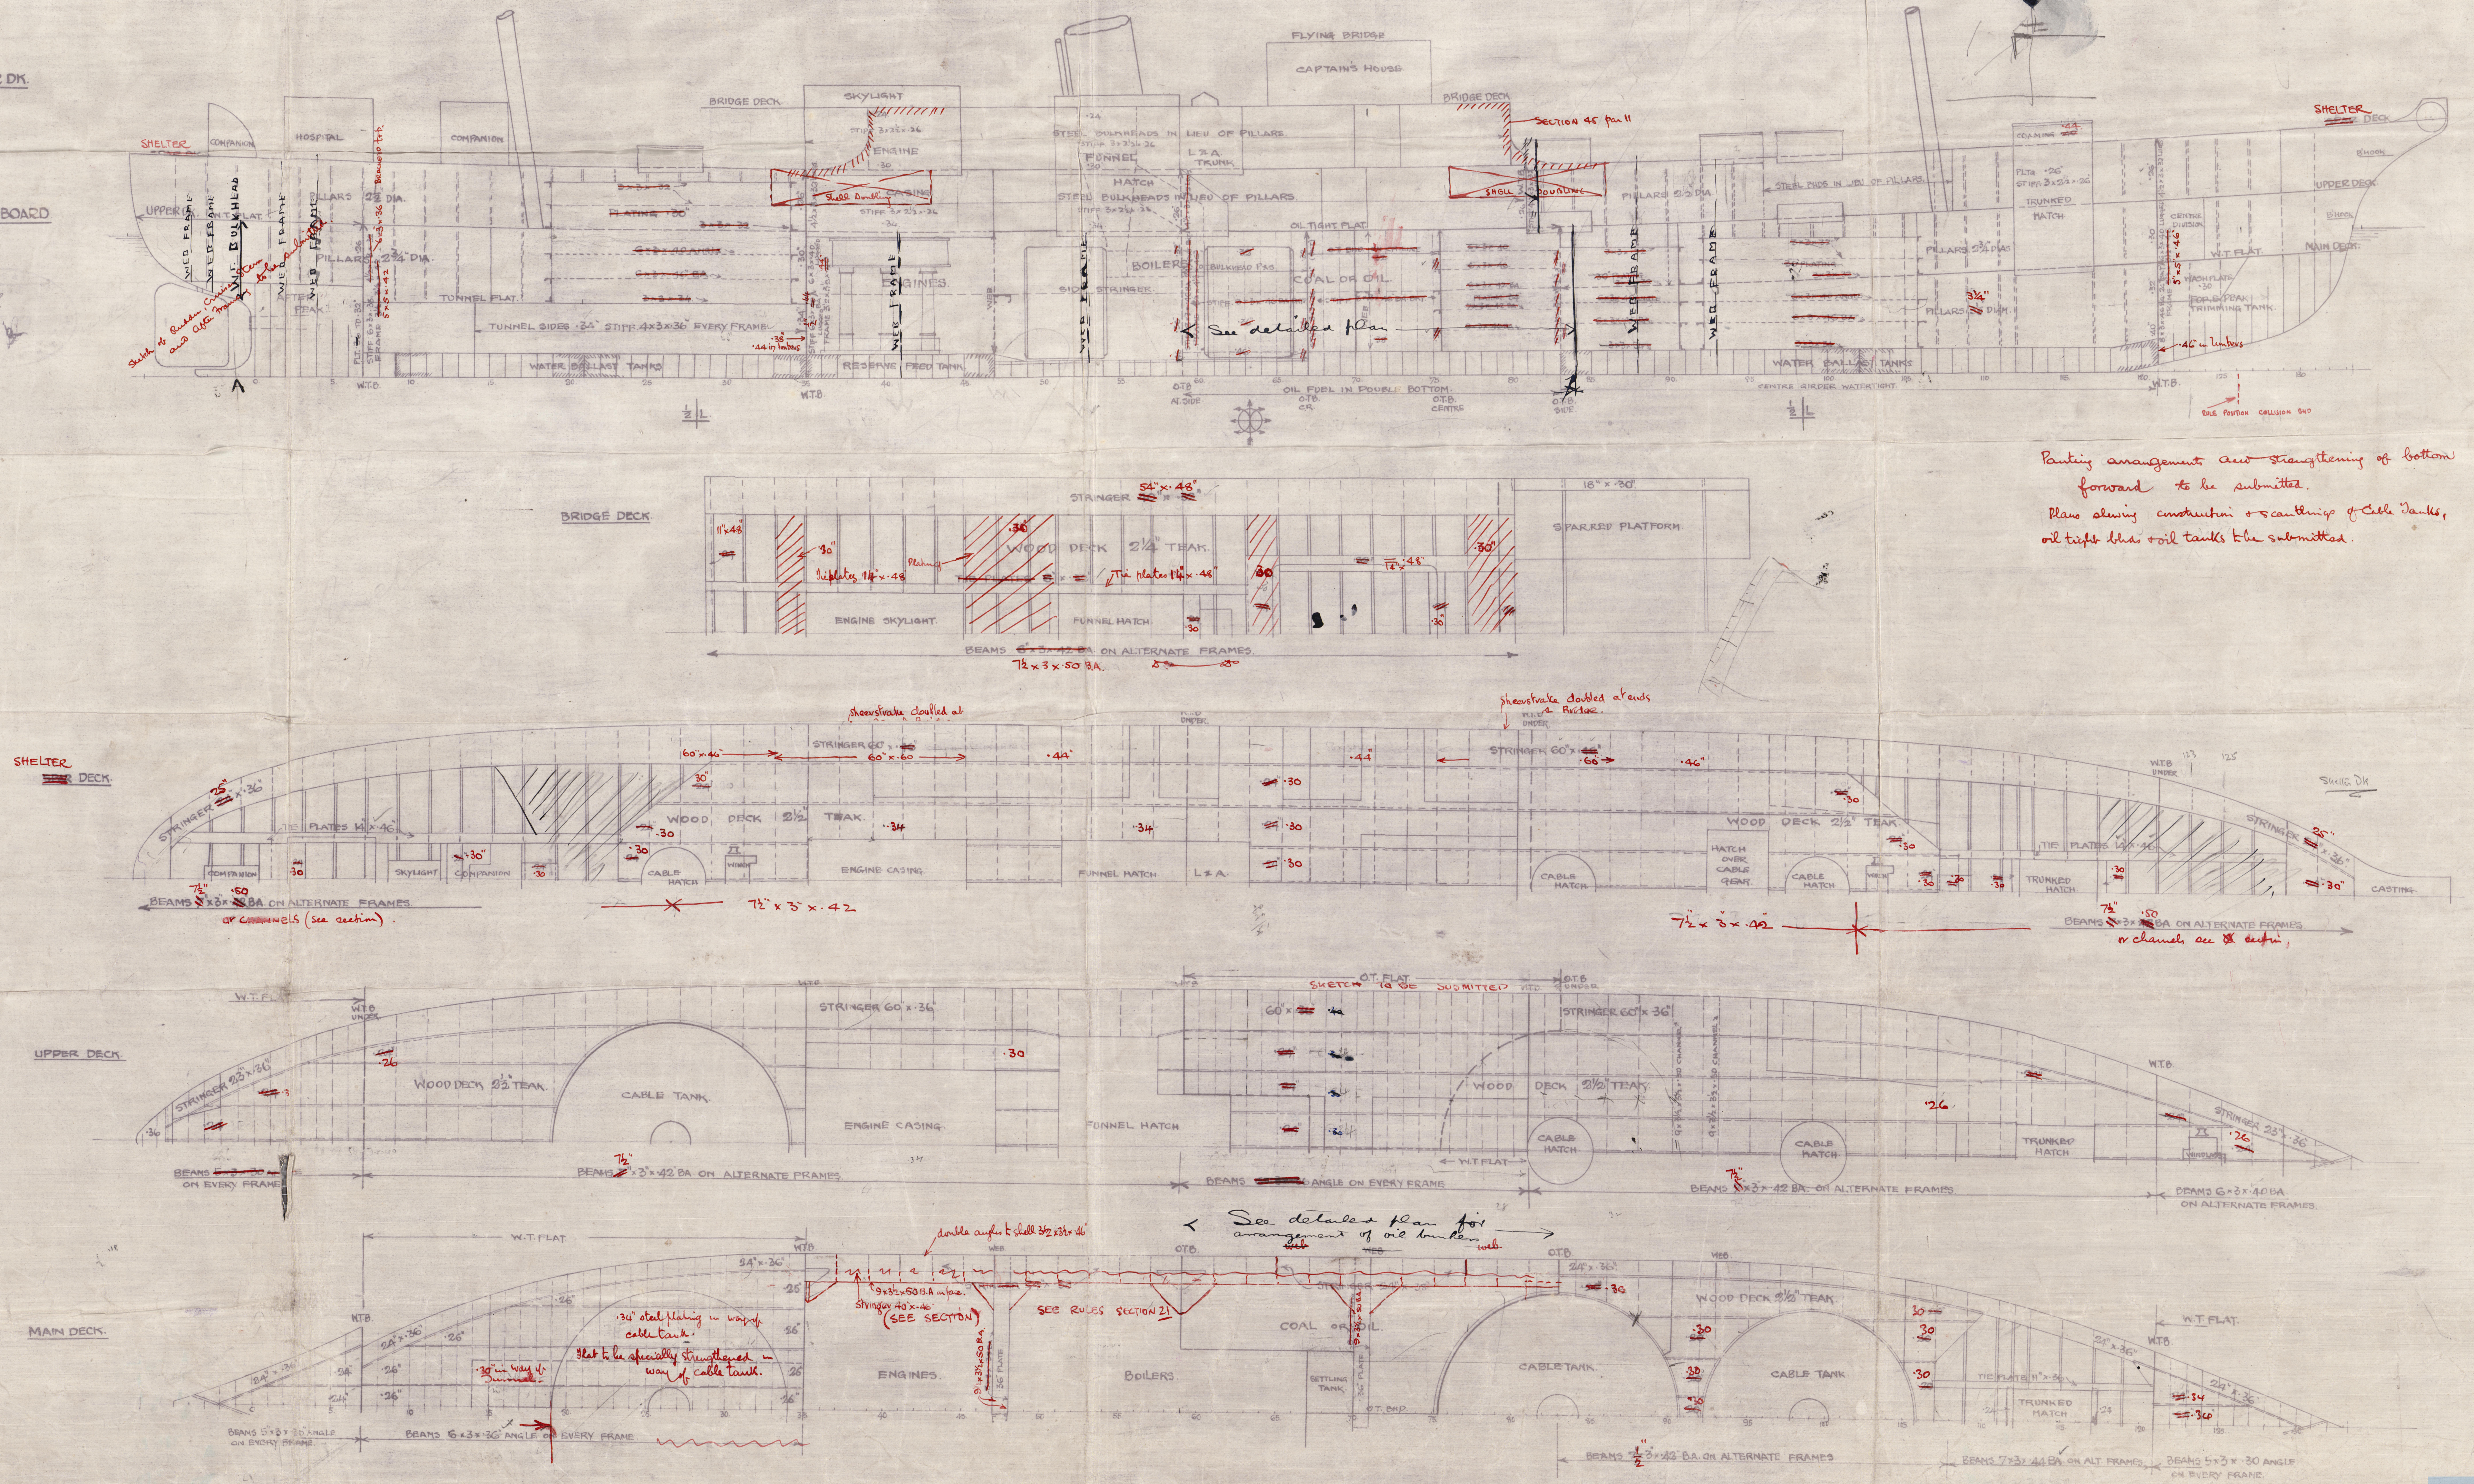


DIMS 269' ON LWL x 38' x 17'-6" MLD. TO UPPER DK.

SCALE $\frac{1}{8}" = \text{ONE FOOT.}$

CLASS 100 A1 LLOYDS SHELTER ~~DECK~~ DECK WITH FREEBOARD

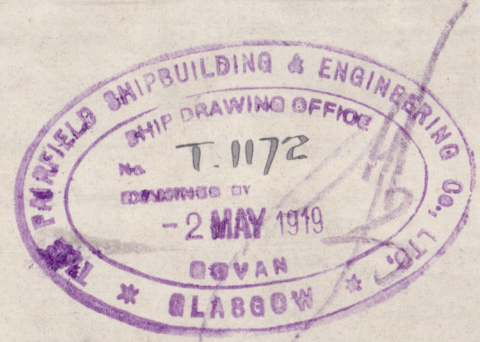

Plans showing construction & scantlings of Cable Tanks,
oil tight bins & oil tanks to be submitted.

661.
17.5.19.

003581-003590-0206


Profile & Deck Plans


GSS m 597

Lady Denison Pender

GLASGOW REPORT No. 40414

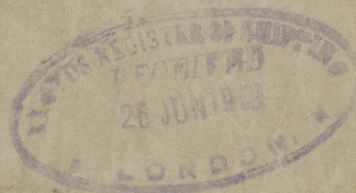

003581-003590-0206



© 2020

Lloyd's Register
Foundation