


BKTS IN LINE WITH SHELL & DECK LONGITUDINALS
ALL BULB ANGLES N.B.S.

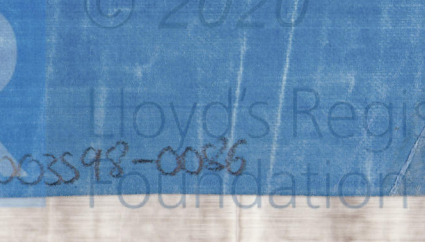

BLYTHSWOOD S.B.C^o LTD

N^o 31.

PROFILE AND DECK PLANS.

(APPROVED)

Imperial Transport
GLASGOW REPORT No 5 1267
(Fbd)

GLASGOW REPORT No. 51756



© 2020

Lloyd's Register
Foundation

003591-003598-0086