



19.10.29

RUDDER FRAME - FORGED IRON.

Nº 912

RUDDER: 7/8 DIA. RIVETS SPACED 5 DIA. APART (NEEDED) IN RUBBER ARMS  
1" ~~X~~ DIA. TAP RIVETS TO BE SUBSTITUTED (SPACED AS ABOVE)  
THE THICKNESS OF ARM EXCEEDS 1"  
RUDDER PLATES TO BE TAPPED TO RUDDER POST BY ~~X~~ TAP  
SPACED 6" CB TO CB  
7/8 DIA. RIVETS IN PACKING FRAME SPACED 5 DIA. APART  
RIVET HOLES IN RUBBER PLATES TO BE COUNTERBORN

TOTAL AREA OF RUDDER = 125 SQ. FT.  
C.G. OF AREA ABAFT & OF POST = 137 FT.  
SPEED = 11 KNOTS.

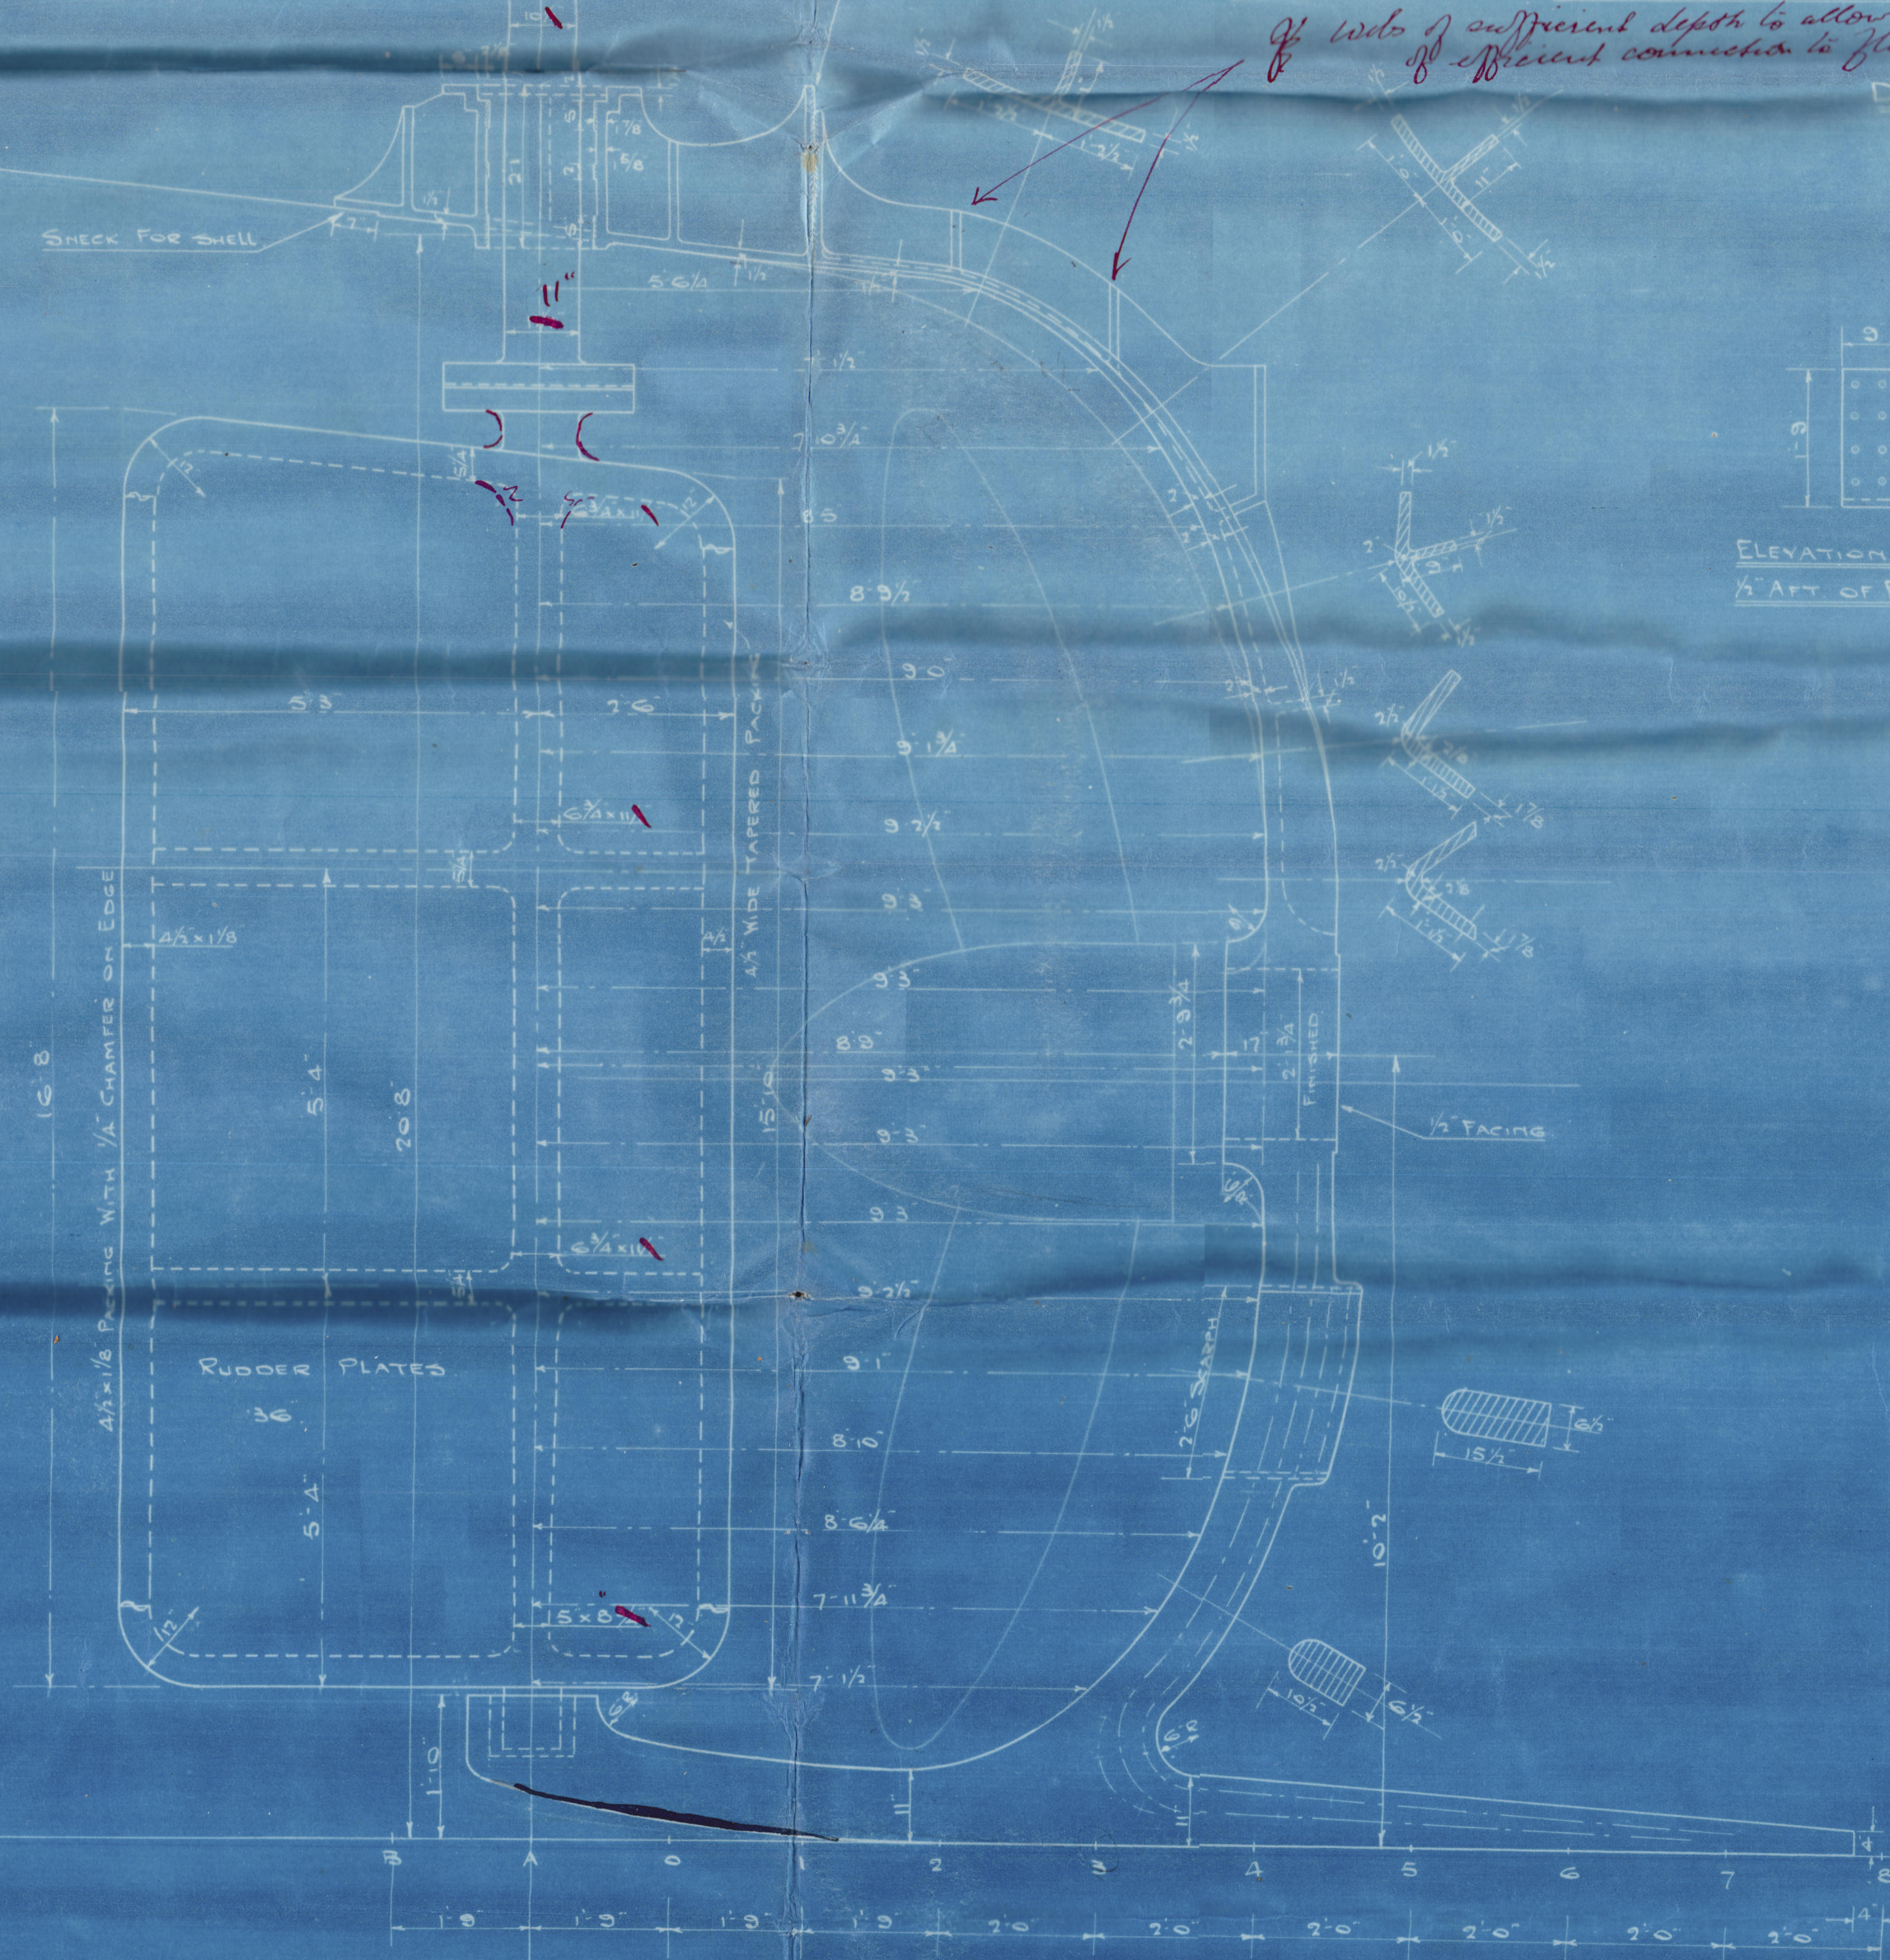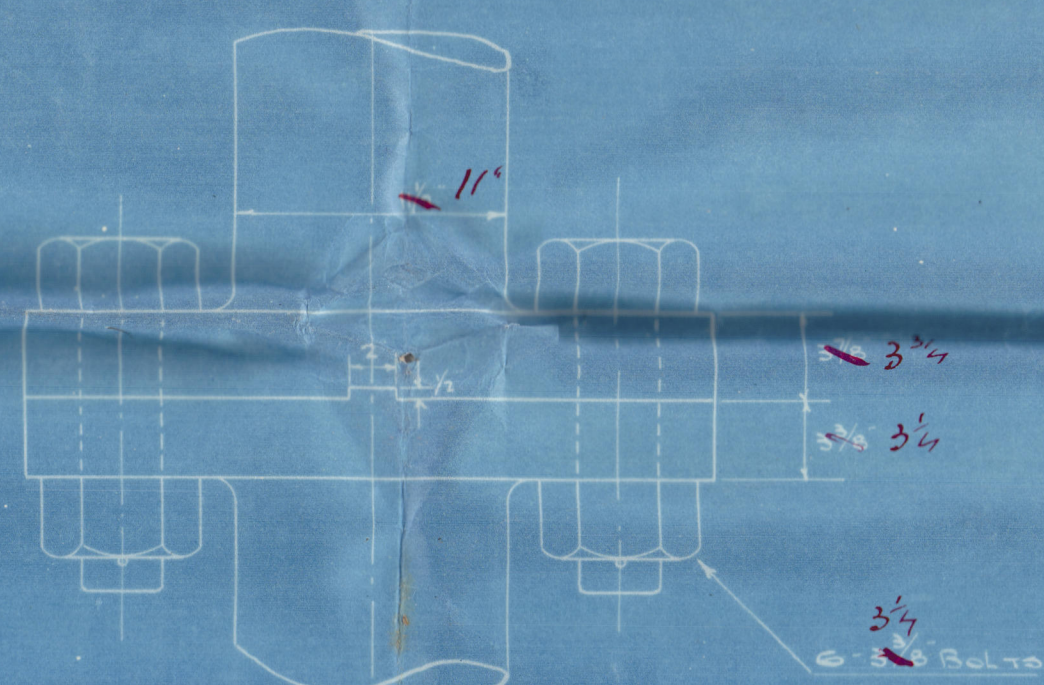



STERN FRAME + RUDDER

Nº 912

S.S. Port Alfred.  
MDB. RPT. Nº 14103

" Roy



© 2020

Lloyd's Register  
Foundation

003591-003598-0110