

S.S. No 415. LONGITUDINAL SECTION-DECK PLANS.

SCALE - 1/8" = 1 FOOT.







DIMENSIONS - 246'-0" B.P. x 36'-0" B.M. x 17'-0" D.M. ^{TOUR DE}
TO CLASS B.S. * BRITISH CORPORATION. LOAD DRAFT 15'-9" M.D.

LOA - 242 + 11.3 + 14.2
= 257.5

14 OCT 1929

HATCH SECTIONS.

SCALE - 1/2" = 1 FOOT.

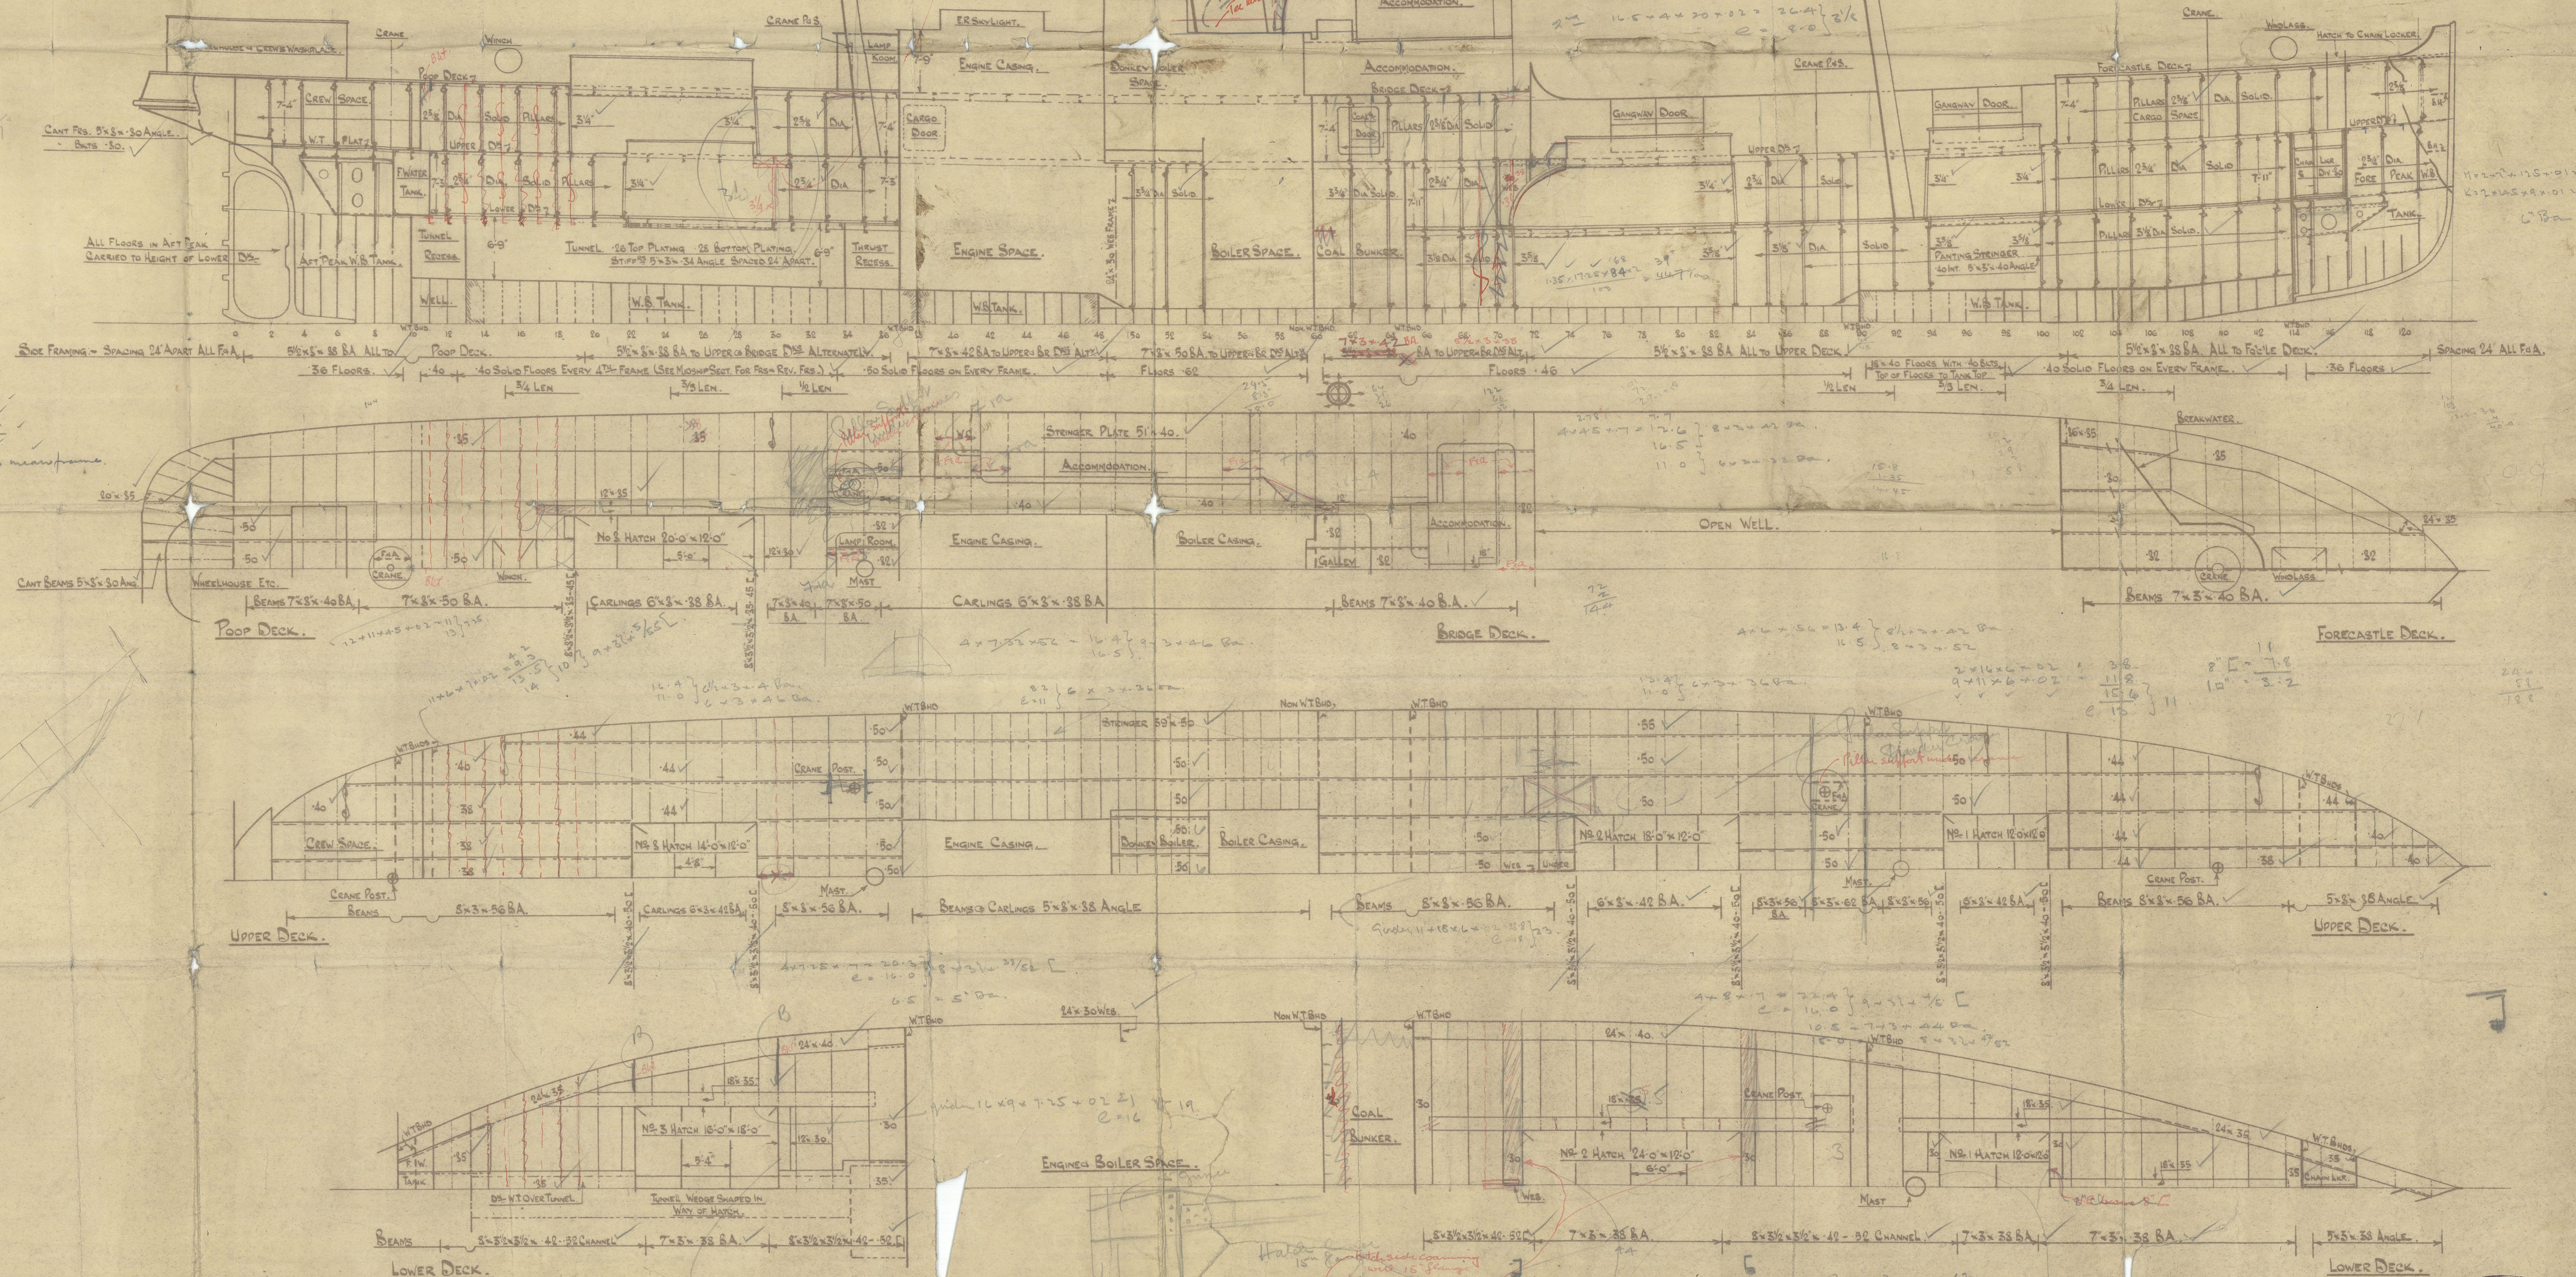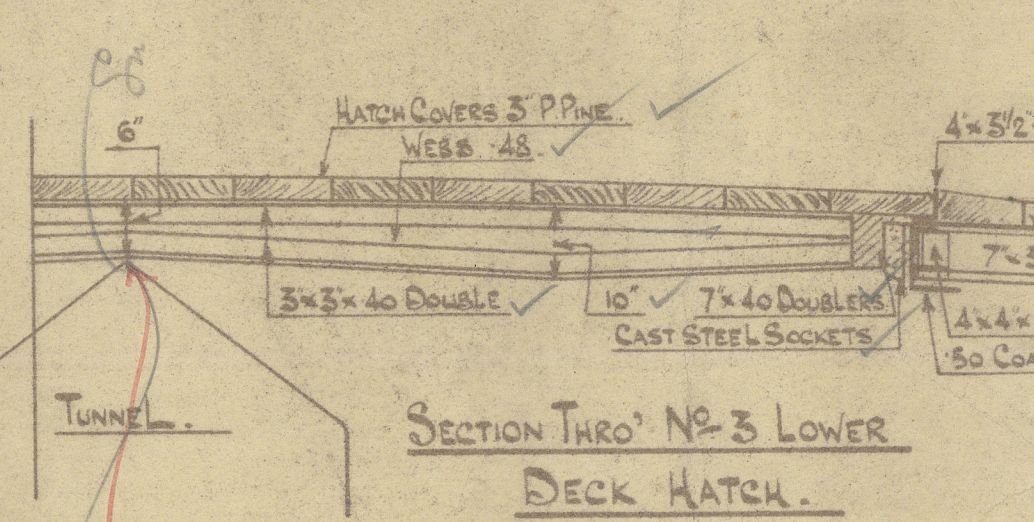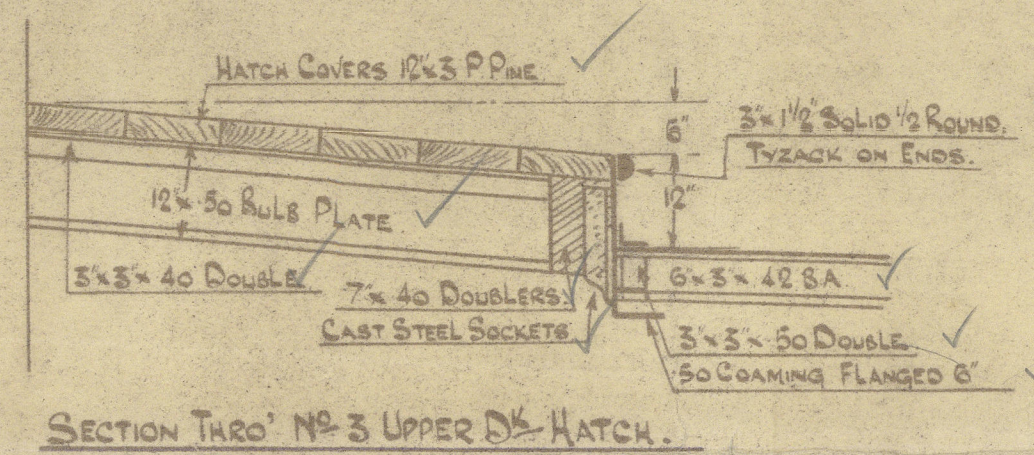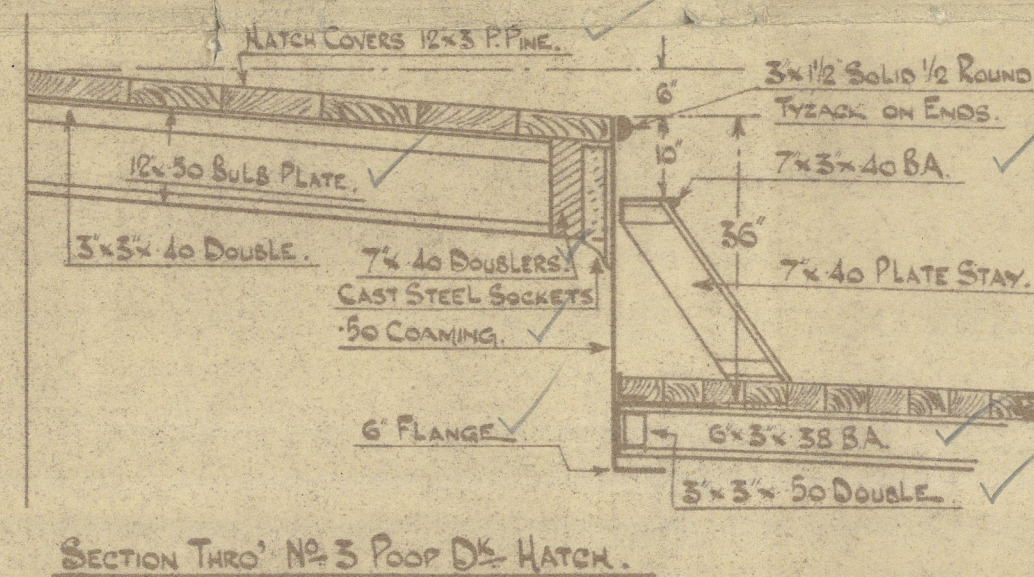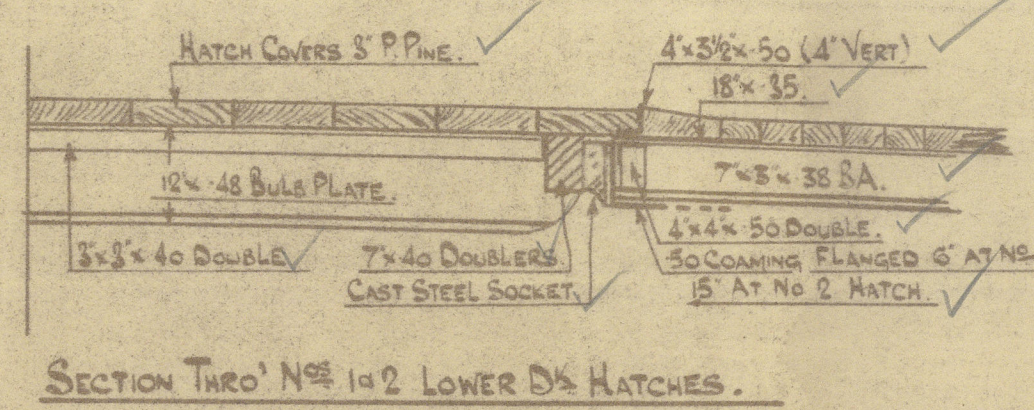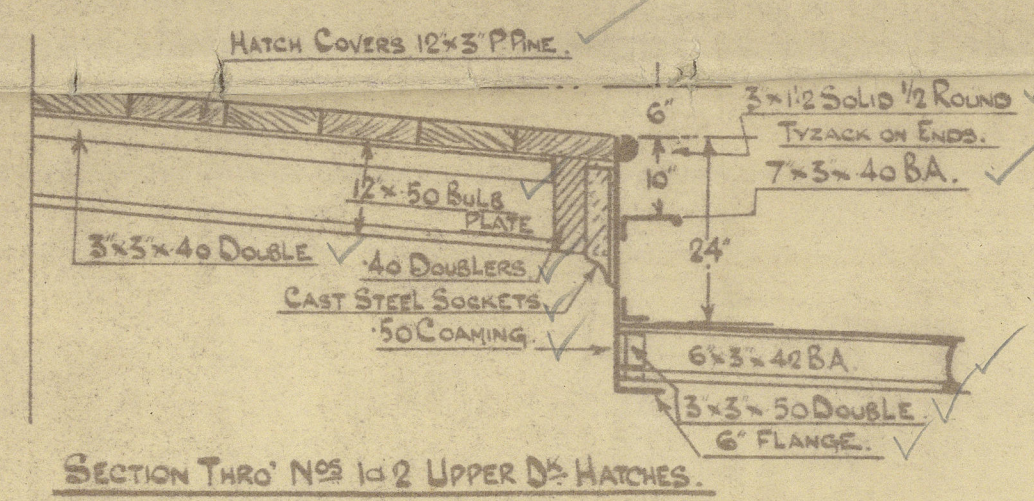

Approved [Signature]

2

Profile & Deck
Hilse S. B. Co.

No. 415.

S. B. 27/11/29.

16-10-29.

5/6 ORCHY



© 2020

Lloyd's Register
Foundation

003599-003604-0136