


Lloyd's Register of Shipping.

Ship's Name VEST EX CALEB

Official No. _____

Memorandum of alterations reported since ship was surveyed for assignment of Load Lines in _____

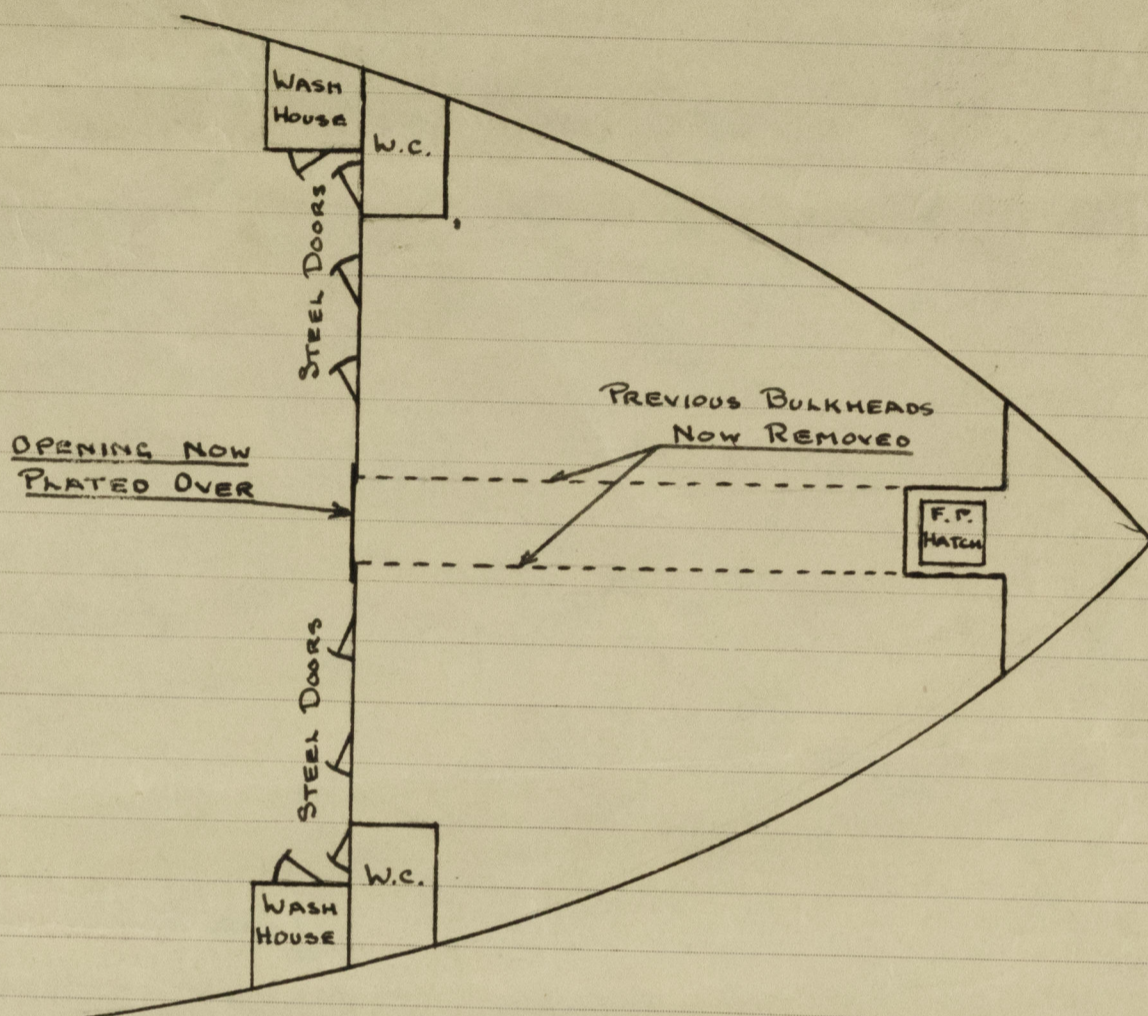

Fore-castle accommodation now enlarged to suit Norwegian Government regulations. Bulkheads of alleyway in fore-castle now removed and opening in fore-castle bulkhead plated over.

Noted for J. J. Hendace

- 8 MAY 1939



© 2020

Lloyd's Register
Foundation