

— N° 253 — **FORGINGS PLAN**

— SCALE $\frac{3}{4}$ = 1 FOOT —

TO LLOYD'S TESTS & REQUIREMENTS & INSPECTION



A x D = 4' 4" x 1' 8" 98 5-6 82-13

SPEED UNDER 10 KNOTS

RIVETS IN RUDDER ARMS 1" DIA SPACED 4 1/2" APART C^R 10 C^R

RIVETS IN STERNFRAME 1/2" DIA SPACED 4 1/2" APART C^R 10 C^R


— RUDDER ARMS —

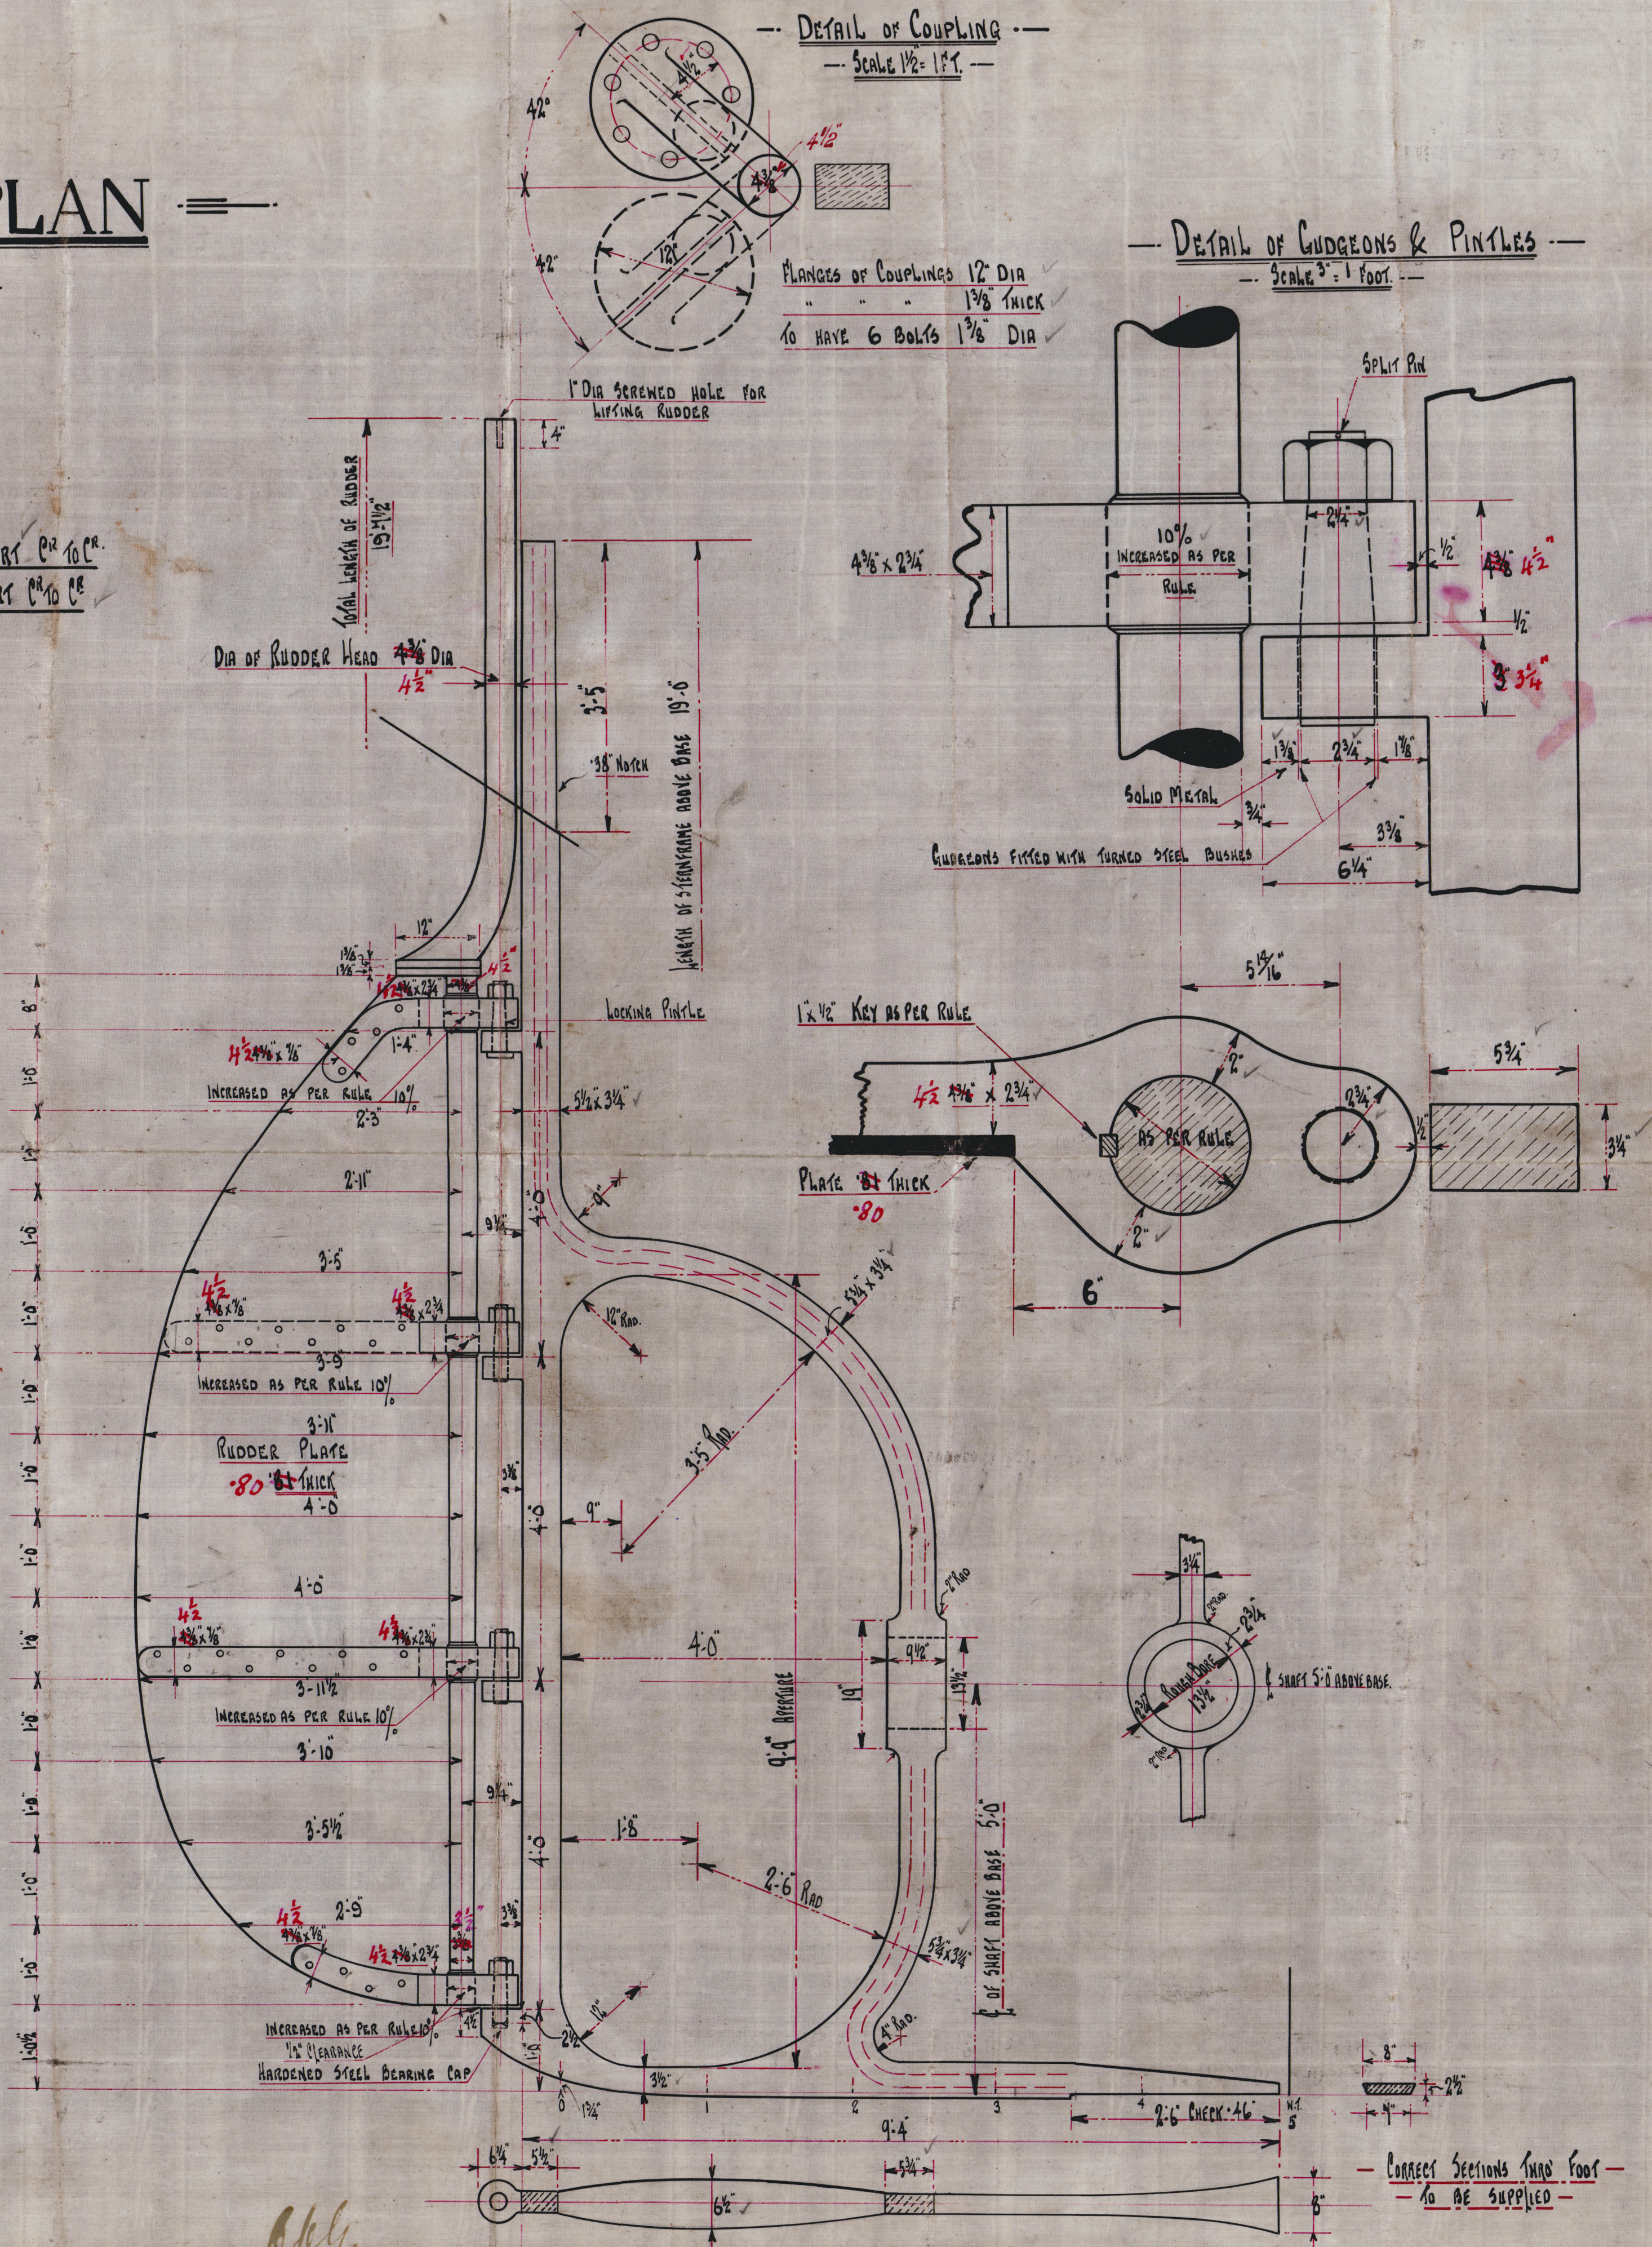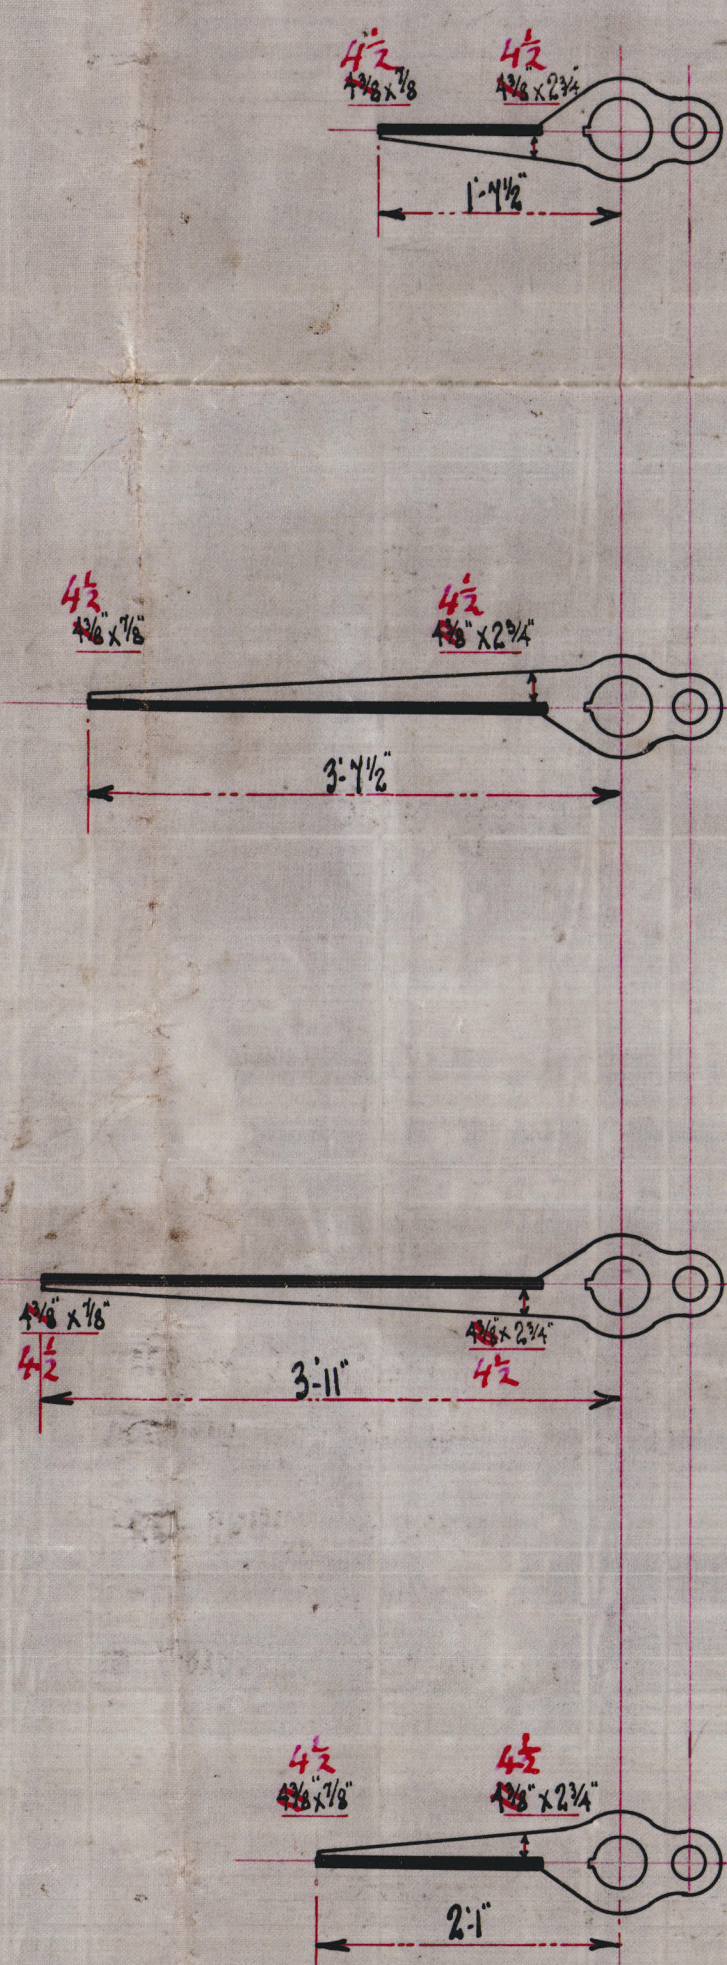

OK
 26-1-23

— CORRECT SECTIONS INTO FOOT —
 — NO RE SUPPLIED —

— GOOLE SHIPBUILDING & REPAIR CO LTD —
 — VICTORIA SHIPYARD —

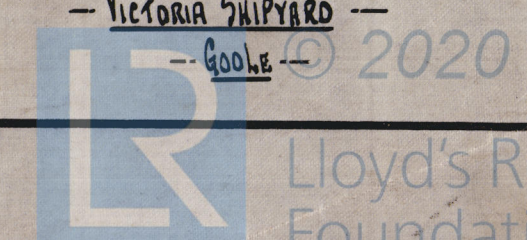

003805 003610-0153

Gooker S B & R. Co
No 253.

Stern frame and rudder.
w/s Glynconwy
Hull Rph No 35/125

82-1-25



© 2020

Lloyd's Register
Foundation

003605-003610-0153